
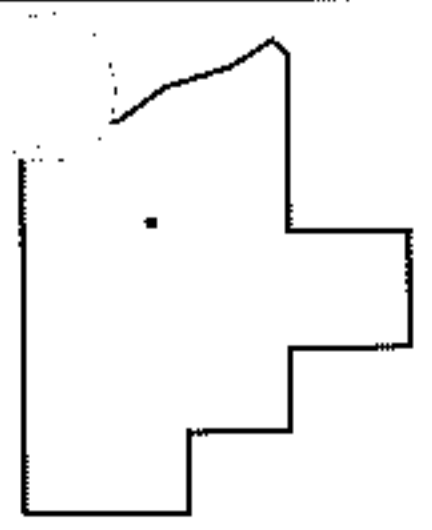
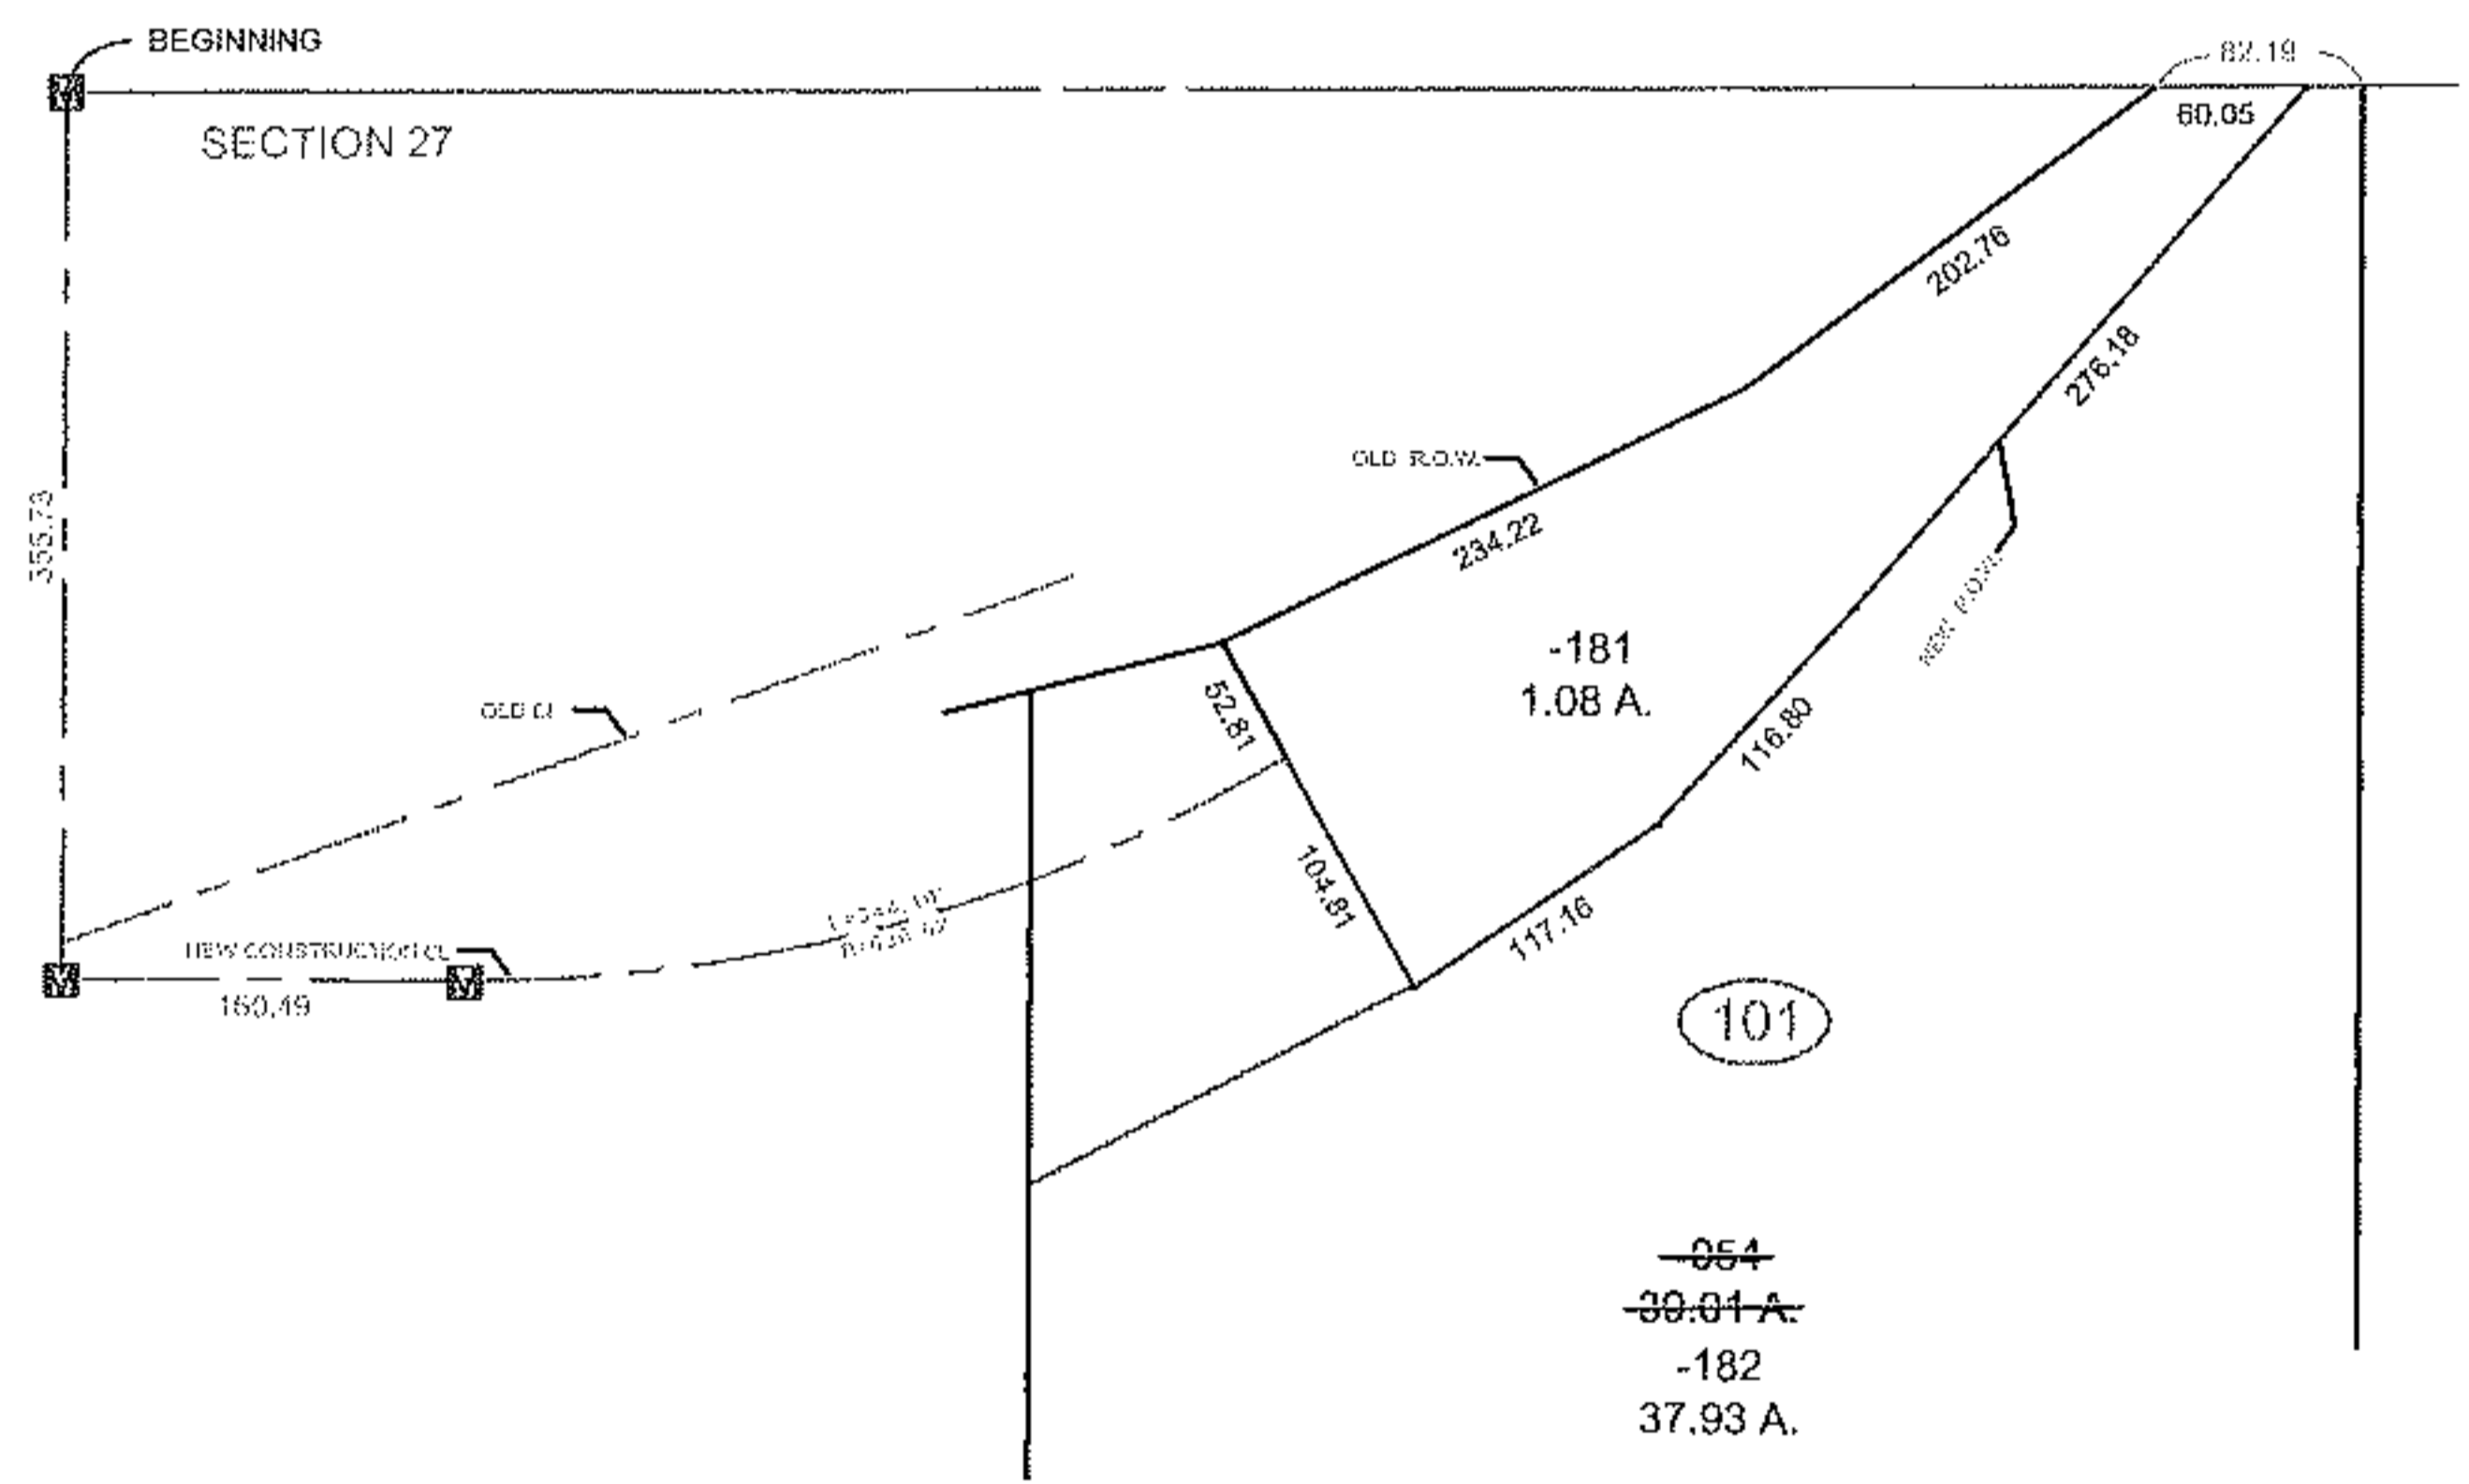


RASTER

PARENT PARCEL: 04-00-027-101-054  
CHILD PARCEL: 04-00-027-101-181 & -182  
STARTING POINT: N.W. CORNER OF SECTION 27

12-00246

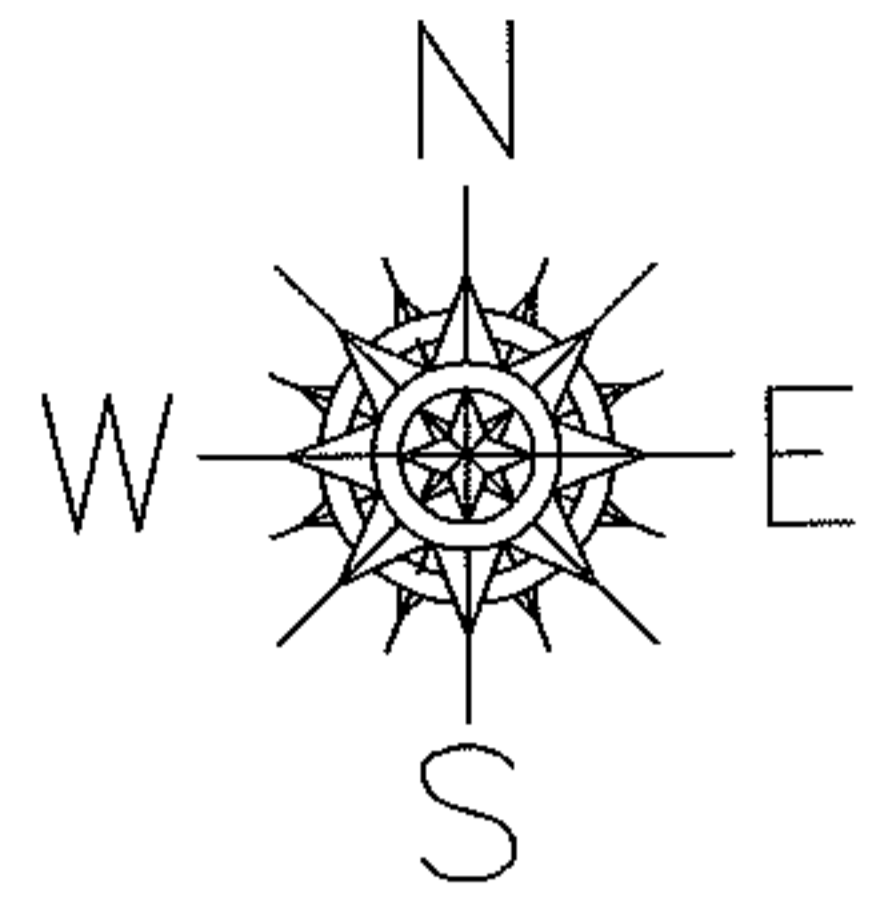

**SPLITS/DEEDS PROCESSED**  
LORAIN COUNTY TAX MAP DEPARTMENT  
226 MIDDLE AVE. ELYRIA, OHIO

SURVEYED BY: WILLIAM J. SALA  
CLOSURE: 0.01 : 10,000  
MAP PAGE(S): 4-00-027-A  
APPROVED BY: TJS DATE: 1/17/12  
SCALE: 1" = 200 PRIOR INST.: 20050067928