

PARENT PARCEL: 02-02-010-000-016

CHILD PARCEL: <u>02-02-010-000-450, -451</u>

STARTING POINT: INTERSECTION OF C/L OF JAEGER RD. AND C/L OF CROSSING TRL.

12-00261

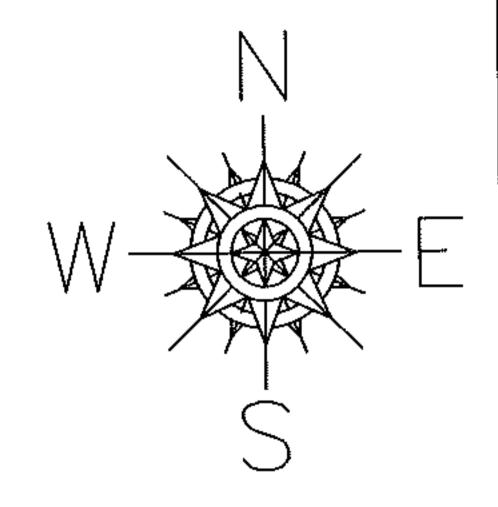

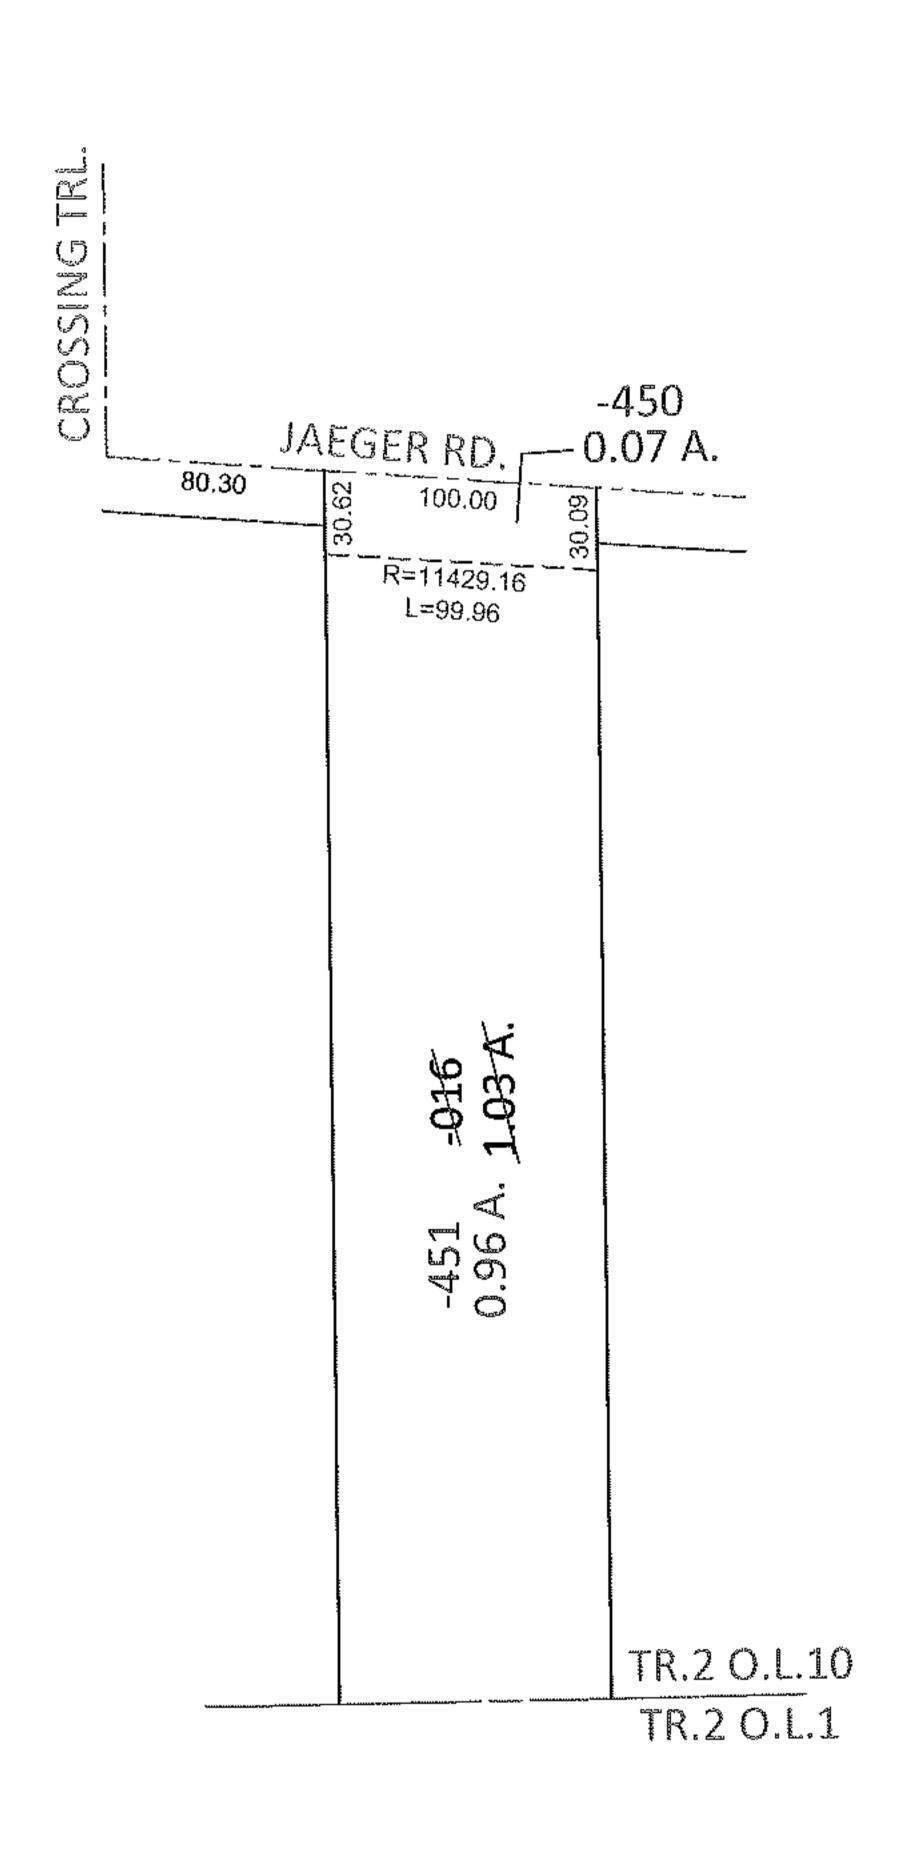

SPLITS/DEEDS PROCESSED

LORAIN COUNTY TAX MAP DEPARTMENT 226 MIDDLE AVE. ELYRIA, OHIO

SURVEYED BY: TREVOR A. BIXLER

CLOSURE: .00:10,000

MAP PAGE(S): <u>2-02-010-B</u>

APPROVED BY: RRM DATE: 5-1-12

SCALE: 1"= 100 PRIOR INST.: DV 1368/924