
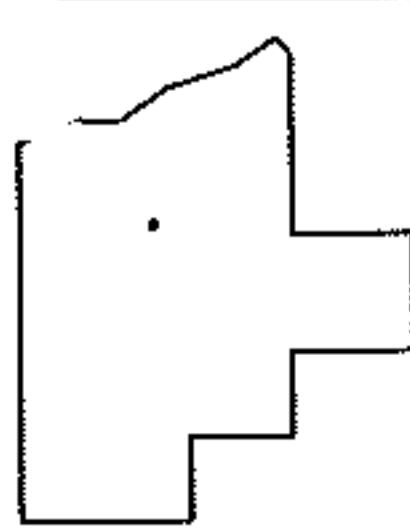
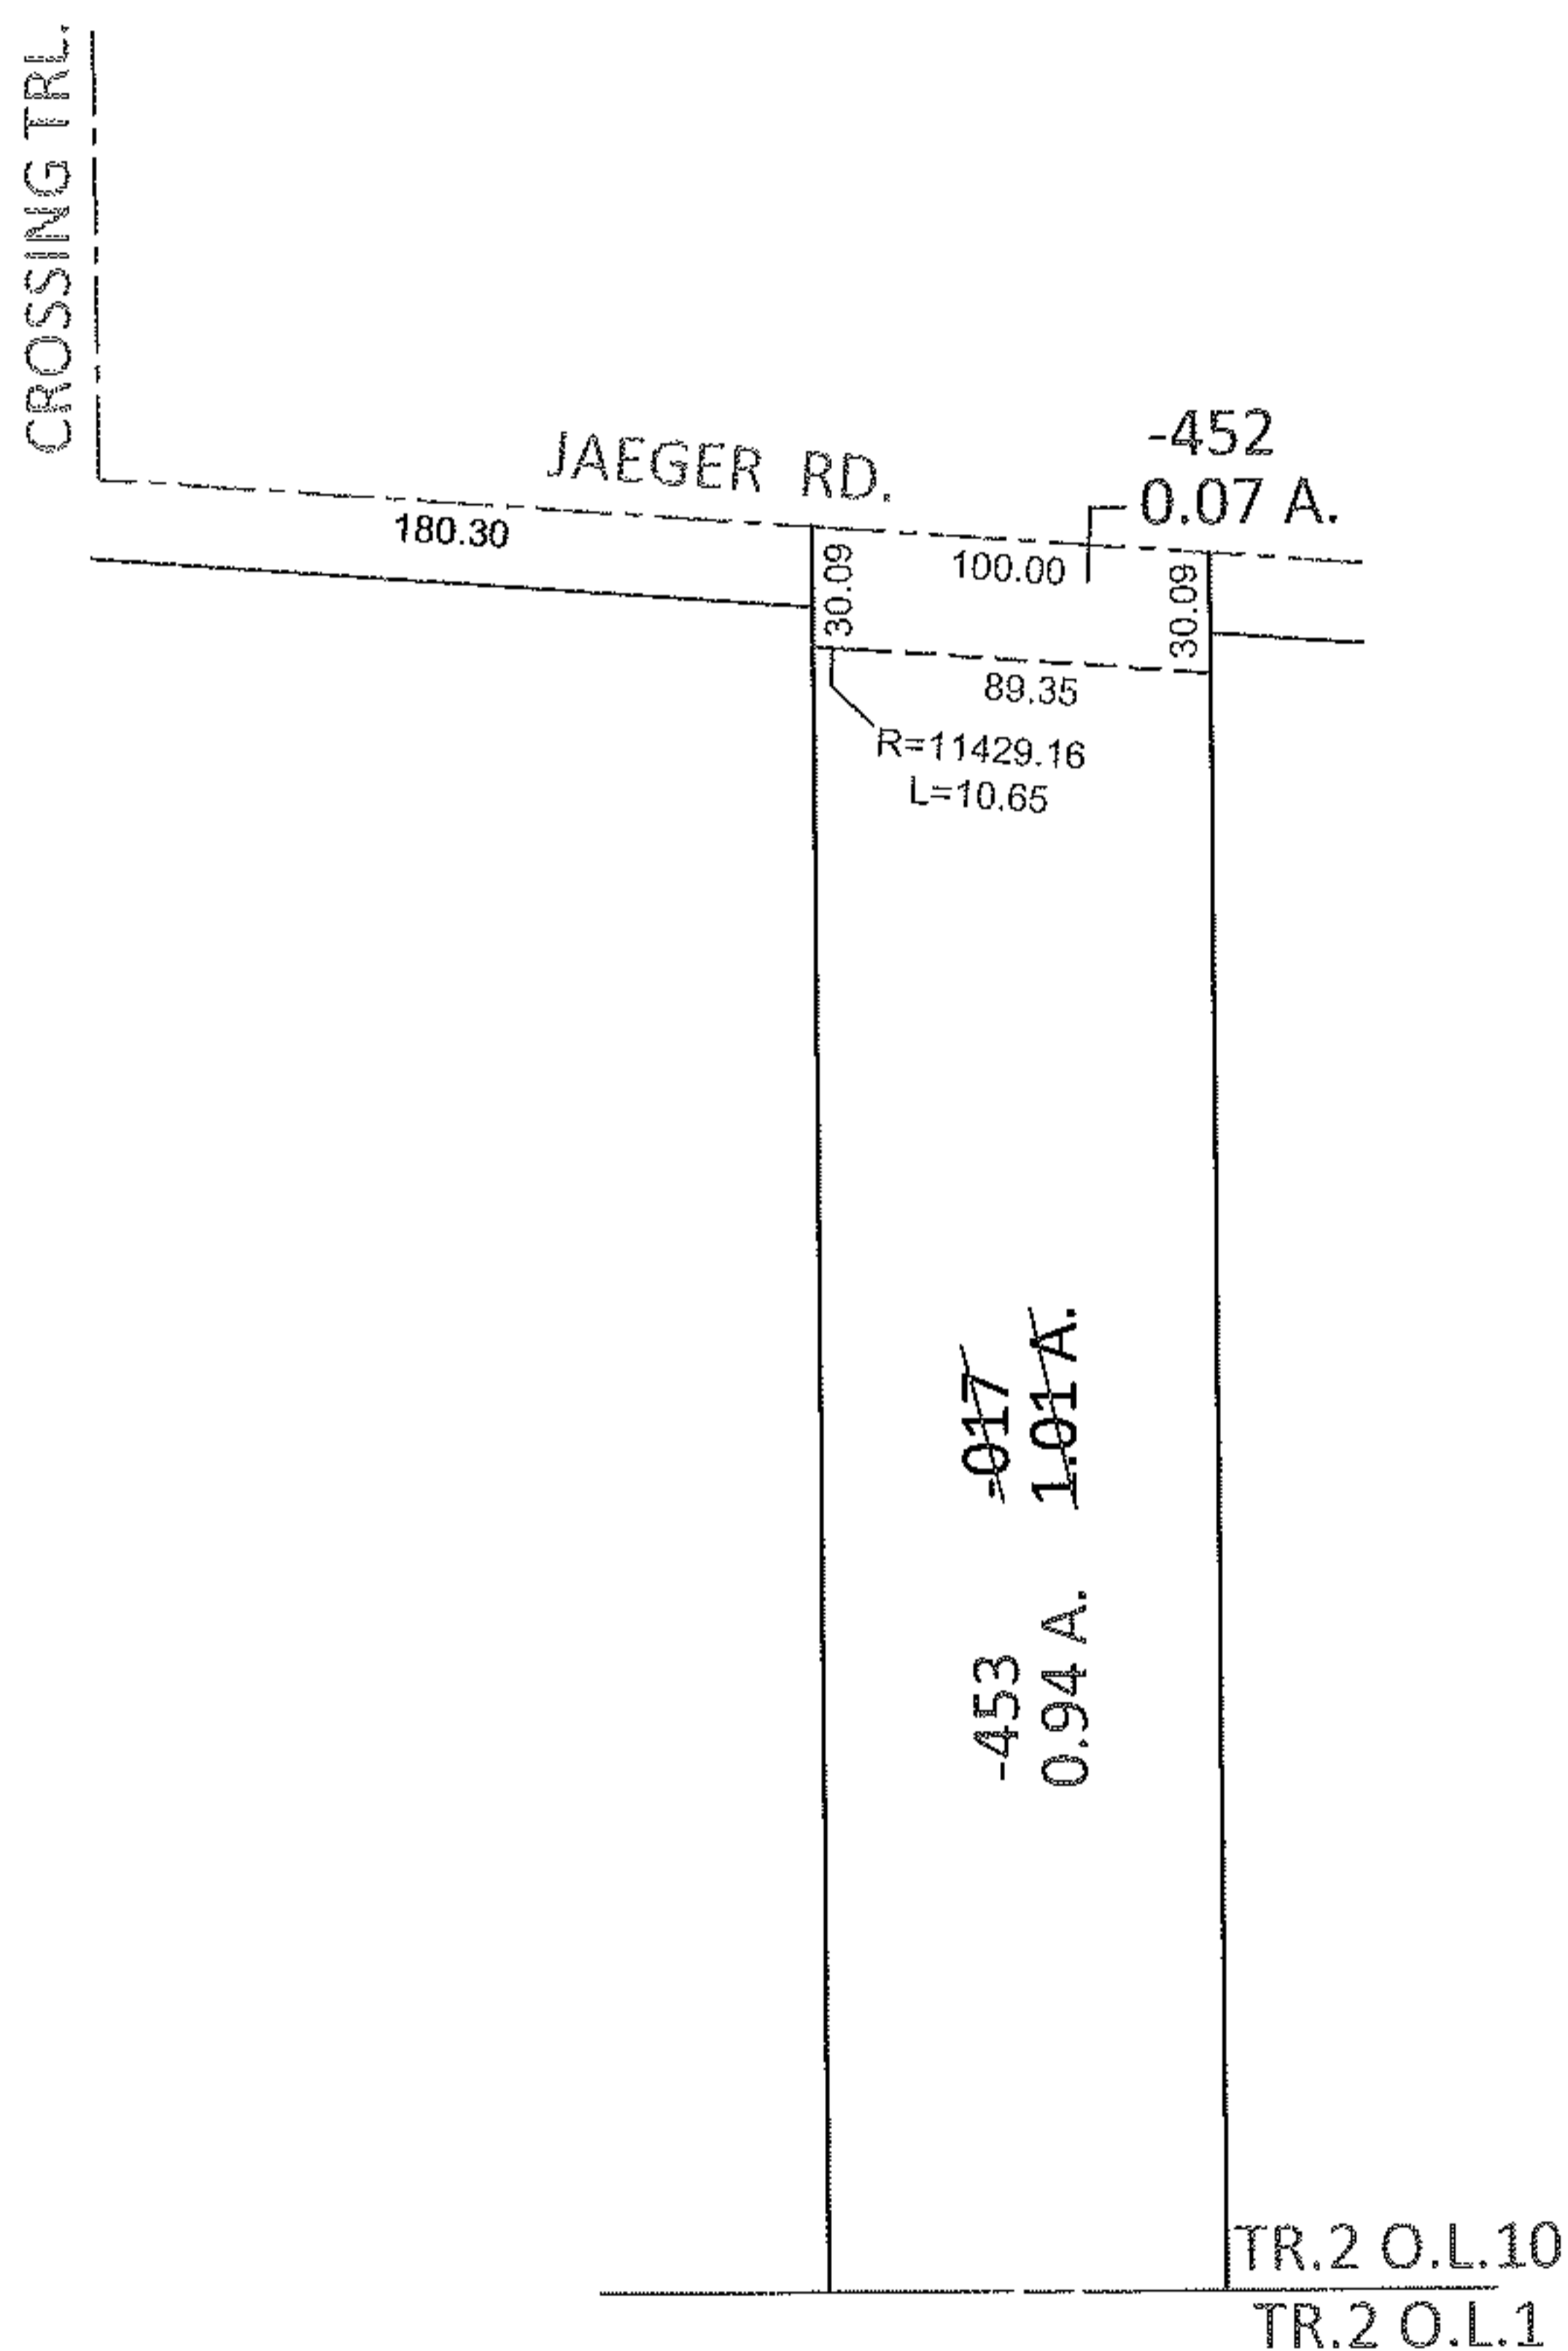


PARENT PARCEL: 02-02-010-000-017

CHILD PARCEL: 02-02-010-000-452, -453

STARTING POINT: INTERSECTION OF C/L OF JAEGER RD. AND C/L OF CROSSING TRL.

12-00262

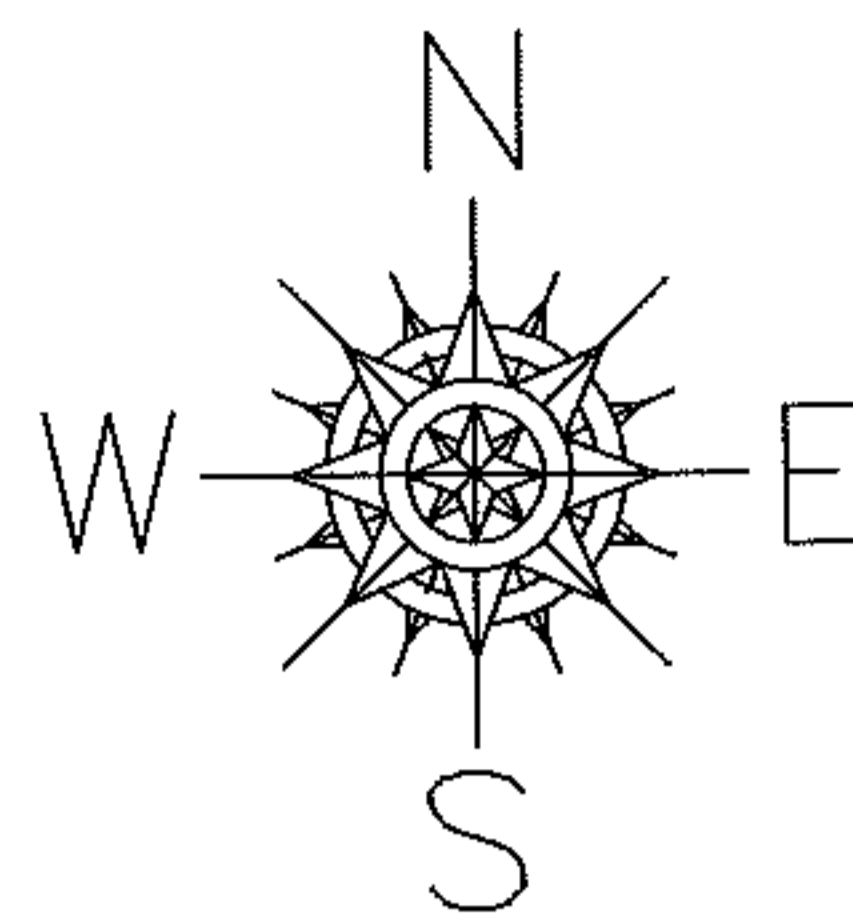

SPLITS/DEEDS PROCESSED

LORAIN COUNTY TAX MAP DEPARTMENT
226 MIDDLE AVE. ELYRIA, OHIO

SURVEYED BY: TREVOR A. BIXLER

CLOSURE: .00:10,000

MAP PAGE(S): 2-02-010-B

APPROVED BY: RRM DATE: 5-1-12

SCALE: 1"= 100 PRIOR INST.: DV 1363/147