
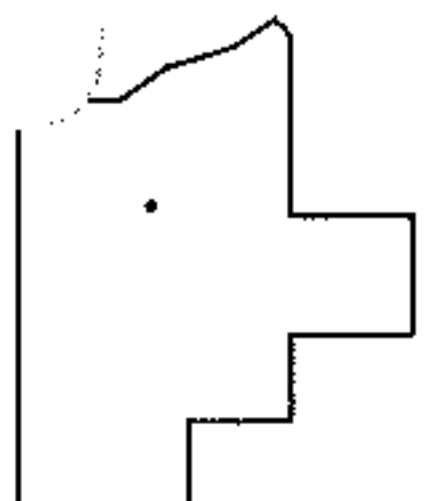
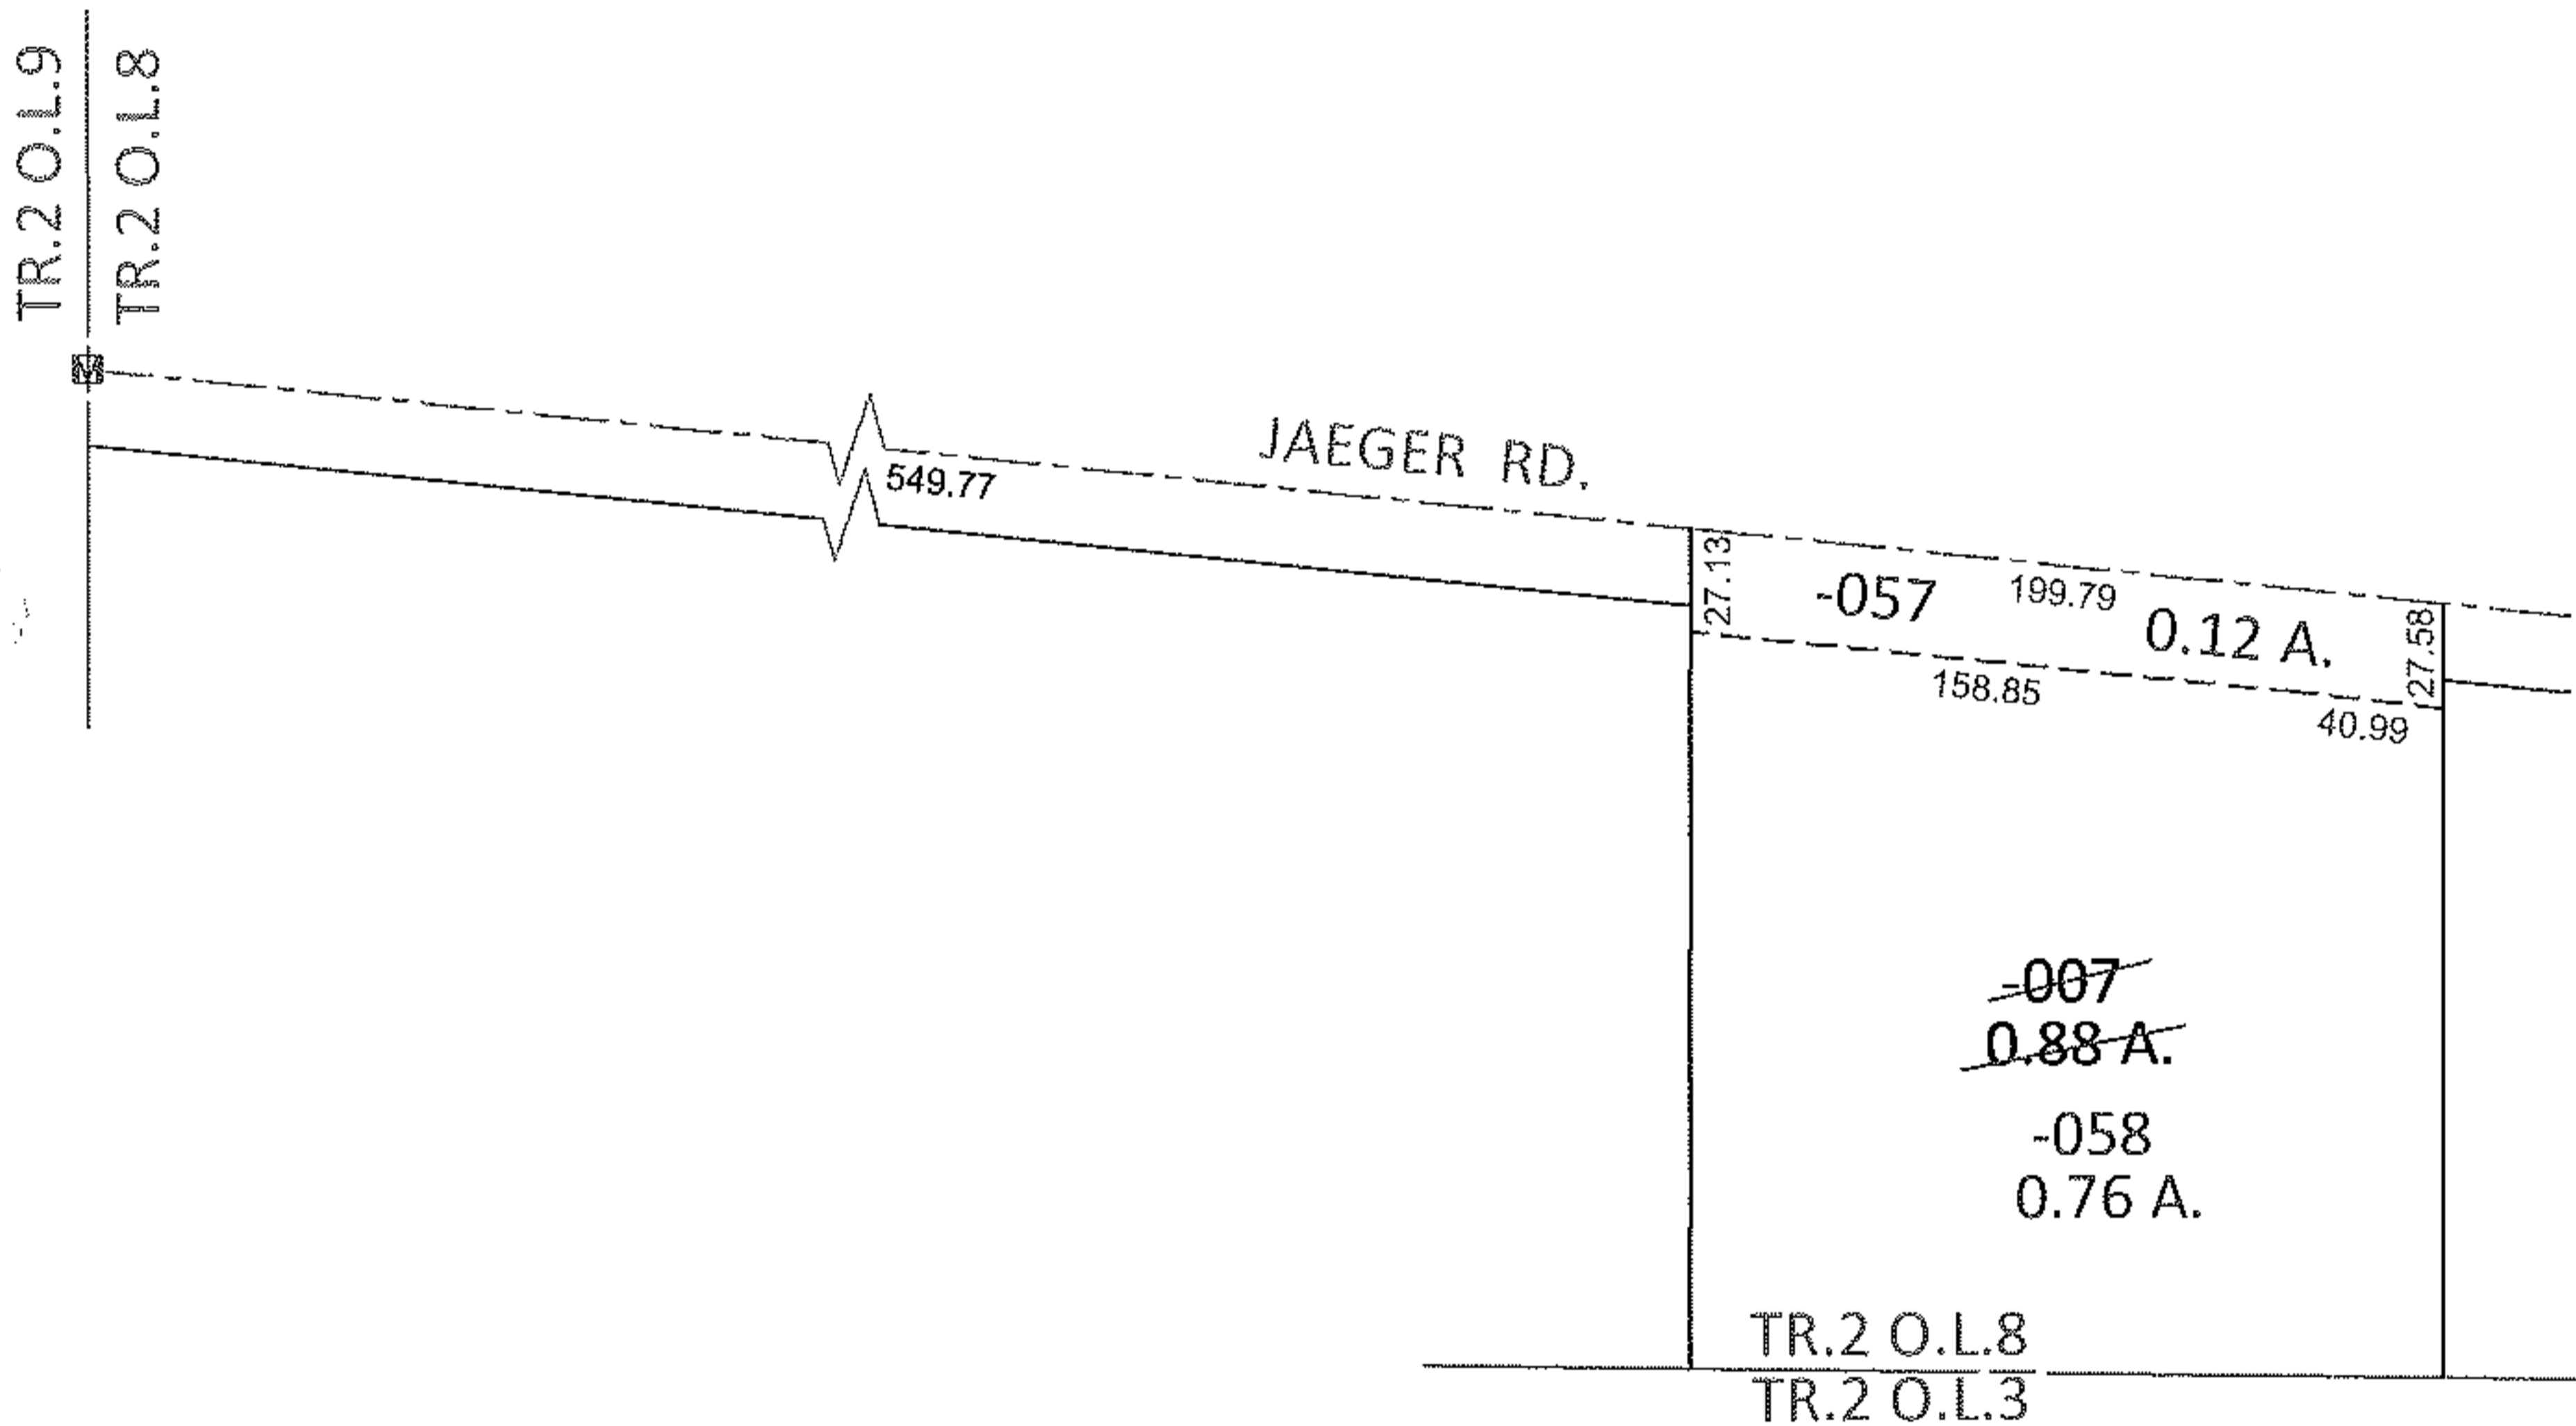


PARENT PARCEL: 02-02-008-107-007

CHILD PARCEL: 02-02-008-107-057, -058

12-00277

STARTING POINT: AT A MON BOX AT THE INTERSECTION OF C/L OF JAEGER RD. AND WEST LINE OF TR.2 O.L.8

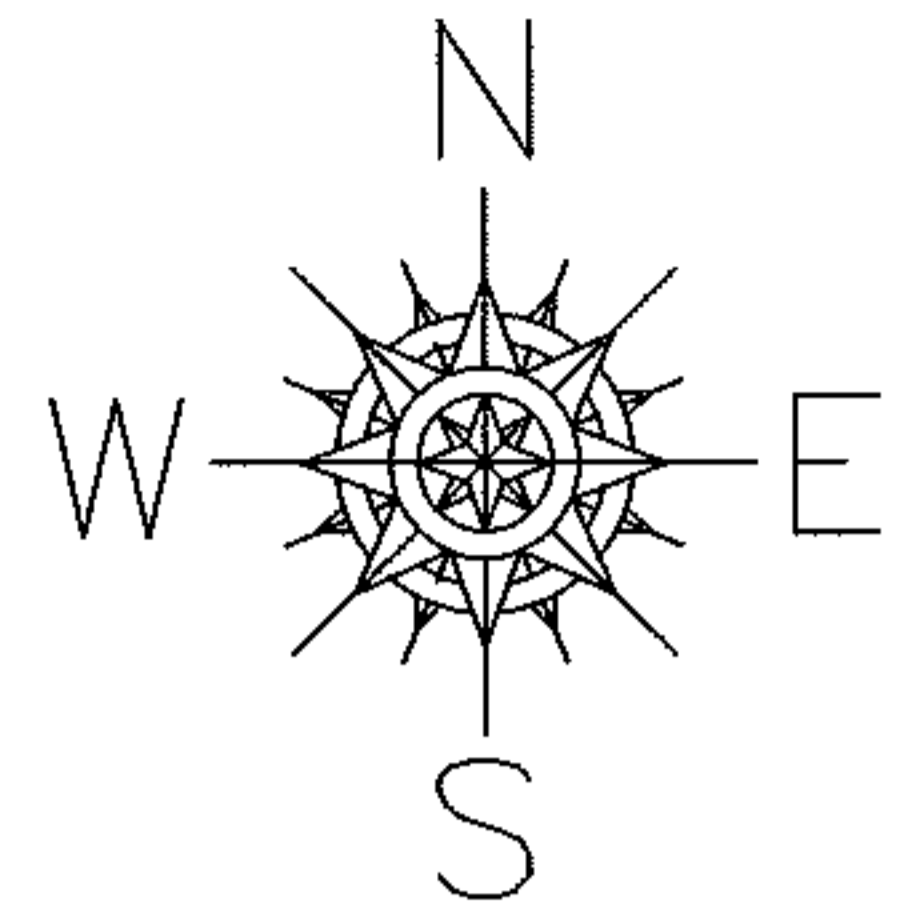

**SPLITS/DEEDS PROCESSED**

LORAIN COUNTY TAX MAP DEPARTMENT  
226 MIDDLE AVE. ELYRIA, OHIO

SURVEYED BY: TREVOR A. BIXLER

CLOSURE: .00:10,000

MAP PAGE(S): 2-02-008-A

APPROVED BY: RRM DATE: 5-4-12

SCALE: 1"= 100 PRIOR INST.: 20000663895