
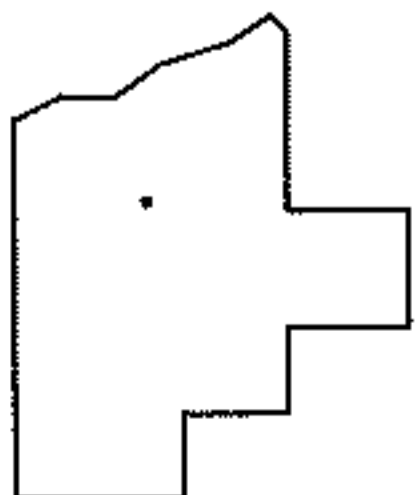
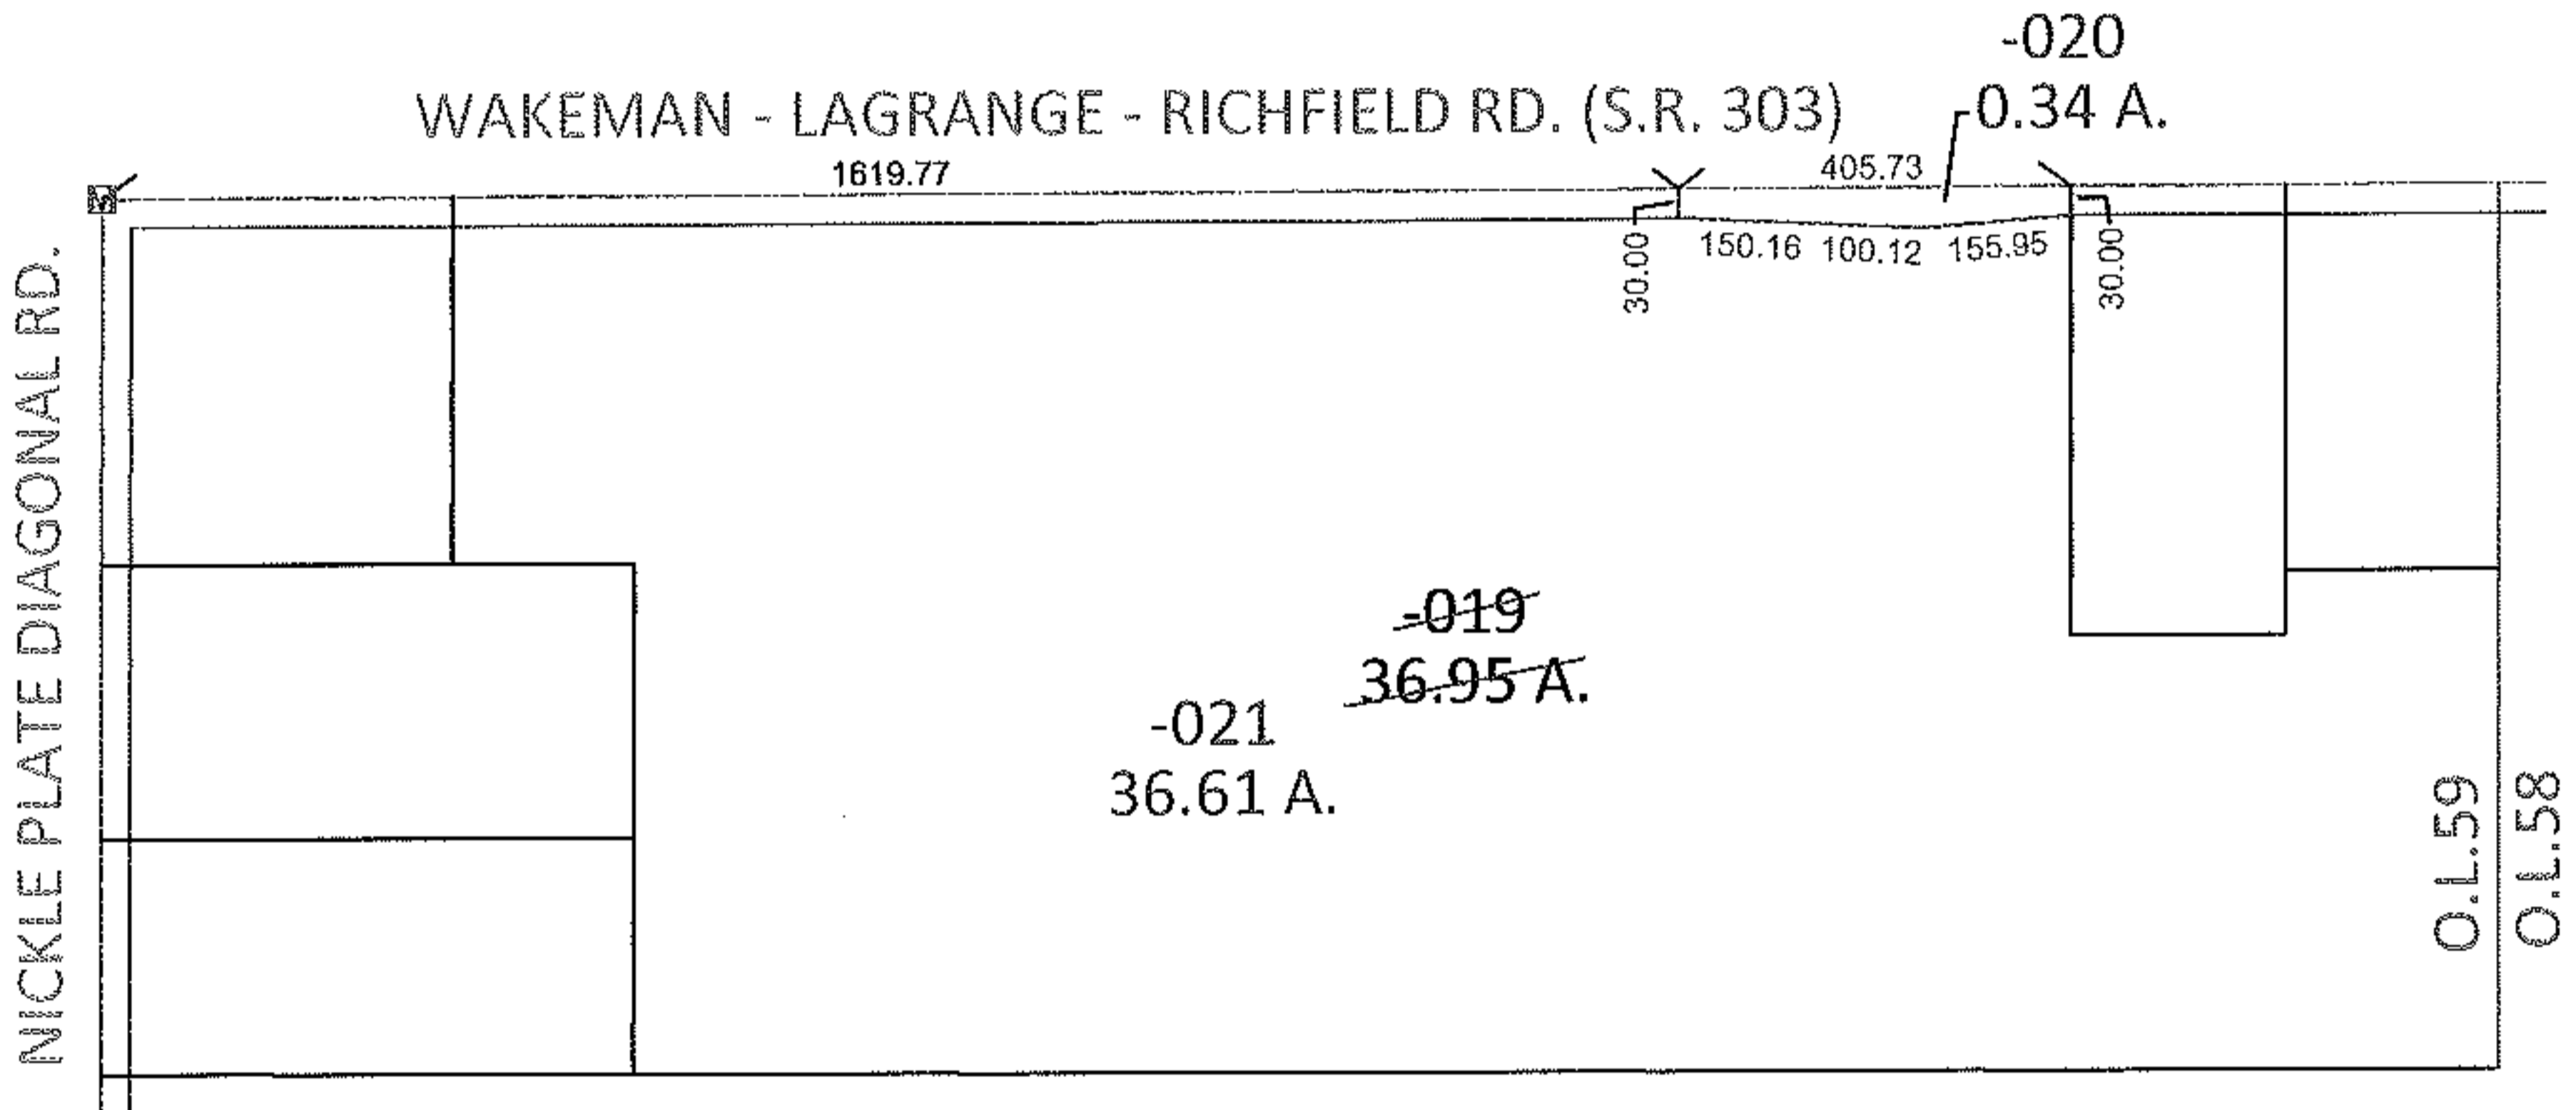


PARENT PARCEL: 15-00-059-000-019

CHILD PARCEL: 15-00-059-000-020, -021

12-00284

STARTING POINT: AT A MON BOX AT THE INTERSECTION OF C/L OF S.R.303 AND C/L OF NICKLE PLATE DIAGONAL RD.

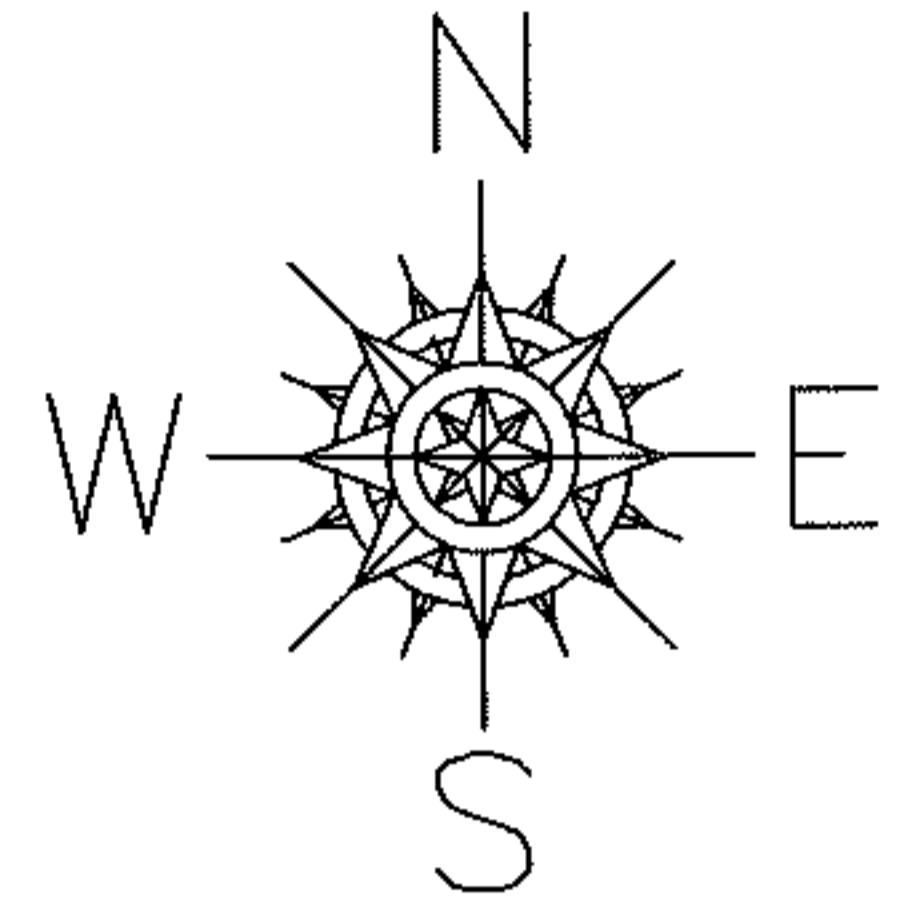

**SPLITS/DEEDS PROCESSED**

LORAIN COUNTY TAX MAP DEPARTMENT  
226 MIDDLE AVE. ELYRIA, OHIO

SURVEYED BY: RAYMOND W. FOOS

CLOSURE: .01:10,000

MAP PAGE(S): 15-E

APPROVED BY: RRM DATE: 6-15-12

SCALE: 1"= 400 PRIOR INST.: 19990625153