
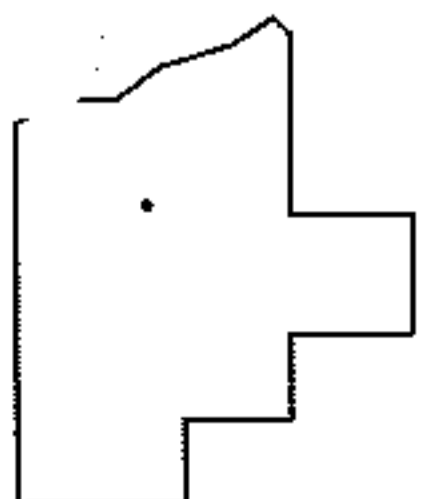
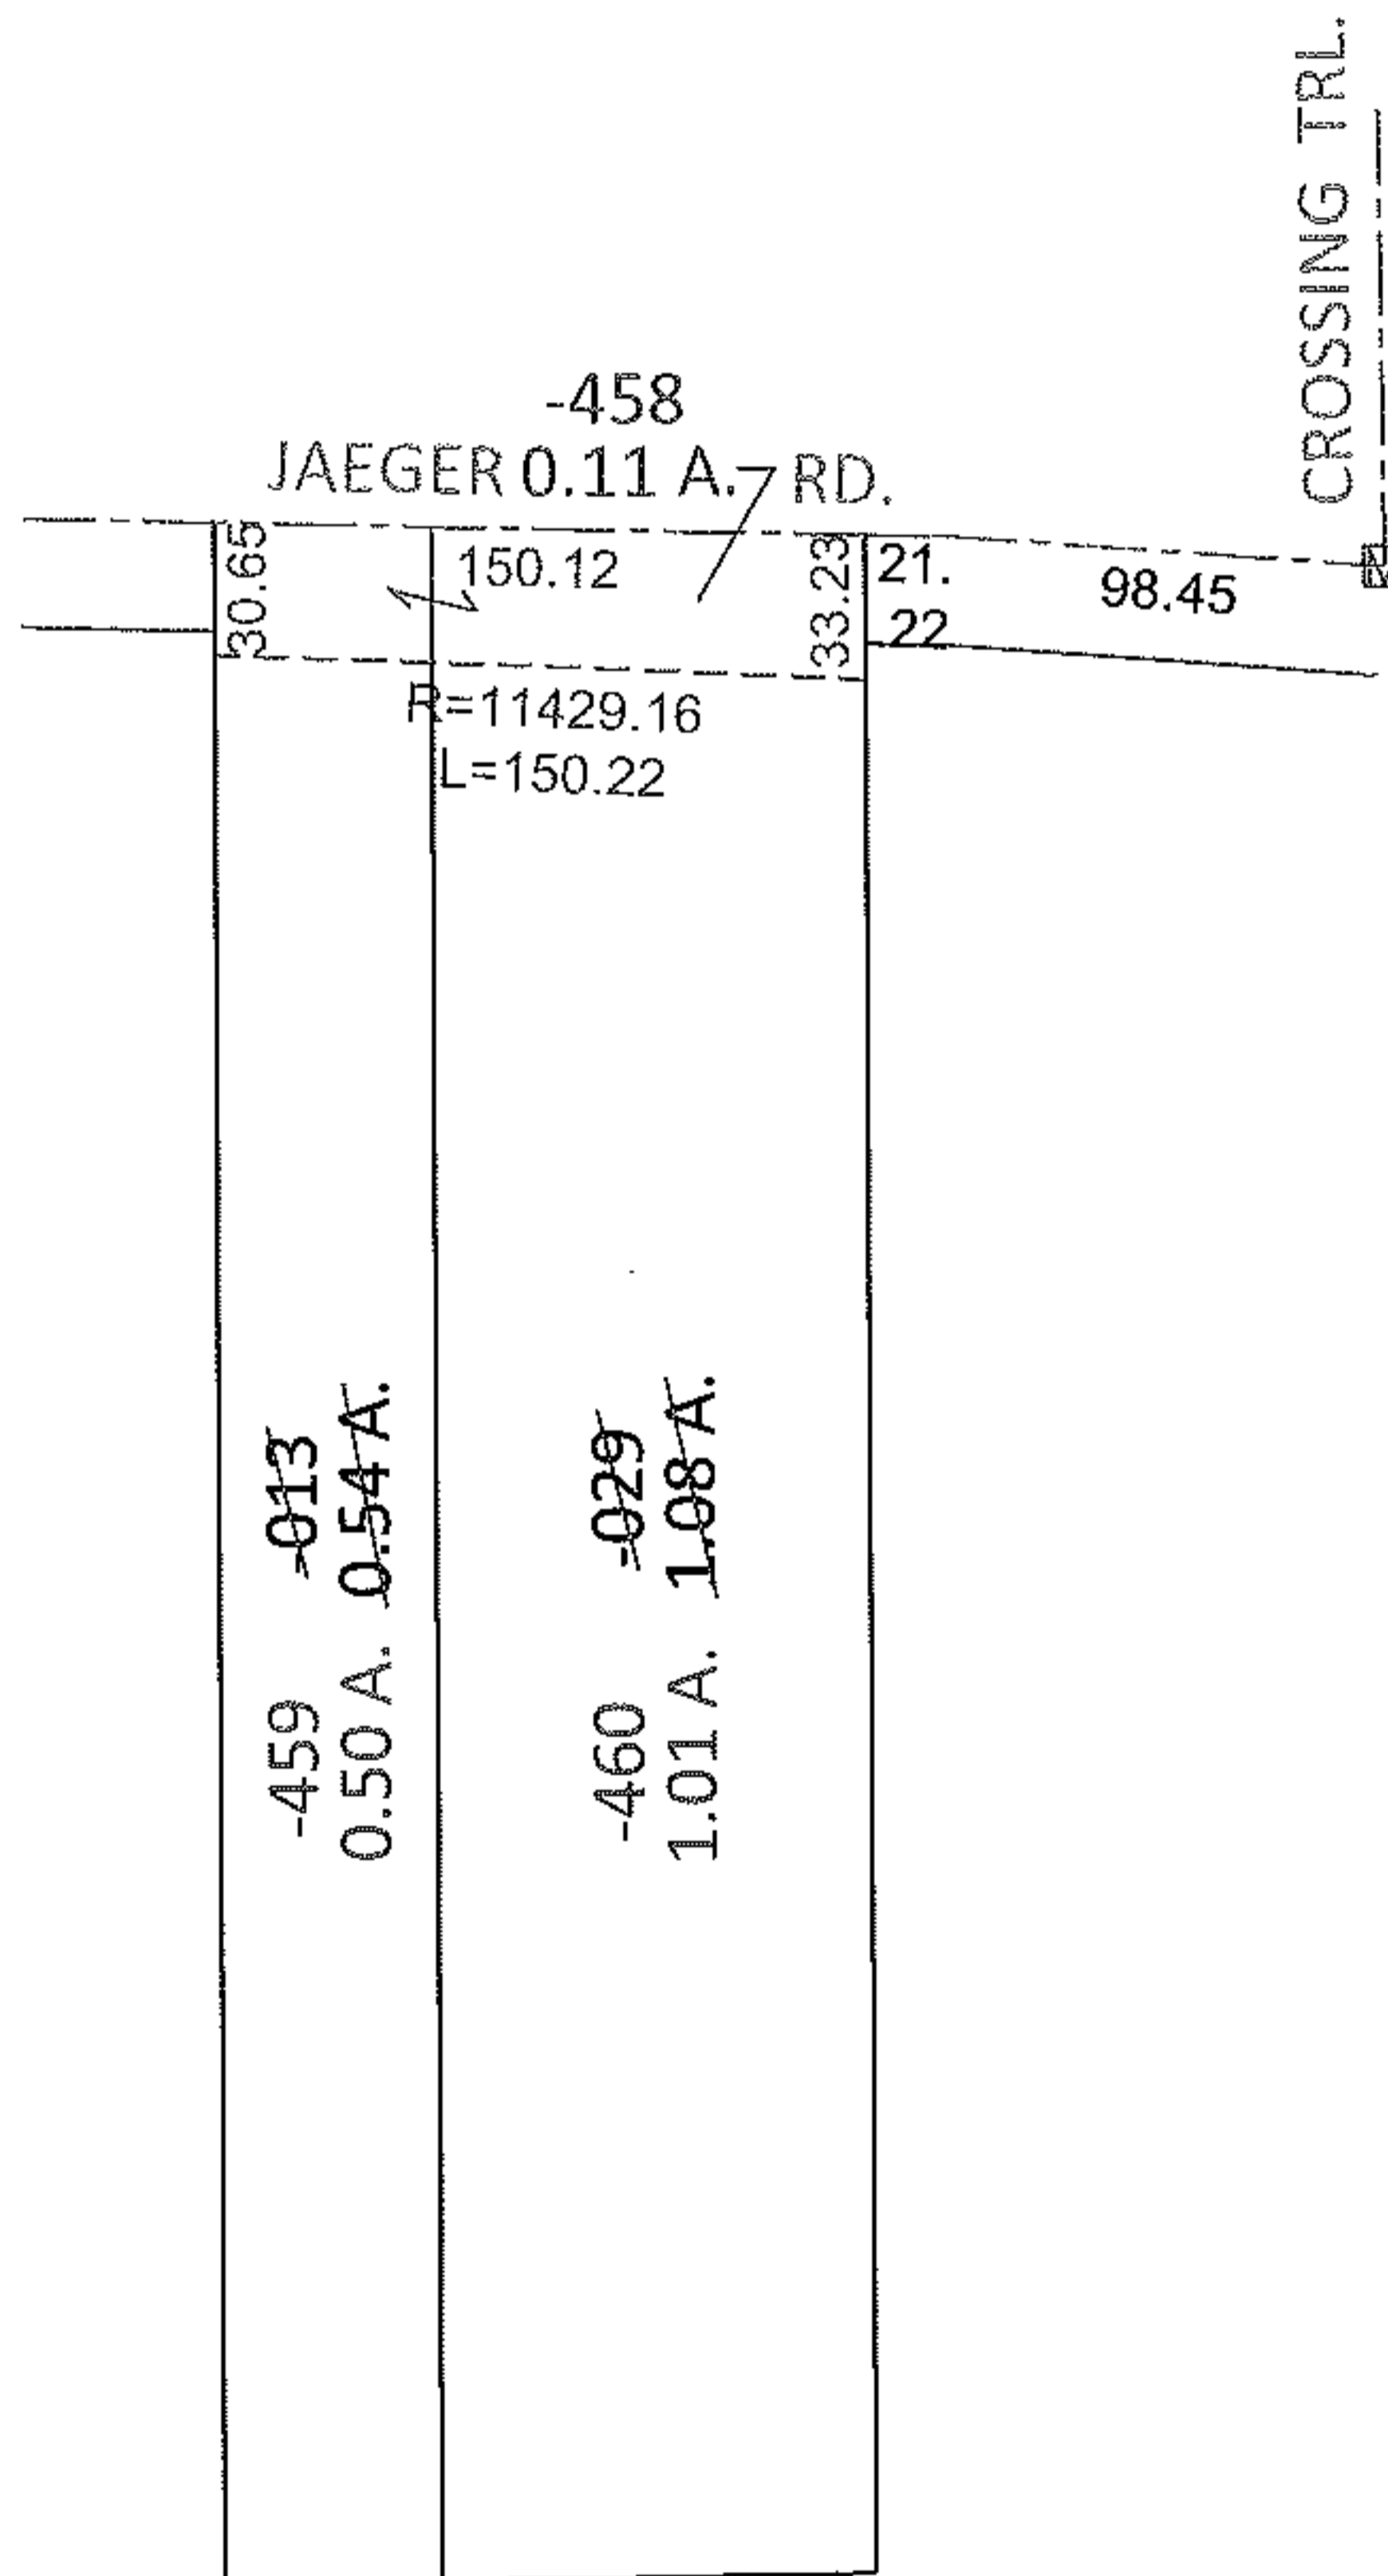


PARENT PARCEL: 02-02-010-000-013, -029

CHILD PARCEL: 02-02-010-000-458 THRU -460

STARTING POINT: AT A MON BOX AT THE INTERSECTION OF C/L OF JAEGER RD. AND C/L OF CROSSING TRL.

12-00291

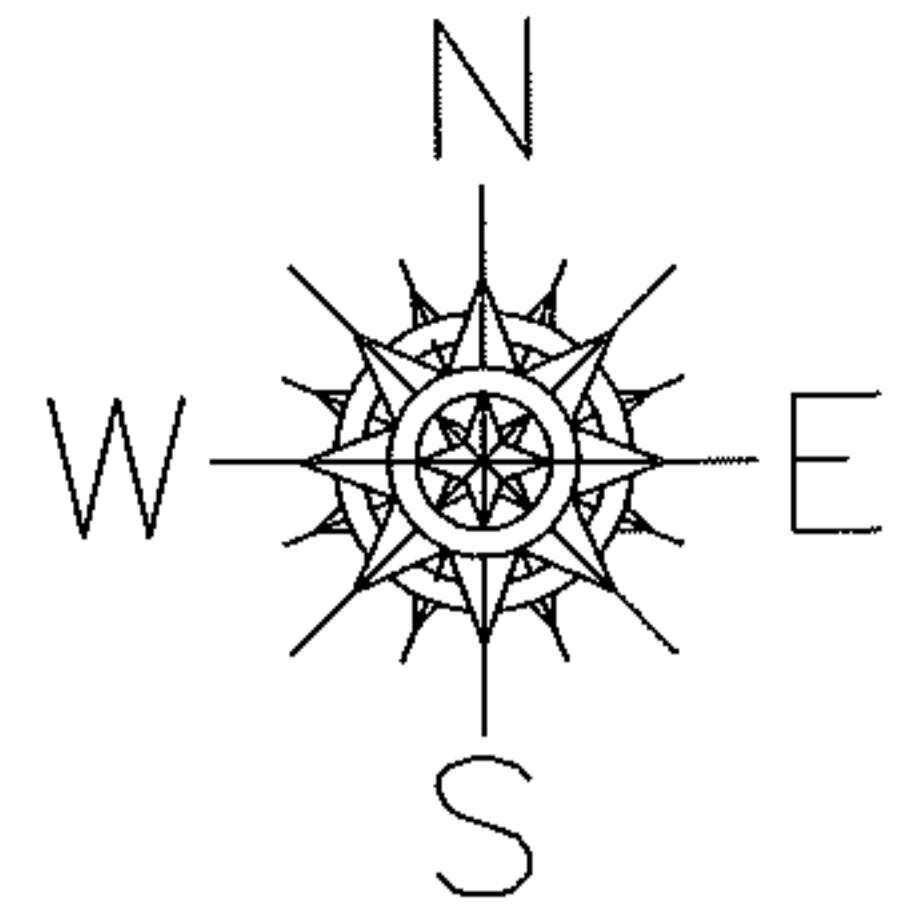

SPLITS/DEEDS PROCESSED

LORAIN COUNTY TAX MAP DEPARTMENT
226 MIDDLE AVE. ELYRIA, OHIO

SURVEYED BY: TREVOR A. BIXLER

CLOSURE: .01:10,000

MAP PAGE(S): 2-02-010-B

APPROVED BY: RRM DATE: 8-6-12

SCALE: 1"= 100 PRIOR INST.: 20060129165