


RASTER

PARENT PARCEL: 03-00-001-000-129


CHILD PARCEL: 03-00-001-000-171 & -172

STARTING POINT: MON. BOX, CL OF ABBE RD. & SOUTH LINE OF SHEFFIELD TWP. O.L. 1

12-00293

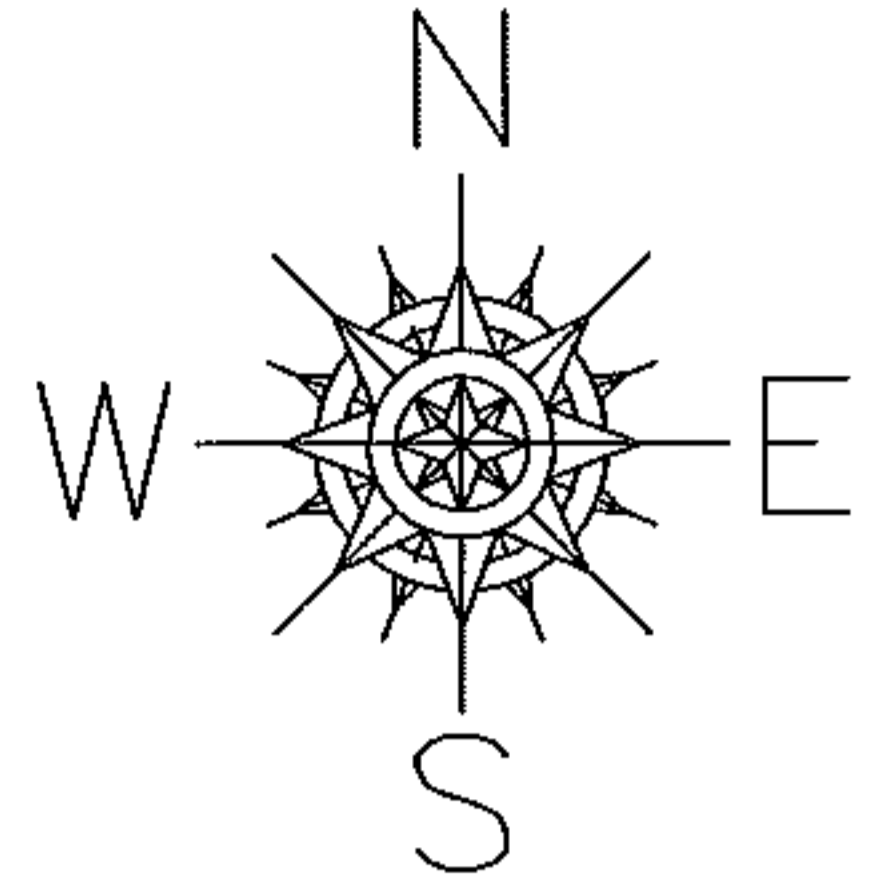

ABBE RD.

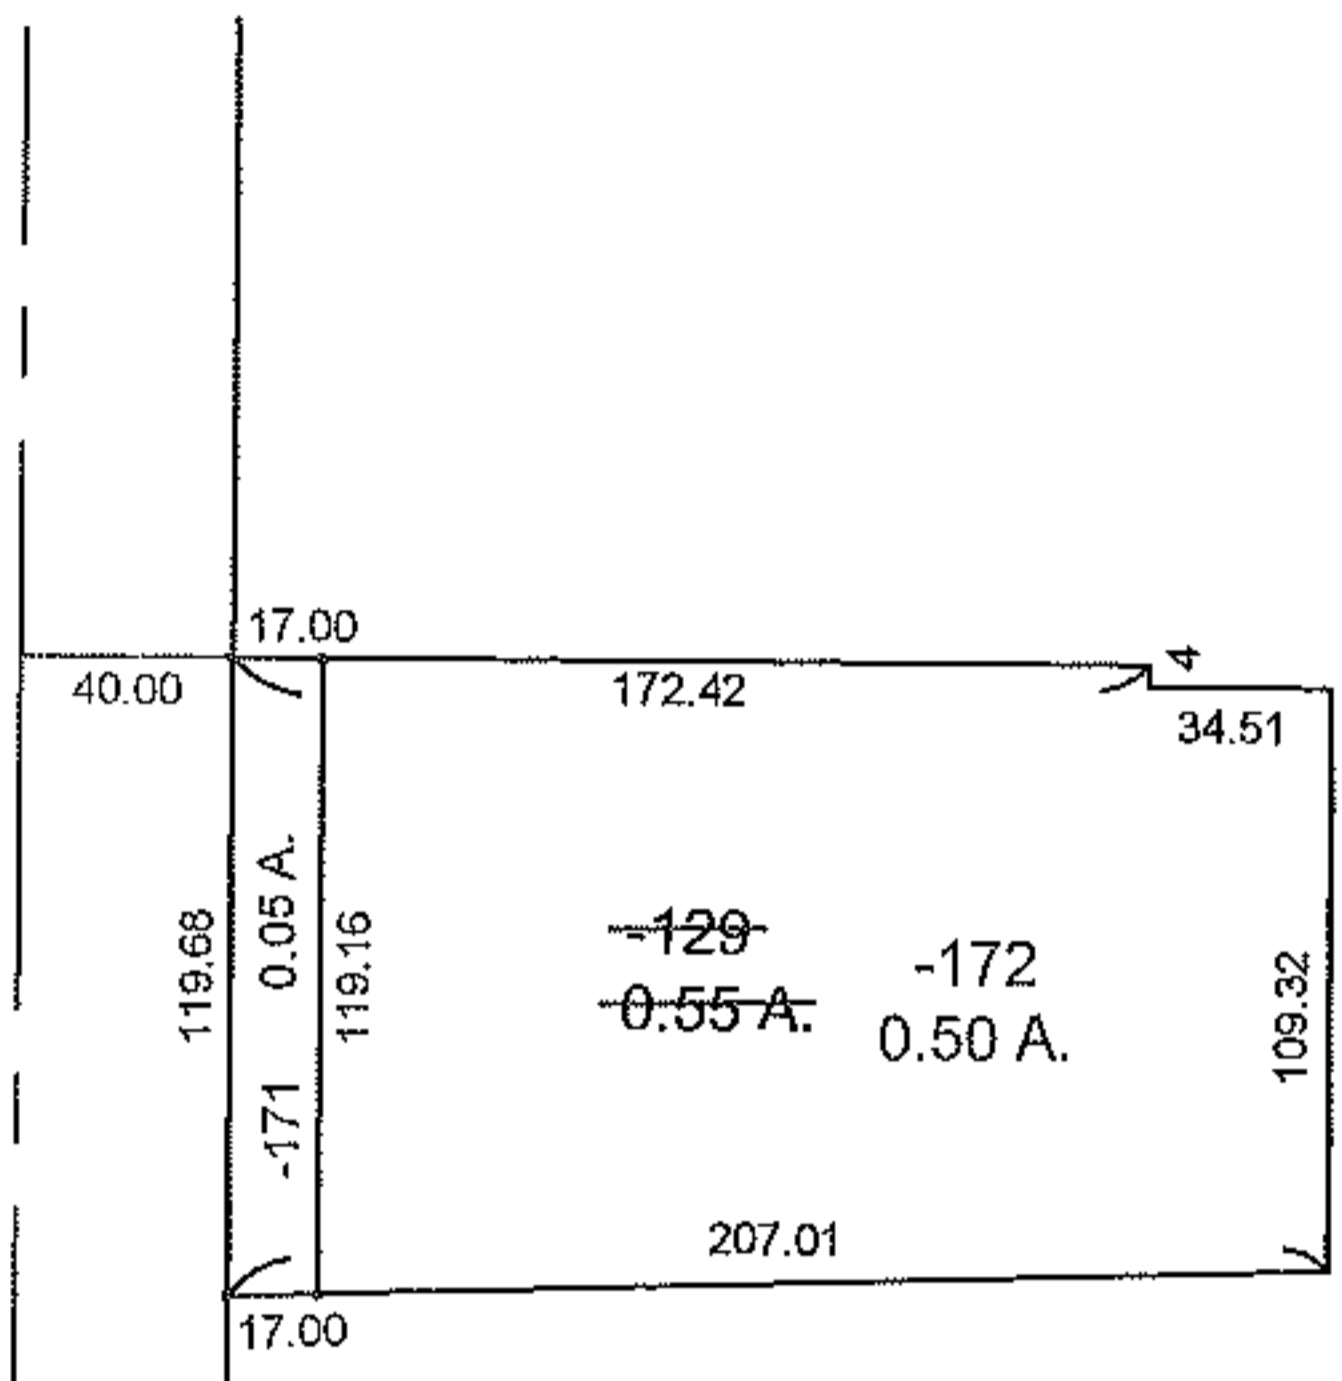

SHEFFIELD TWP. O.L. 11

SHEFFIELD TWP. O.L. 1

ELYRIA TWP. BURRELL & DAY TRACT O.L. 7

ELYRIA TWP. BURRELL & DAY TRACT O.L. 3

SPLITS/DEEDS PROCESSED

LORAIN COUNTY TAX MAP DEPARTMENT
226 MIDDLE AVE. ELYRIA, OHIO

SURVEYED BY: RICHARD J. SWAN

CLOSURE: 1:10,000

MAP PAGE(S): 3-00-001-A

APPROVED BY: TJS DATE: 7/30/12

SCALE: 1"=100 PRIOR INST.: 2003965446