
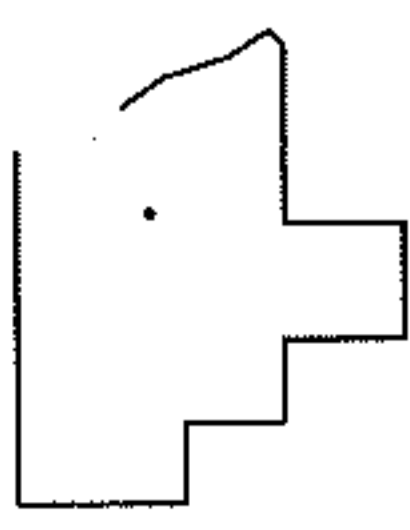
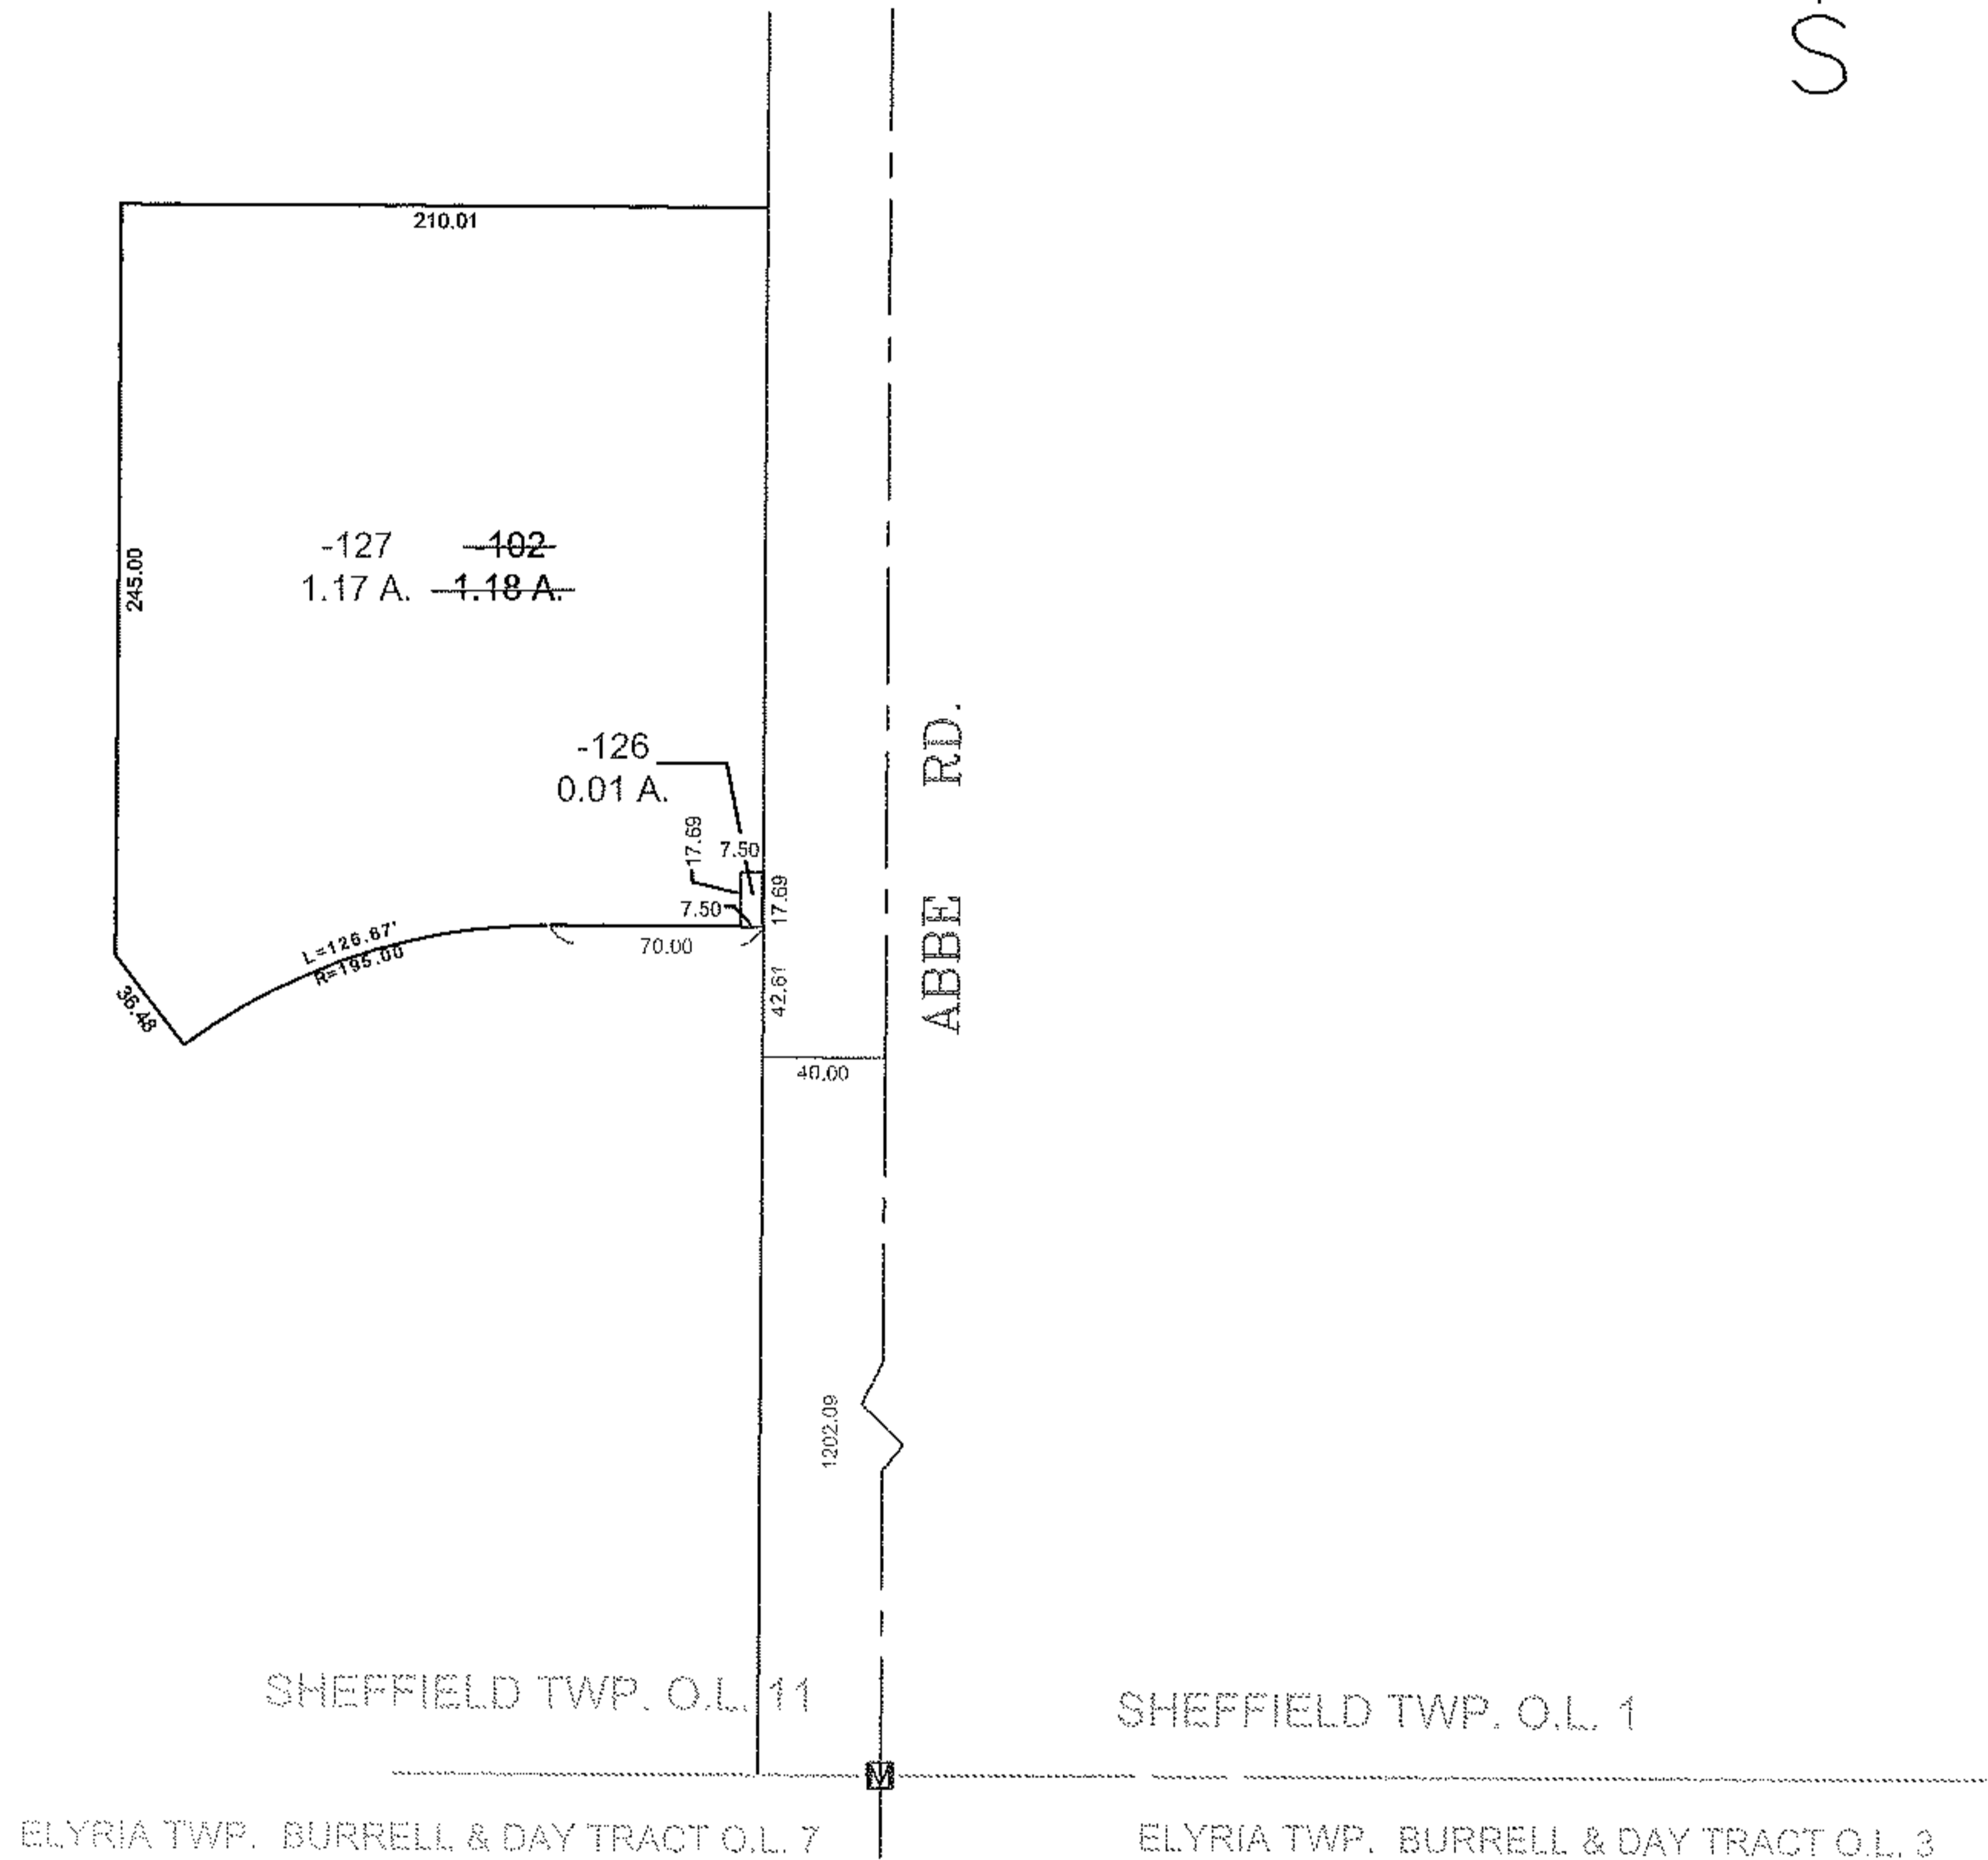


PARENT PARCEL: 03-00-011-102-102

CHILD PARCEL: 03-00-011-102-126 & -127

STARTING POINT: MON. BOX, CL OF ABBE RD. & SOUTH LINE OF SHEFFIELD TWP. O.L. 1

12-00294

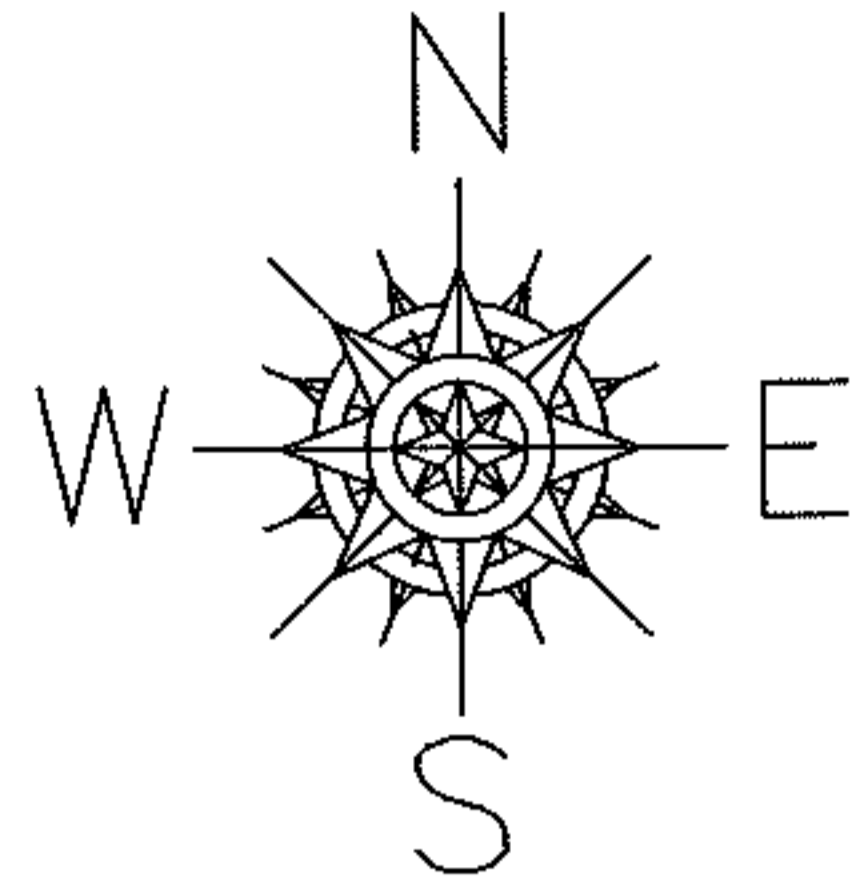

SPLITS/DEEDS PROCESSED

LORAIN COUNTY TAX MAP DEPARTMENT
226 MIDDLE AVE. ELYRIA, OHIO

SURVEYED BY: RICHARD J. SWAN

CLOSURE: 1 : 10,000

MAP PAGE(S): 3-00-011-B

APPROVED BY: TJS DATE: 7/31/12

SCALE: 1"= 100 PRIOR INST.: 19990653434