
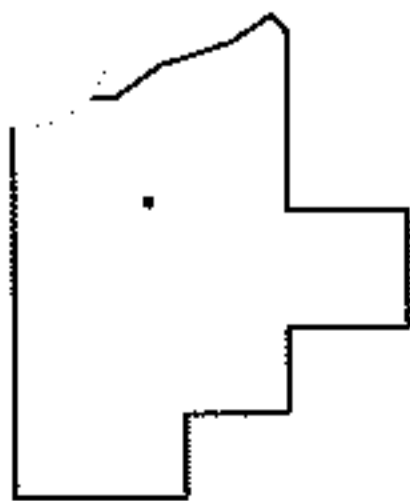
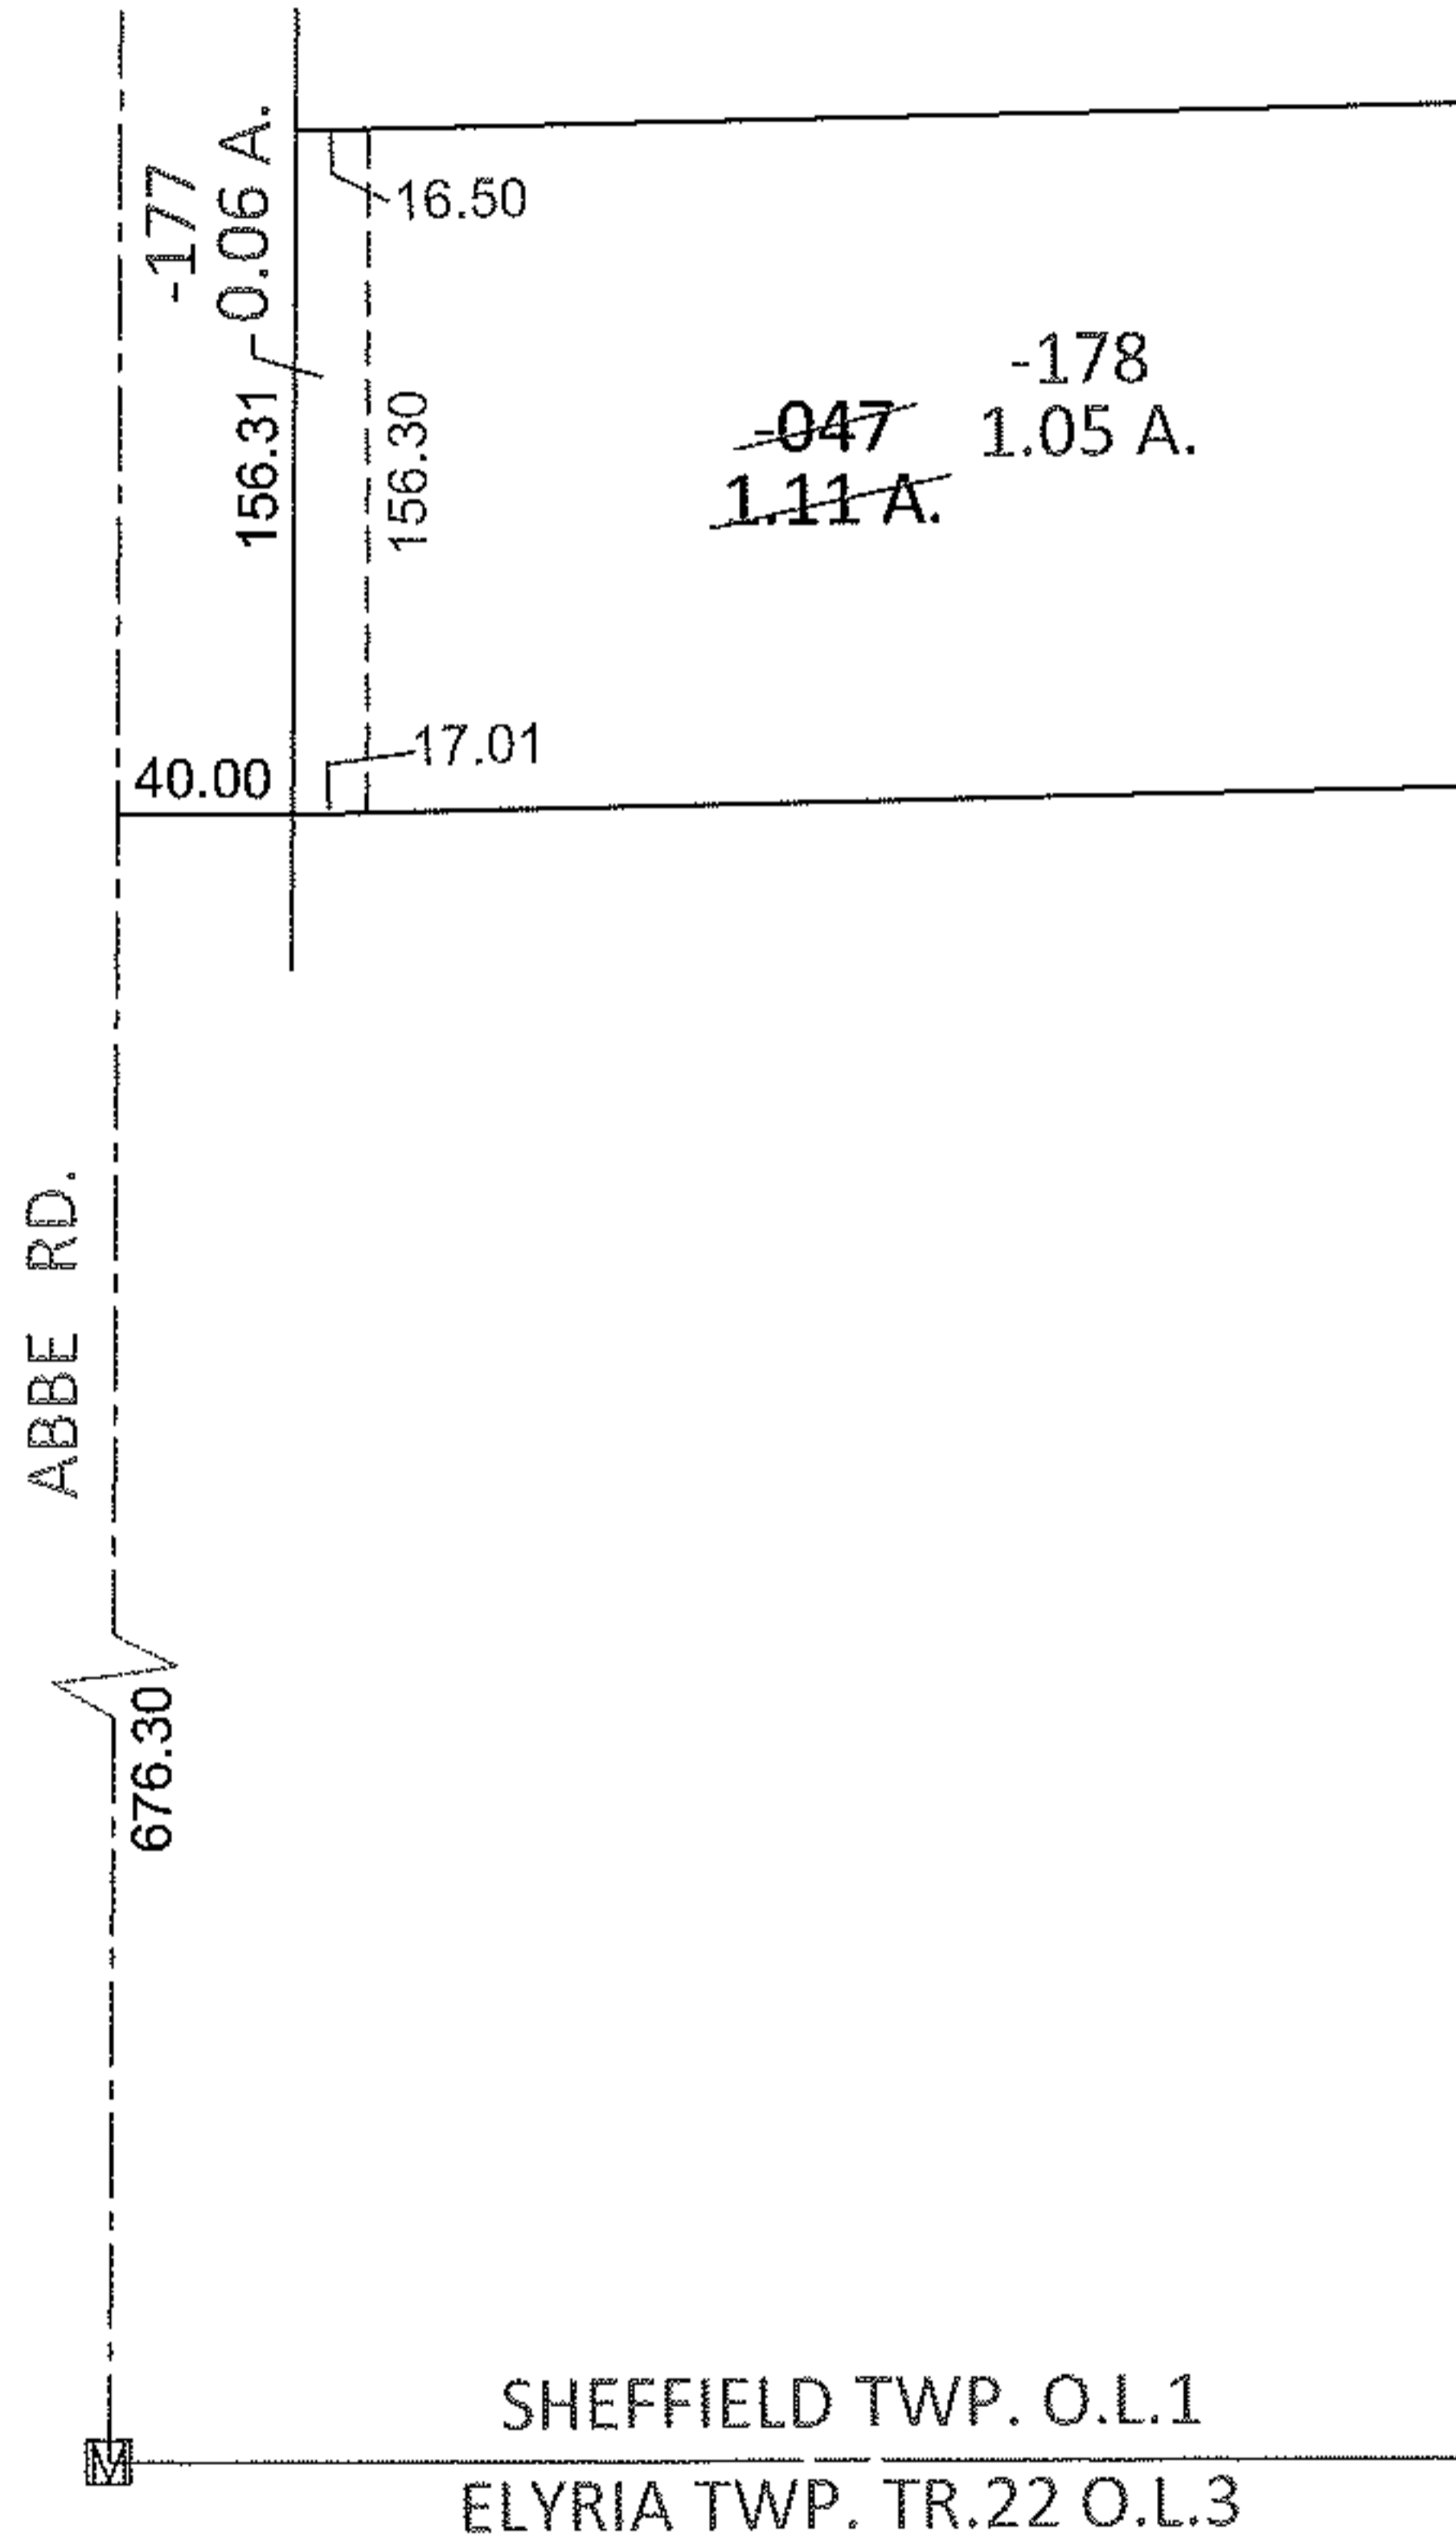


PARENT PARCEL: 03-00-001-000-047

CHILD PARCEL: 03-00-001-000-177, -178

12-00296

STARTING POINT: AT A MON BOX AT THE INTERSECTION OF C/L OF ABBE RD. AND SOUTH LINE OF O.L.1

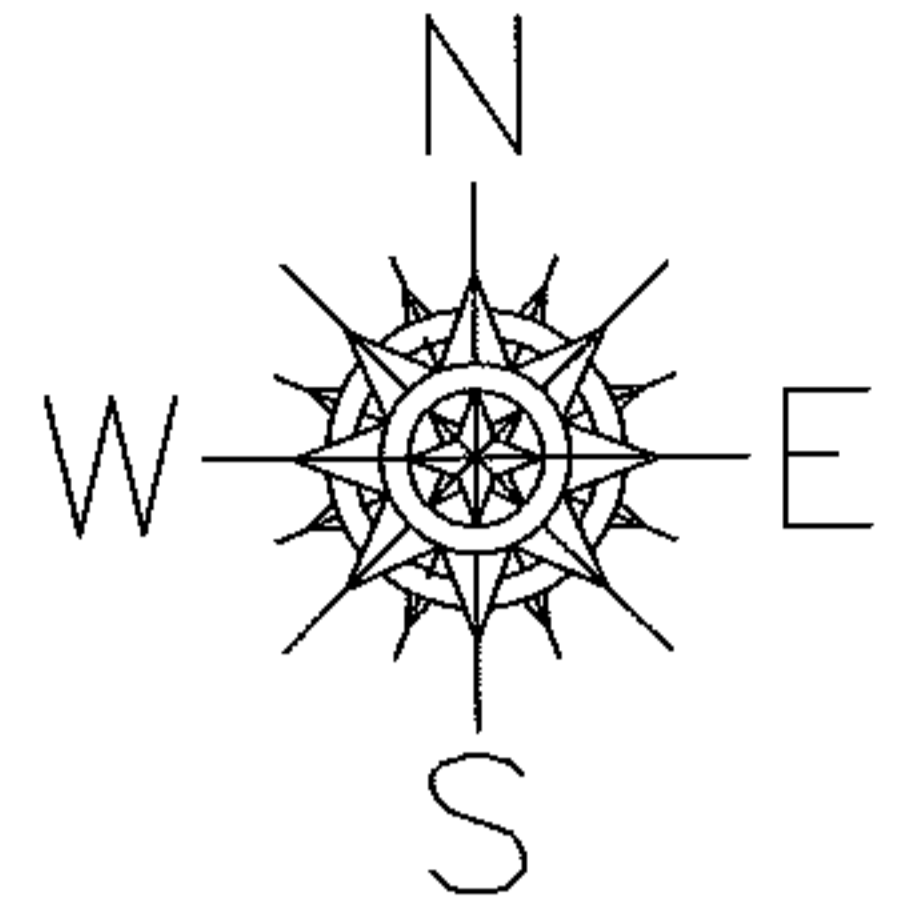

SPLITS/DEEDS PROCESSED

LORAIN COUNTY TAX MAP DEPARTMENT
226 MIDDLE AVE. ELYRIA, OHIO

SURVEYED BY: RICHARD JOHN SWAN

CLOSURE: .00:10,000

MAP PAGE(S): 3-00-001-A

APPROVED BY: RRM DATE: 9-4-12

SCALE: 1"= 100 PRIOR INST.: 20070188881