
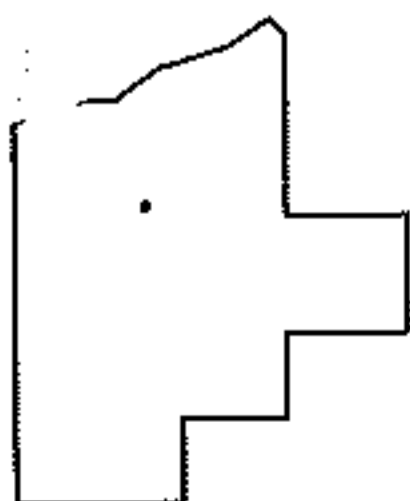
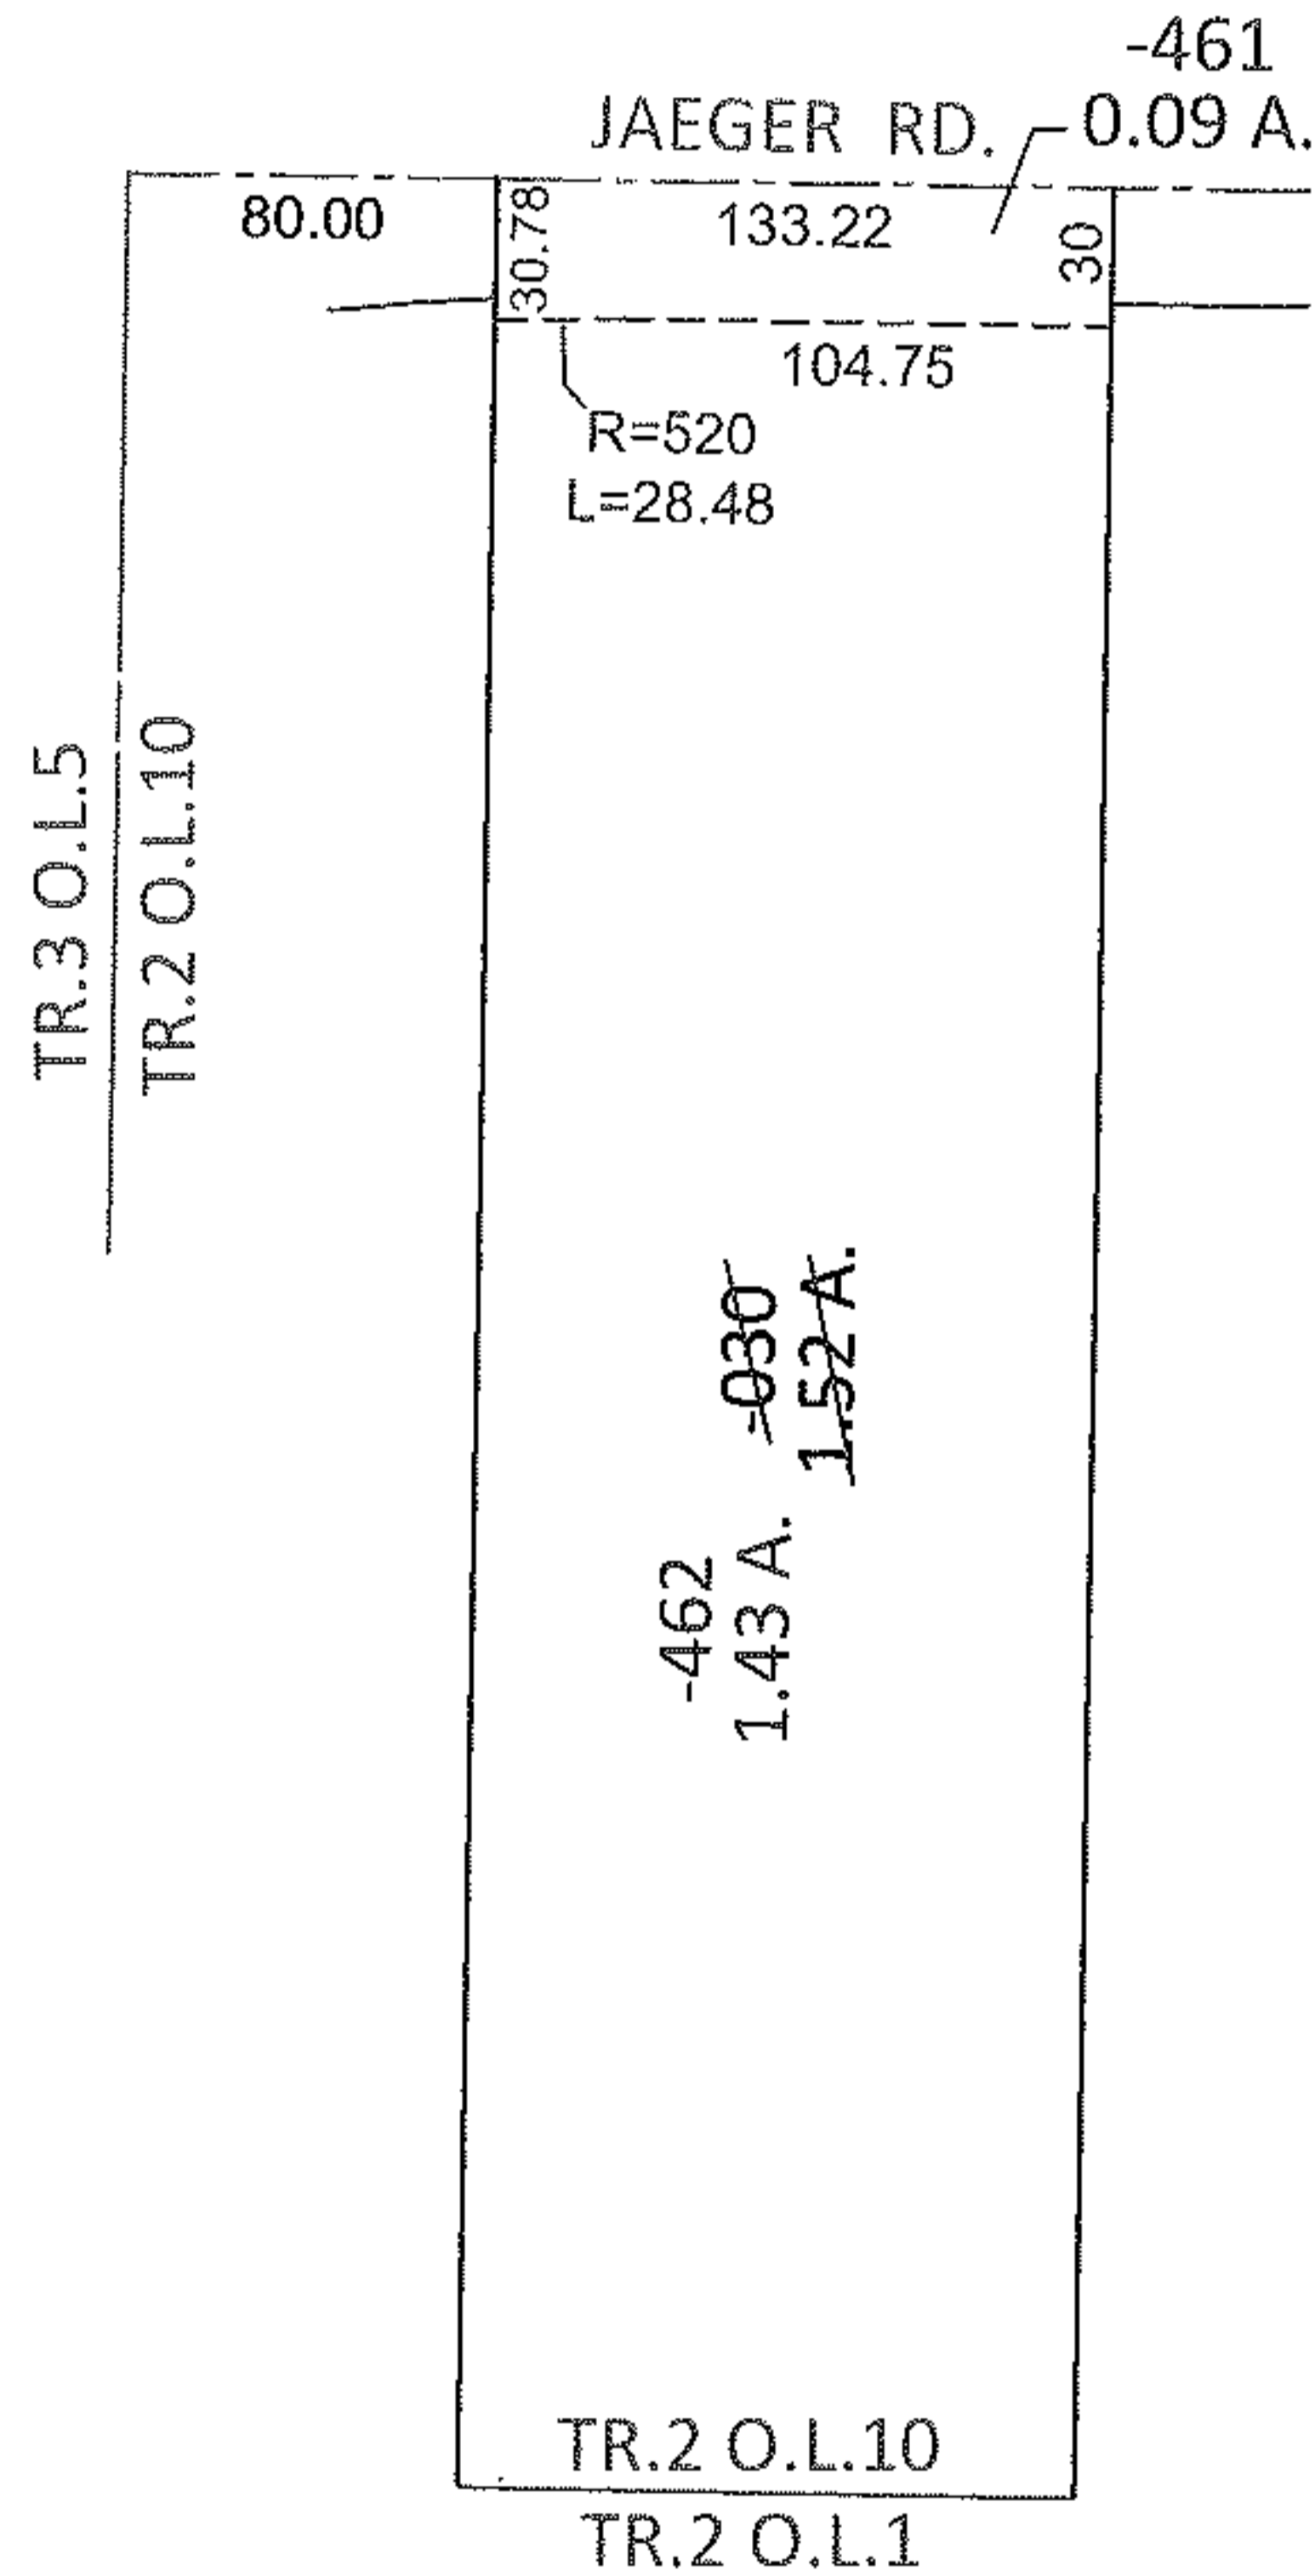


PARENT PARCEL: 02-02-010-000-030

CHILD PARCEL: 02-02-010-000-461, -462

STARTING POINT: INTERSECTION OF C/L OF JAEGER RD. AND WEST LINE OF TR. 2 O.L.10

12-00303

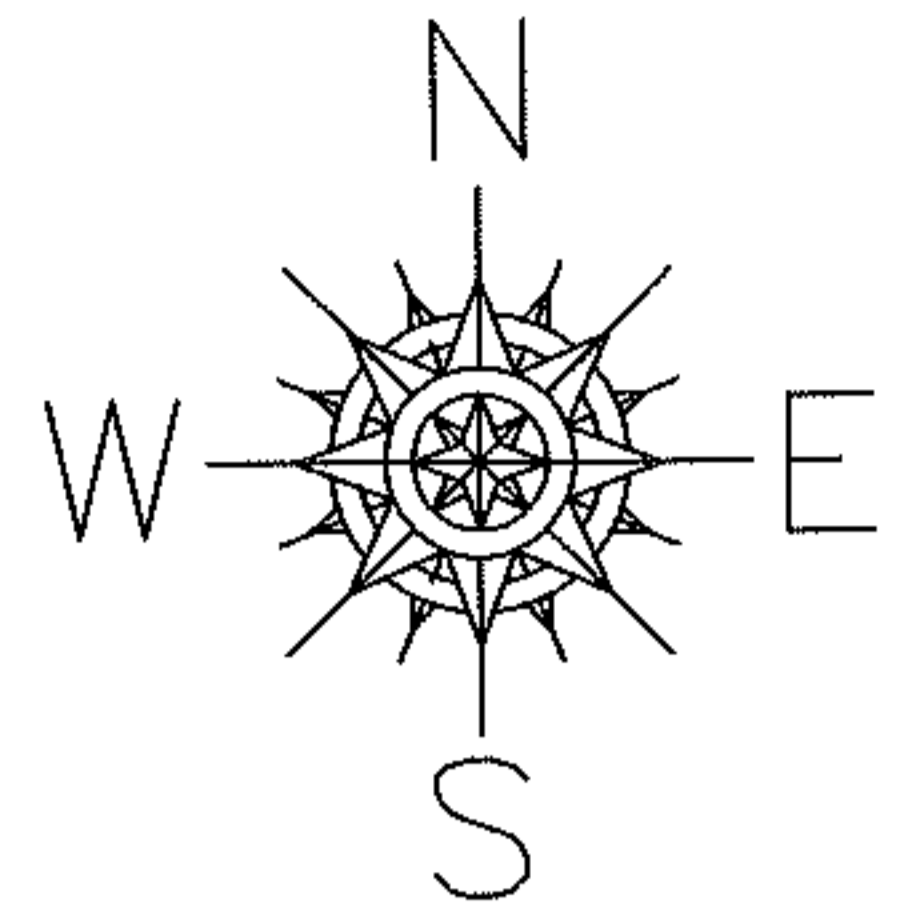

SPLITS/DEEDS PROCESSED

LORAIN COUNTY TAX MAP DEPARTMENT
226 MIDDLE AVE. ELYRIA, OHIO

SURVEYED BY: TREVOR A. BIXLER

CLOSURE: .01:10,000

MAP PAGE(S): 2-02-010-A

APPROVED BY: RRM DATE: 9-20-12

SCALE: 1"= 100 PRIOR INST.: 20090291323