
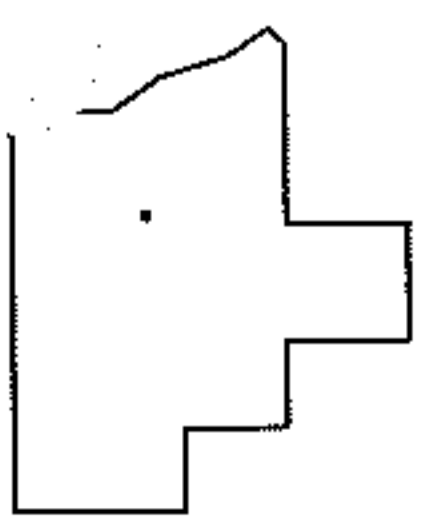
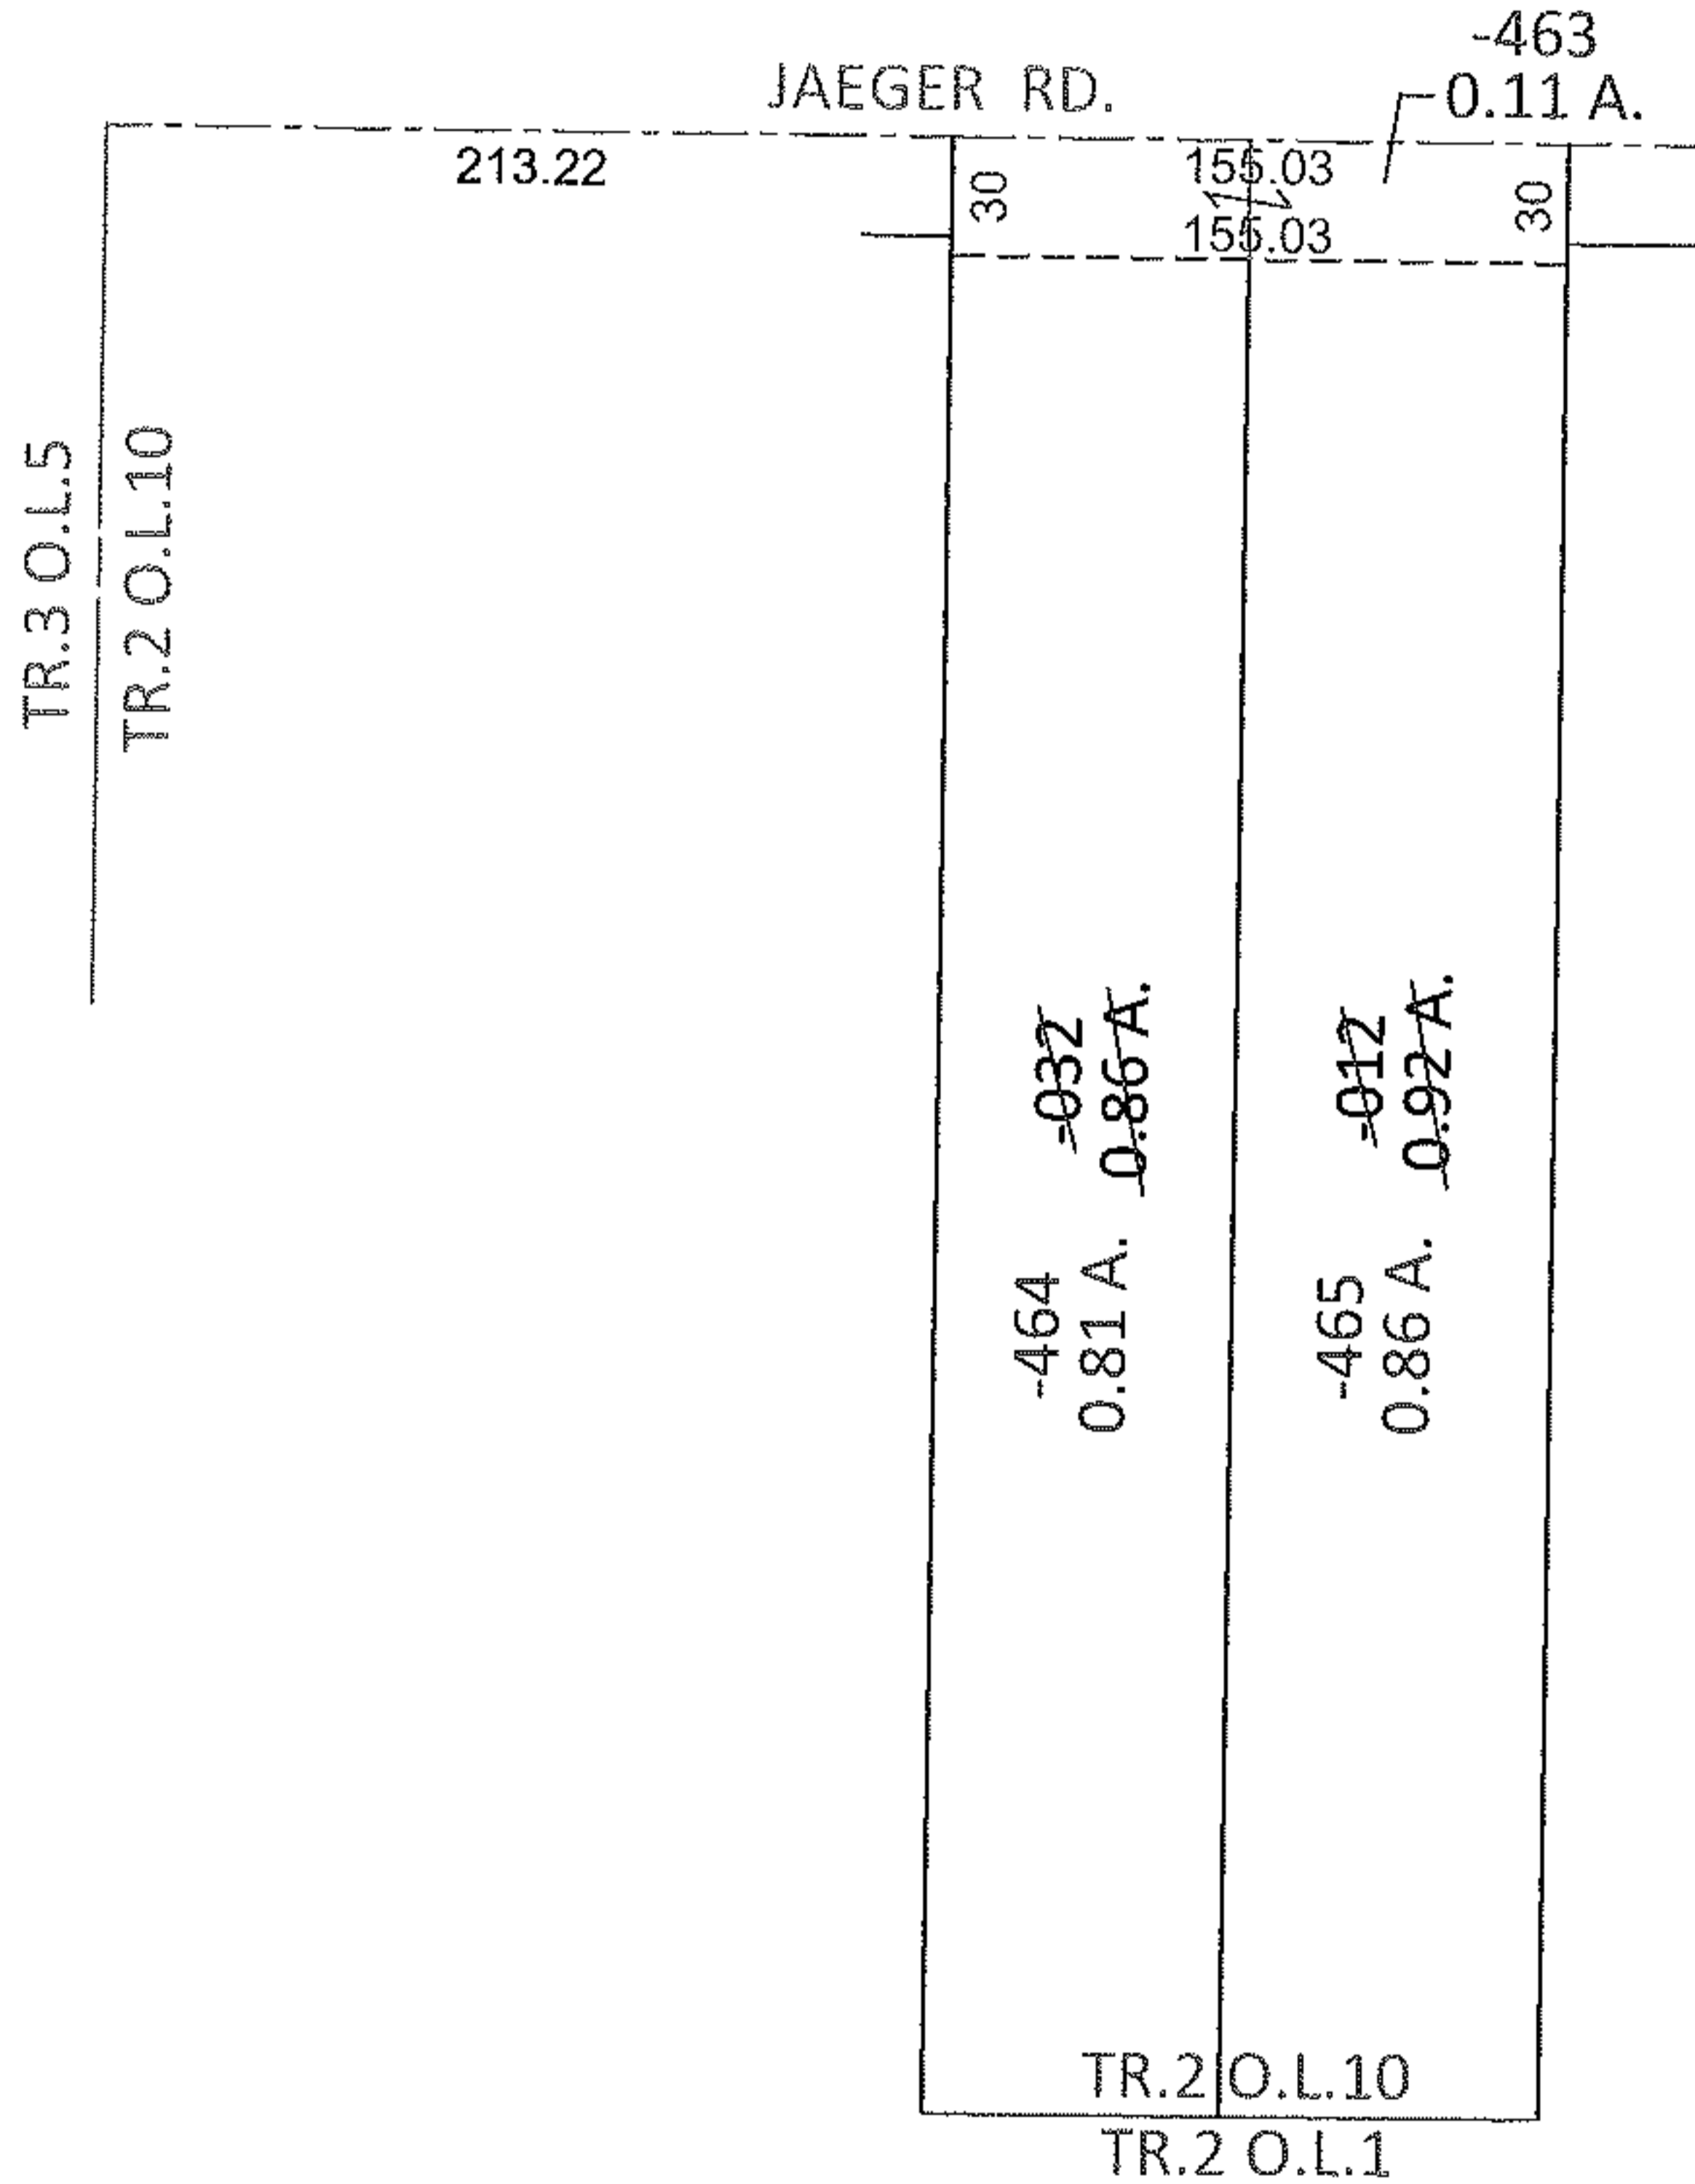


PARENT PARCEL: 02-02-010-000-012, -032
CHILD PARCEL: 02-02-010-000-463 THRU -465
STARTING POINT: INTERSECTION OF C/L OF JAEGER RD. AND WEST LINE OF TR. 2 O.L. 10

12-00305

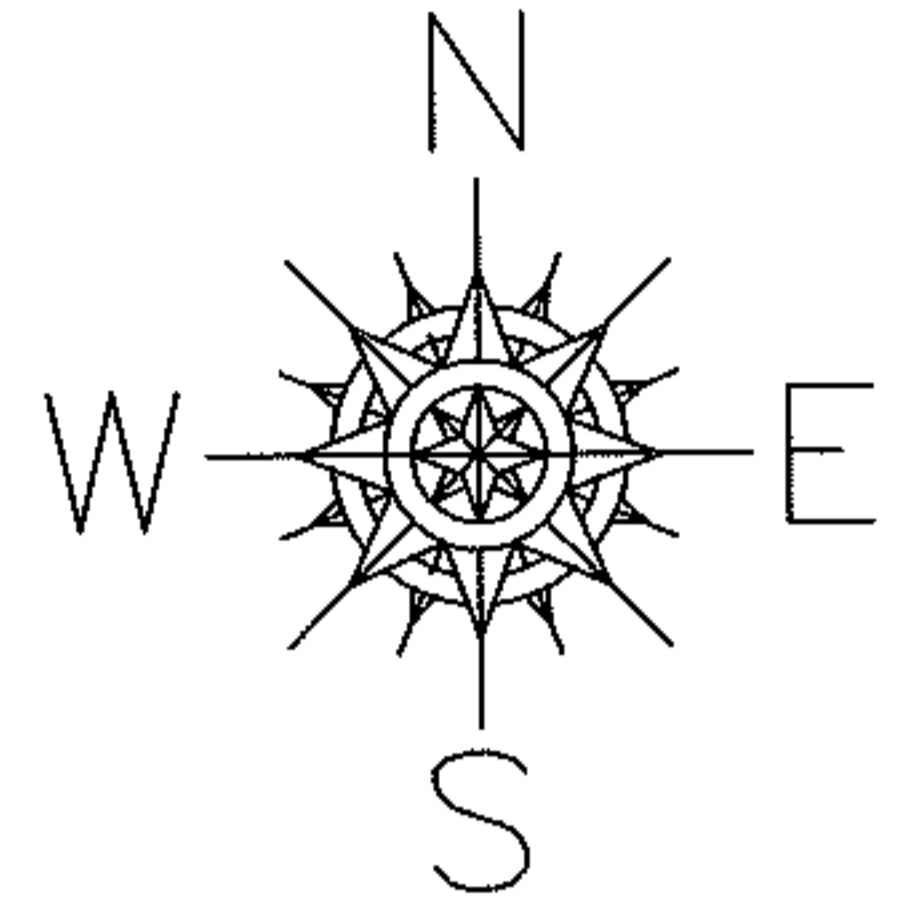

SPLITS/DEEDS PROCESSED

LORAIN COUNTY TAX MAP DEPARTMENT
226 MIDDLE AVE. ELYRIA, OHIO

SURVEYED BY: TREVOR A BIXLER
CLOSURE: .00:10,000
MAP PAGE(S): 2-02-010-A
APPROVED BY: RRM DATE: 9-20-12
SCALE: 1"= 100 PRIOR INST.: 20100334525