
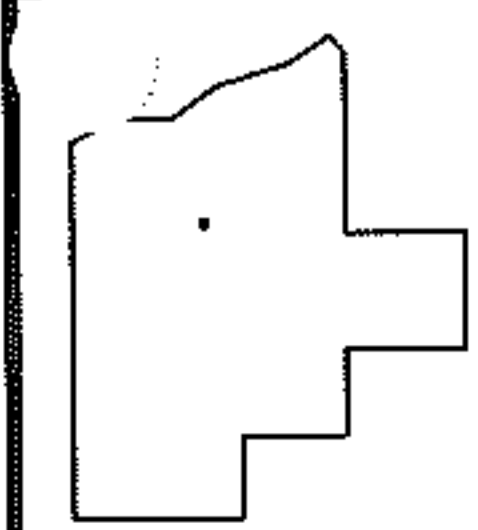
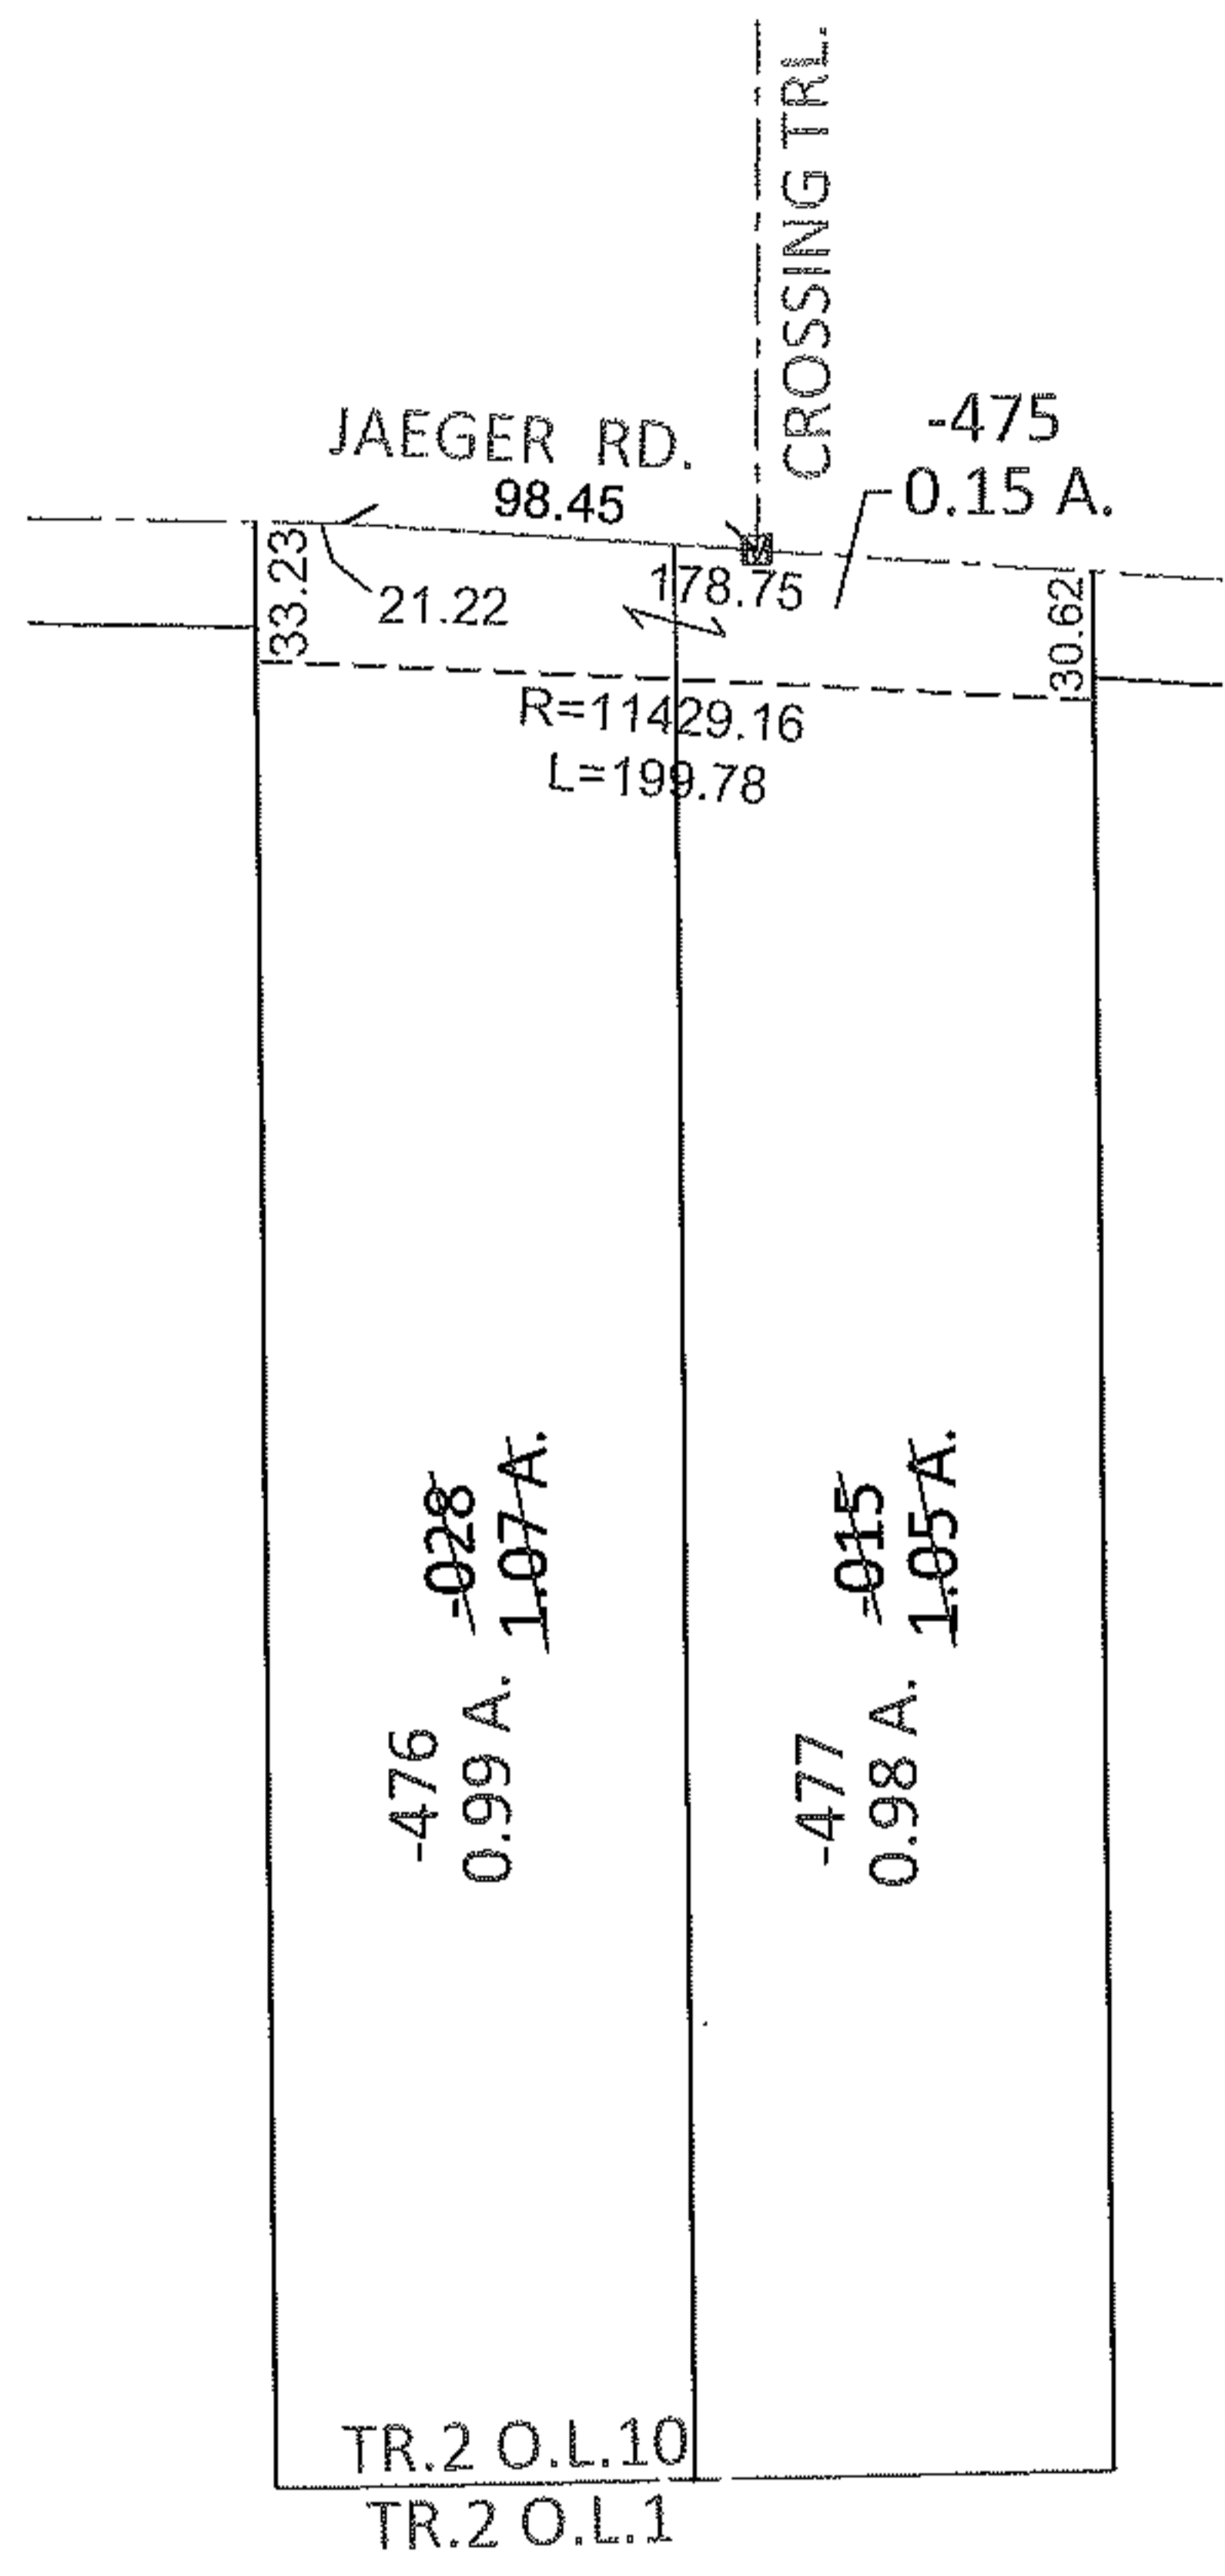


PARENT PARCEL: 02-02-010-000-015, -028
 CHILD PARCEL: 02-02-010-000-475 THRU -477
 STARTING POINT: AT A MON BOX AT THE INTERSECTION OF C/L OF JAEGER RD. AND C/L OF CROSSING TRL.

12-00310

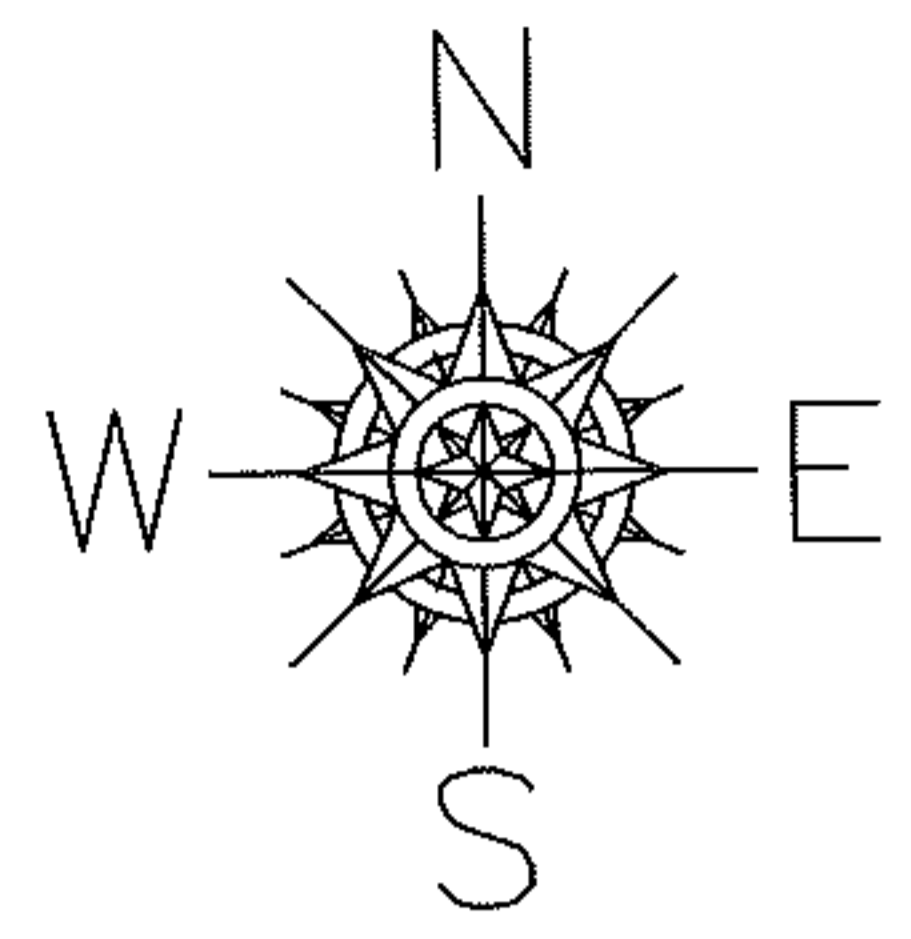

SPLITS/DEEDS PROCESSED
 LORAIN COUNTY TAX MAP DEPARTMENT
 226 MIDDLE AVE. ELYRIA, OHIO

SURVEYED BY: TREVOR A. BIXLER
 CLOSURE: .01:10,000
 MAP PAGE(S): 2-02-010-B
 APPROVED BY: RRM DATE: 9-20-12
 SCALE: 1"= 100 PRIOR INST.: 20000676854