
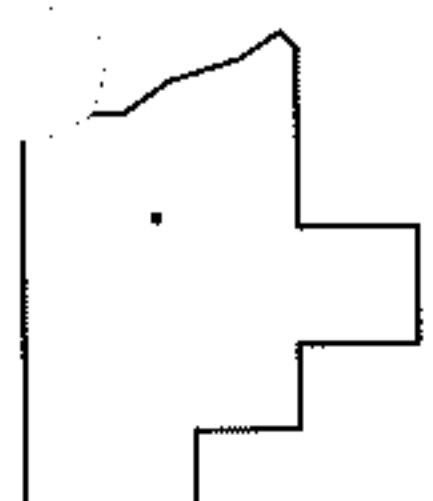
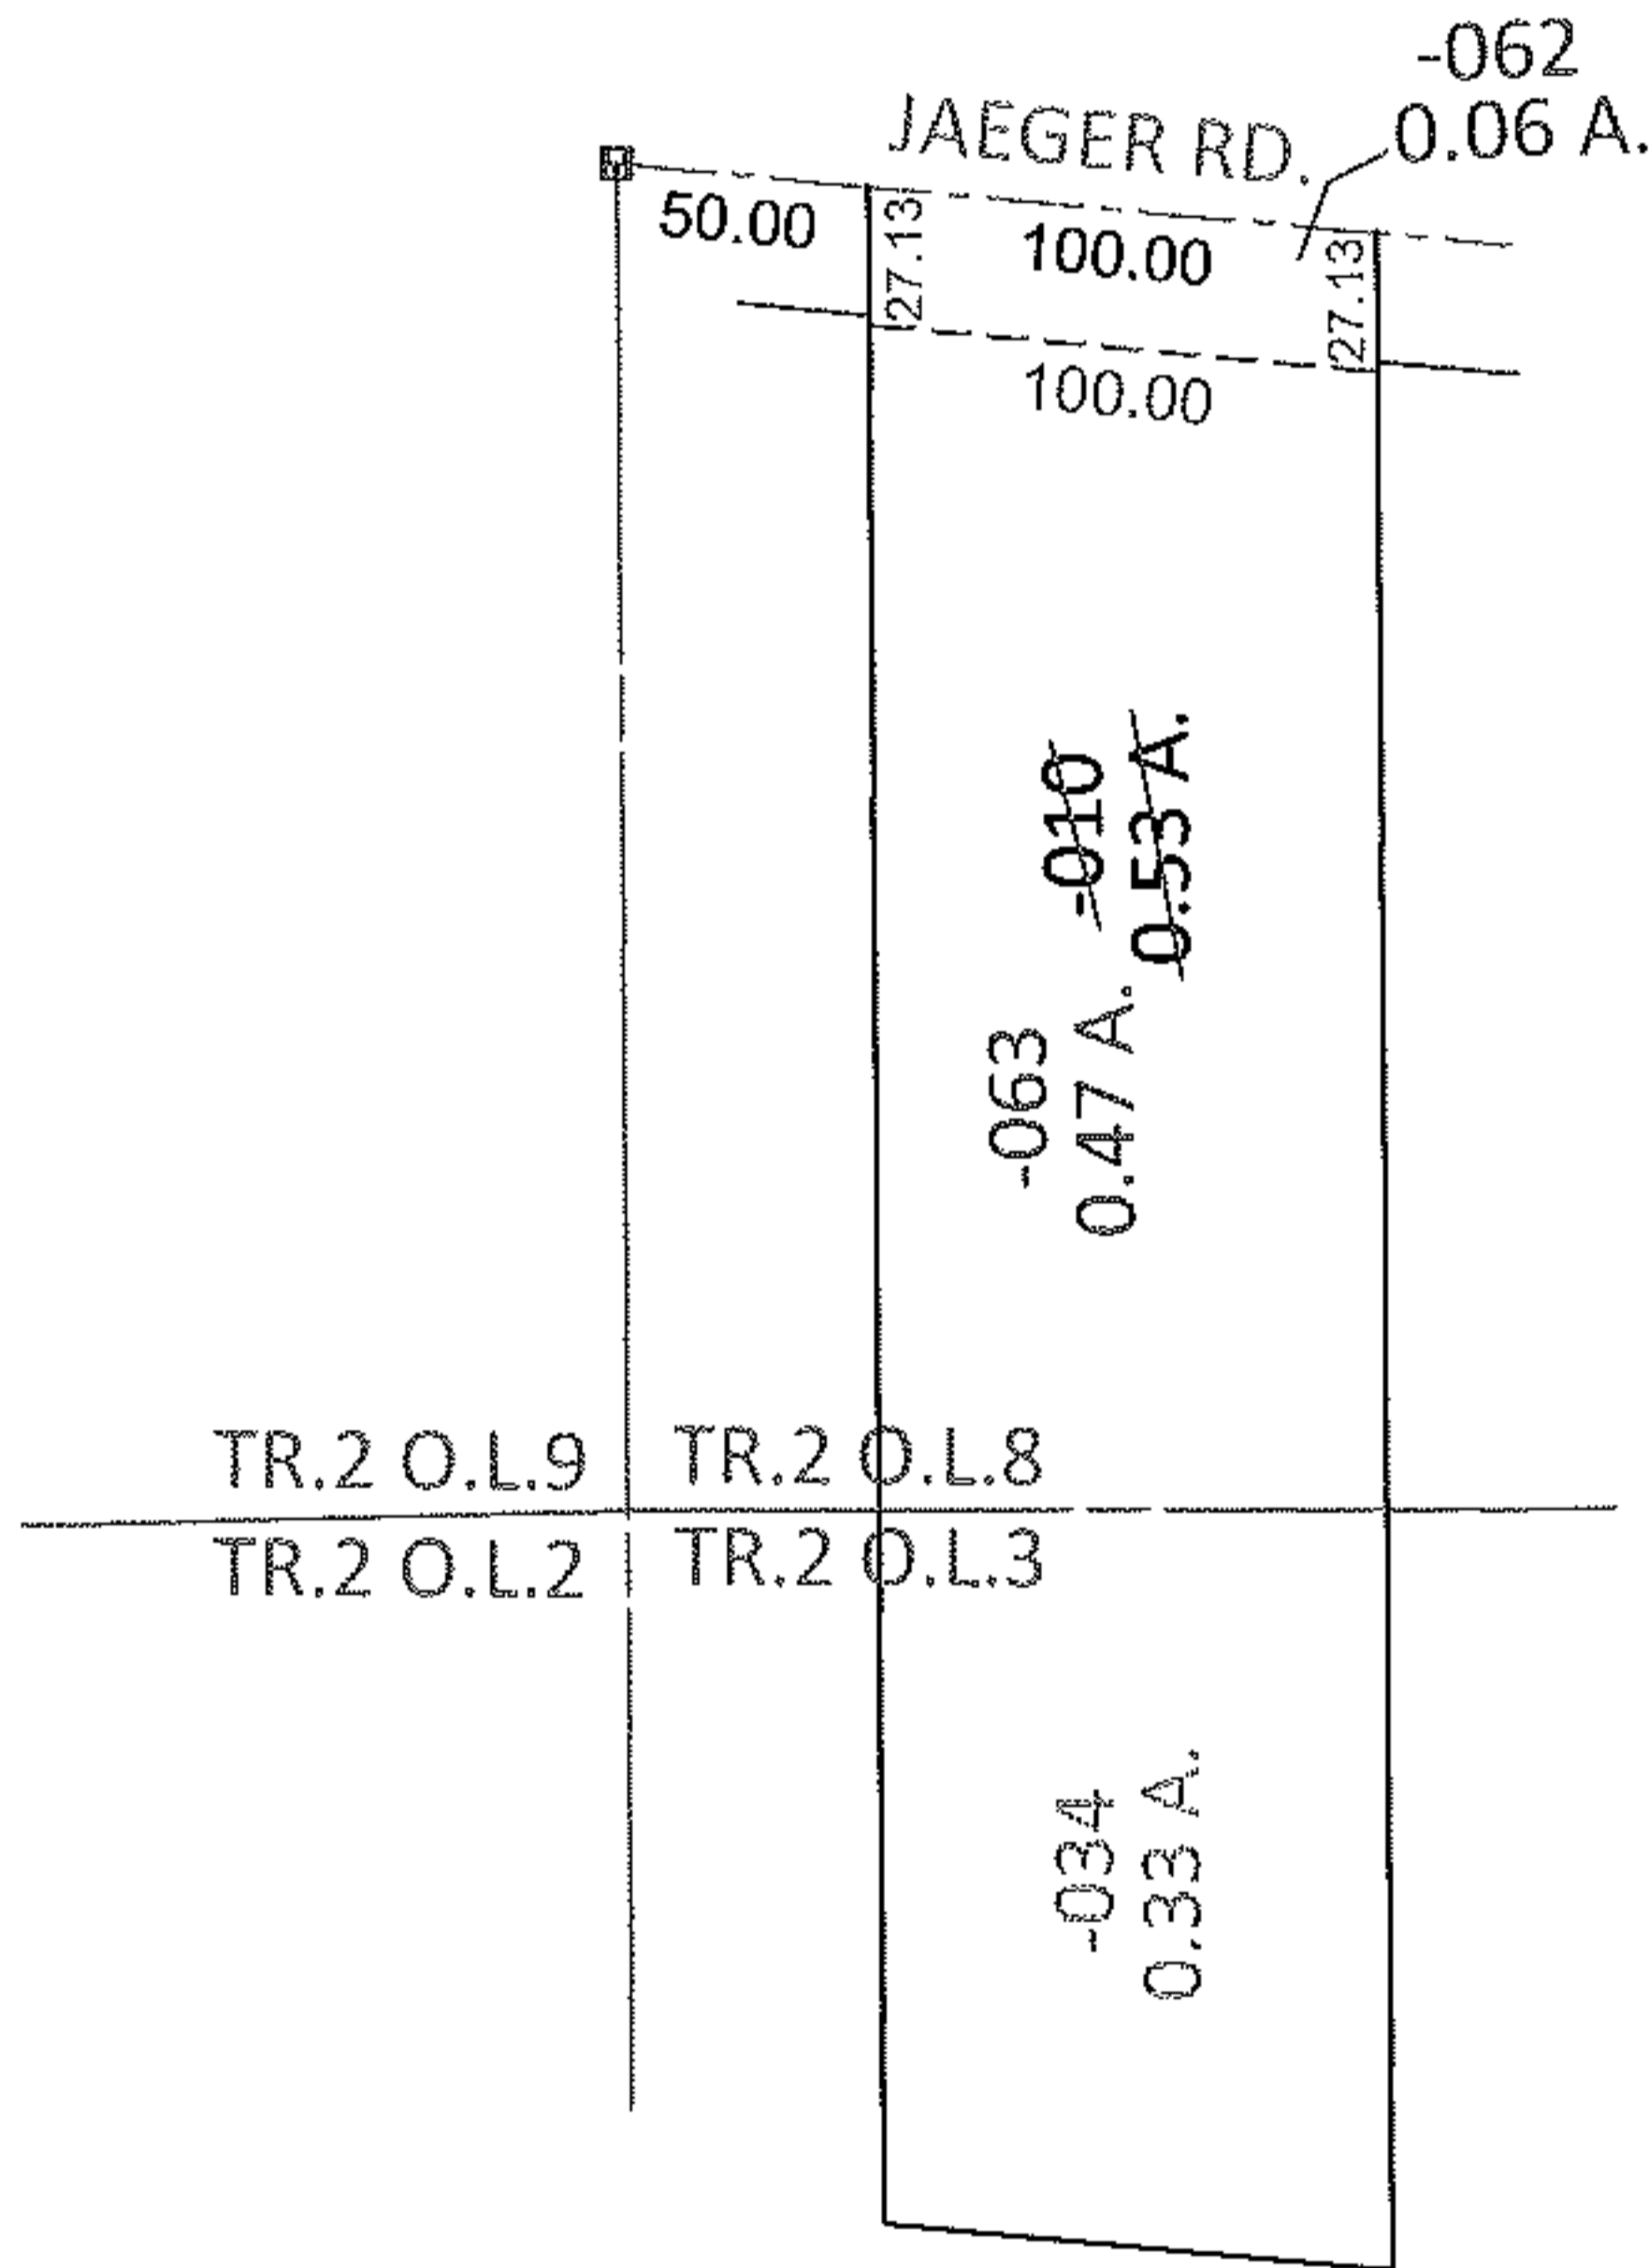


PARENT PARCEL: 02-02-008-107-010

CHILD PARCEL: 02-02-008-107-062, -063

12-00314

STARTING POINT: AT A MON BOX AT THE INTERSECTION OF C/L OF JAEGER RD. AND WEST LINE OF TR.2 O.L.8

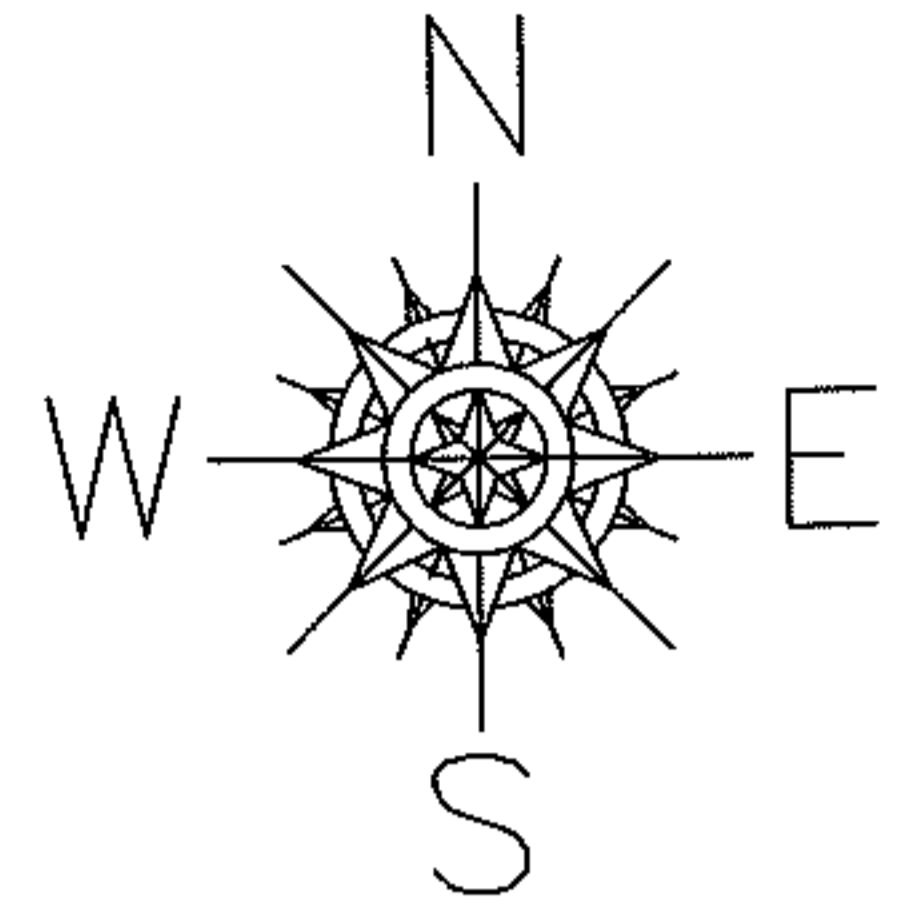

SPLITS/DEEDS PROCESSED

LORAIN COUNTY TAX MAP DEPARTMENT
226 MIDDLE AVE. ELYRIA, OHIO

SURVEYED BY: TREVOR A. BIXLER

CLOSURE: .00:10,000

MAP PAGE(S): 2-02-008-A

APPROVED BY: RRM DATE: 9-26-12

SCALE: 1"= 100 PRIOR INST.: 19980518531