



RASTER

PARENT PARCEL: 04-00-027-101-179

CHILD PARCEL: 04-00-027-101-183 & -184

STARTING POINT: MONUMENT, CL OF NAGEL RD. & N.W. CORNER OF SECTION 27

12-00315

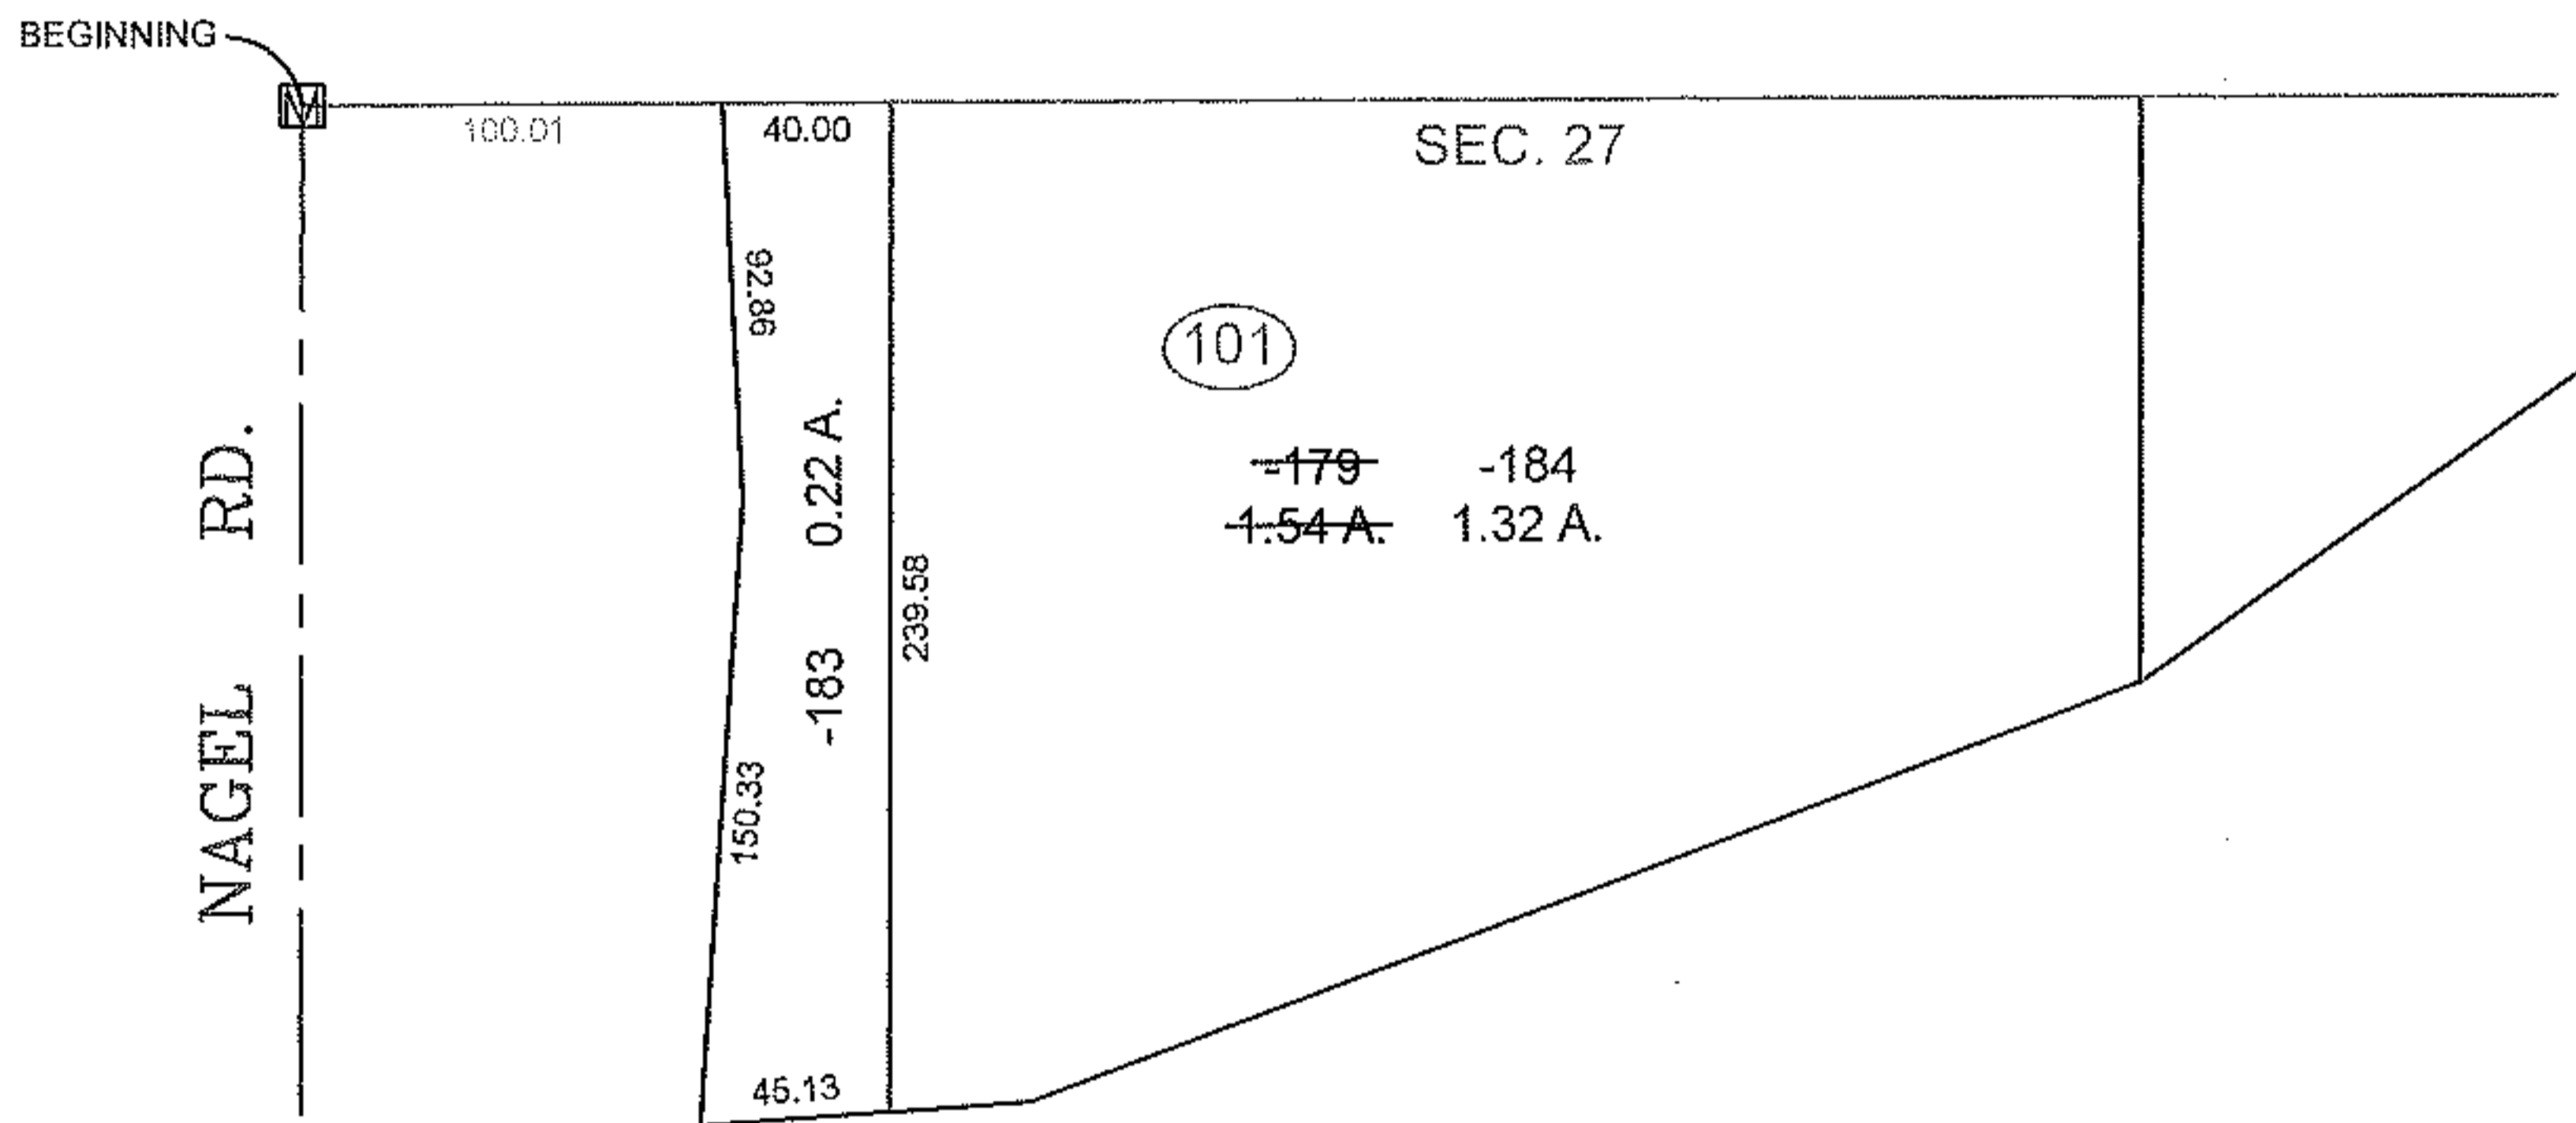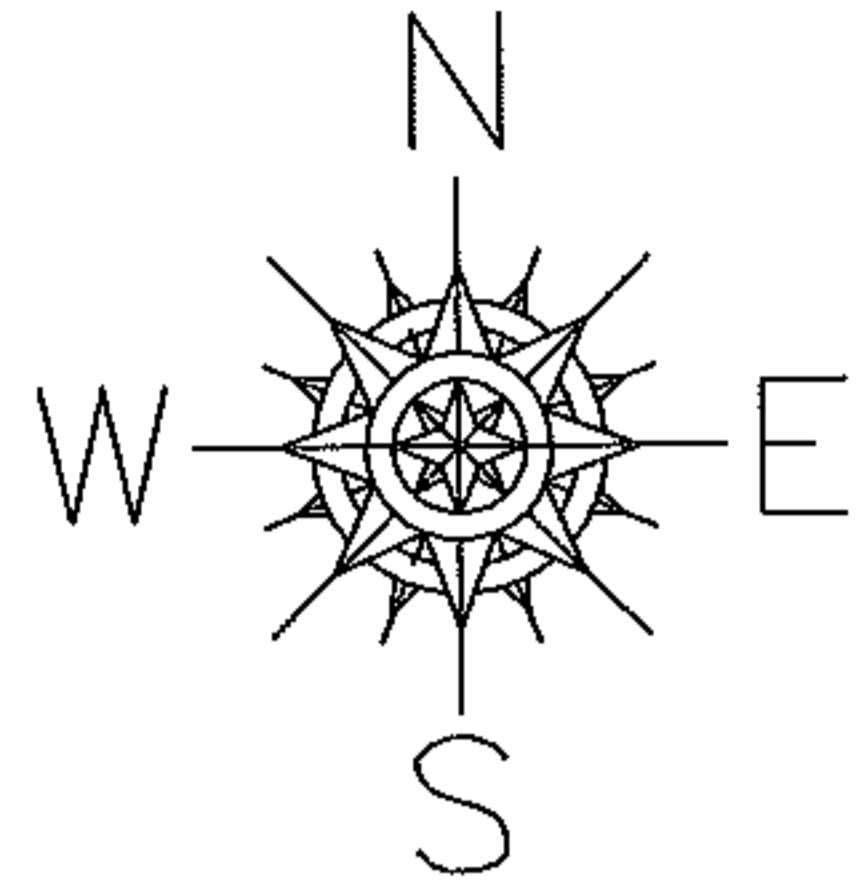

SPLITS/DEEDS PROCESSED

LORAIN COUNTY TAX MAP DEPARTMENT
226 MIDDLE AVE. ELYRIA, OHIO

SURVEYED BY: WILLIAM SALA
 CLOSURE: 0.01 : 10,000
 MAP PAGE(S): 4-00-027-A
 APPROVED BY: TJS DATE: 9/26/12
 SCALE: 1" = 100 PRIOR INSTRUMENT: 20080239738