
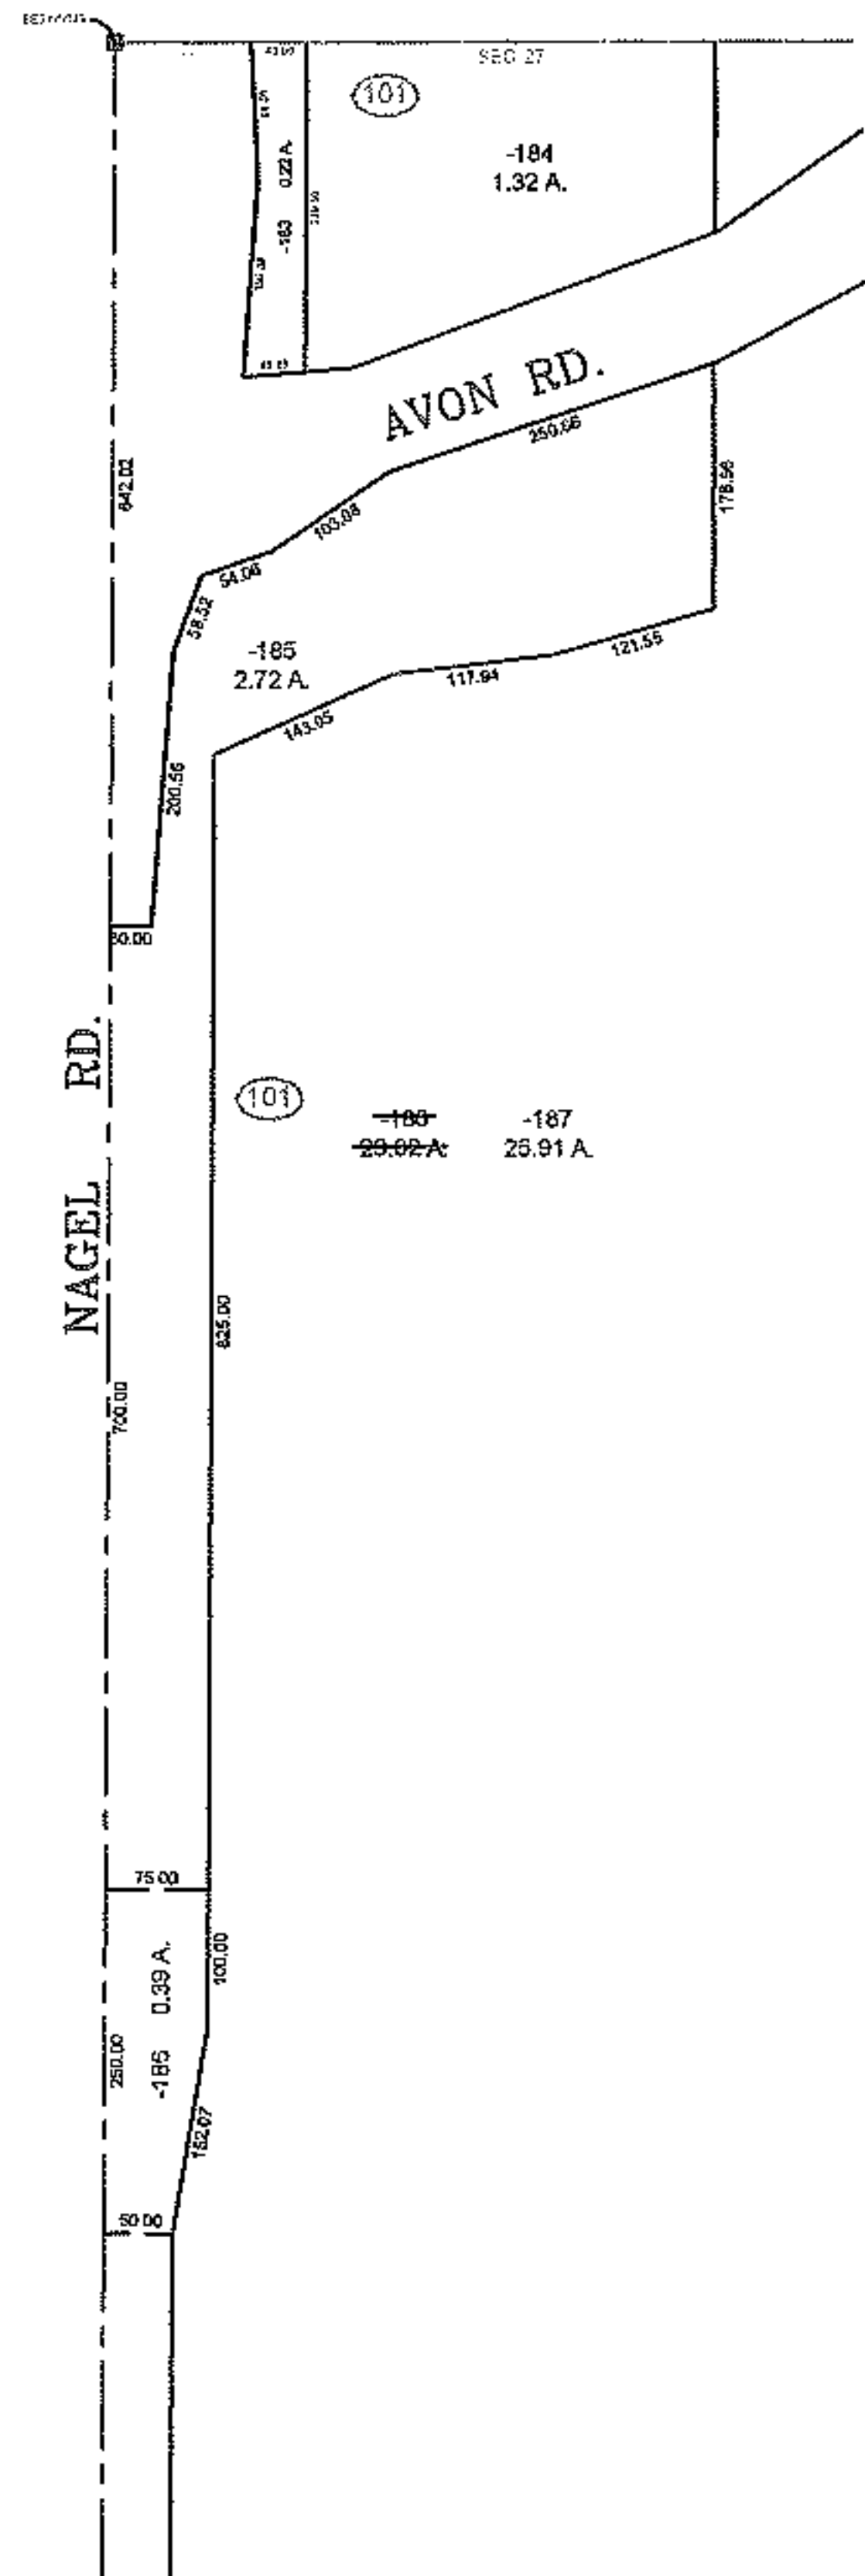


PARENT PARCEL: 04-00-027-101-180

CHILD PARCEL: 04-00-027-101-185 THRU -187

STARTING POINT: MON BOX, CL OF NAGEL RD. & N.W. CORNER OF SECTION 27

12-00316

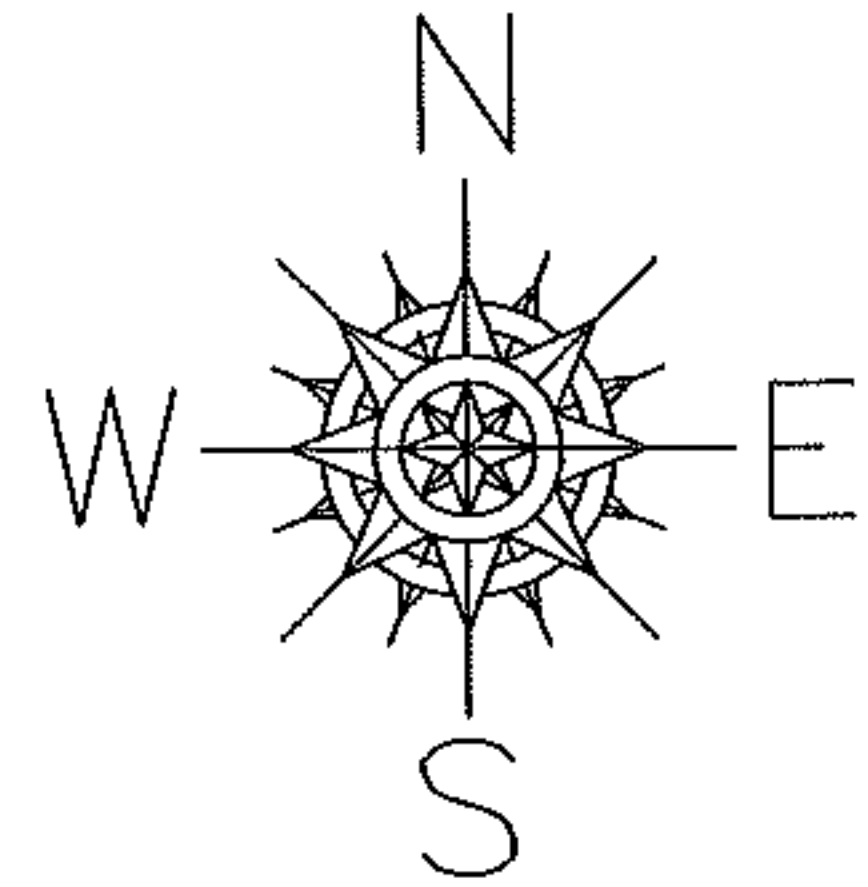

SPLITS/DEEDS PROCESSED  
LORAIN COUNTY TAX MAP DEPARTMENT  
226 MIDDLE AVE. ELYRIA, OHIO

SURVEYED BY: WILLIAM SALA  
CLOSURE: 0.01 : 10,000  
MAP PAGE(S): 4-00-027-A  
APPROVED BY: TJS DATE: 9/27/12  
SCALE: 1" = 300 PRIOR INSTRUMENT: 20080239739