


PARENT PARCEL: 03-00-001-700-006

CHILD PARCEL: 03-00-001-000-179, 03-00-001-700-007

STARTING POINT: AT A MON BOX AT THE INTERSECTION OF C/L OF S.R.301 AND C/L OF S.R. 254



12-00325

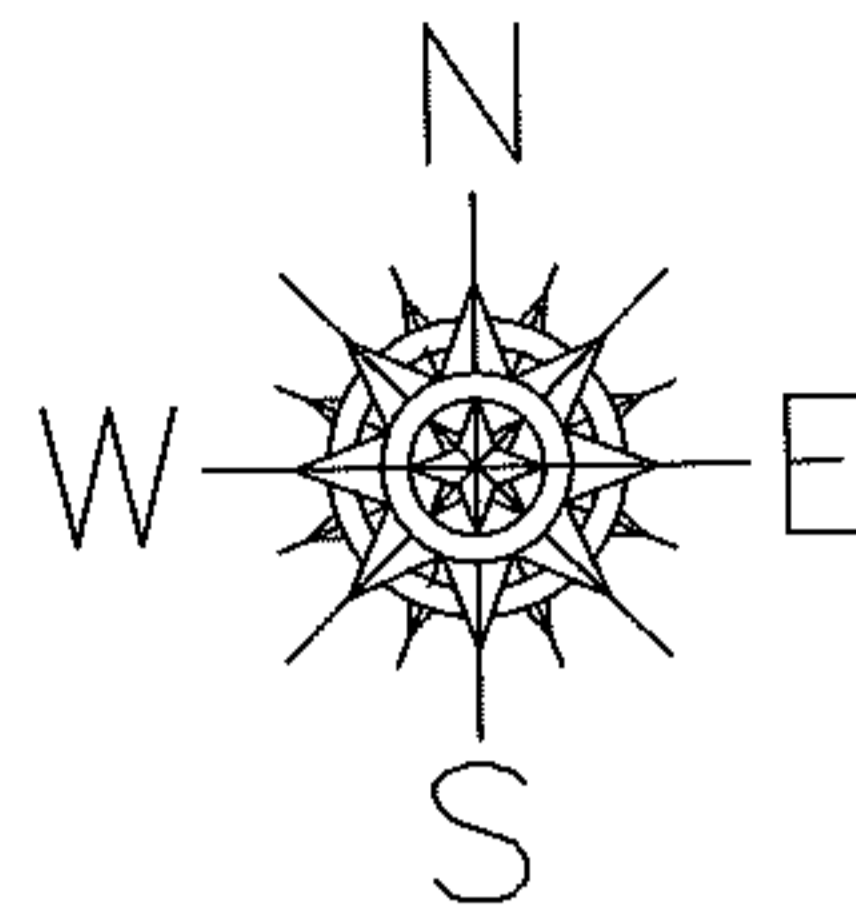

DETROIT RD. (S.R.254)

ABBE RD. (S.R. 301)

712.86

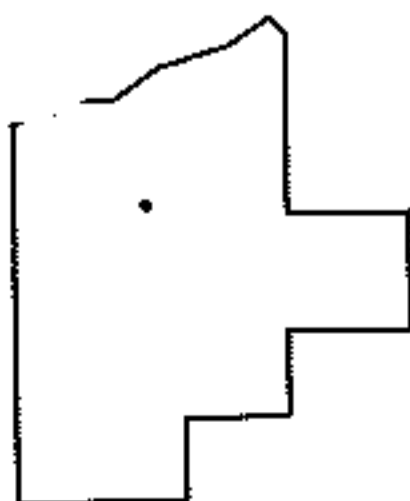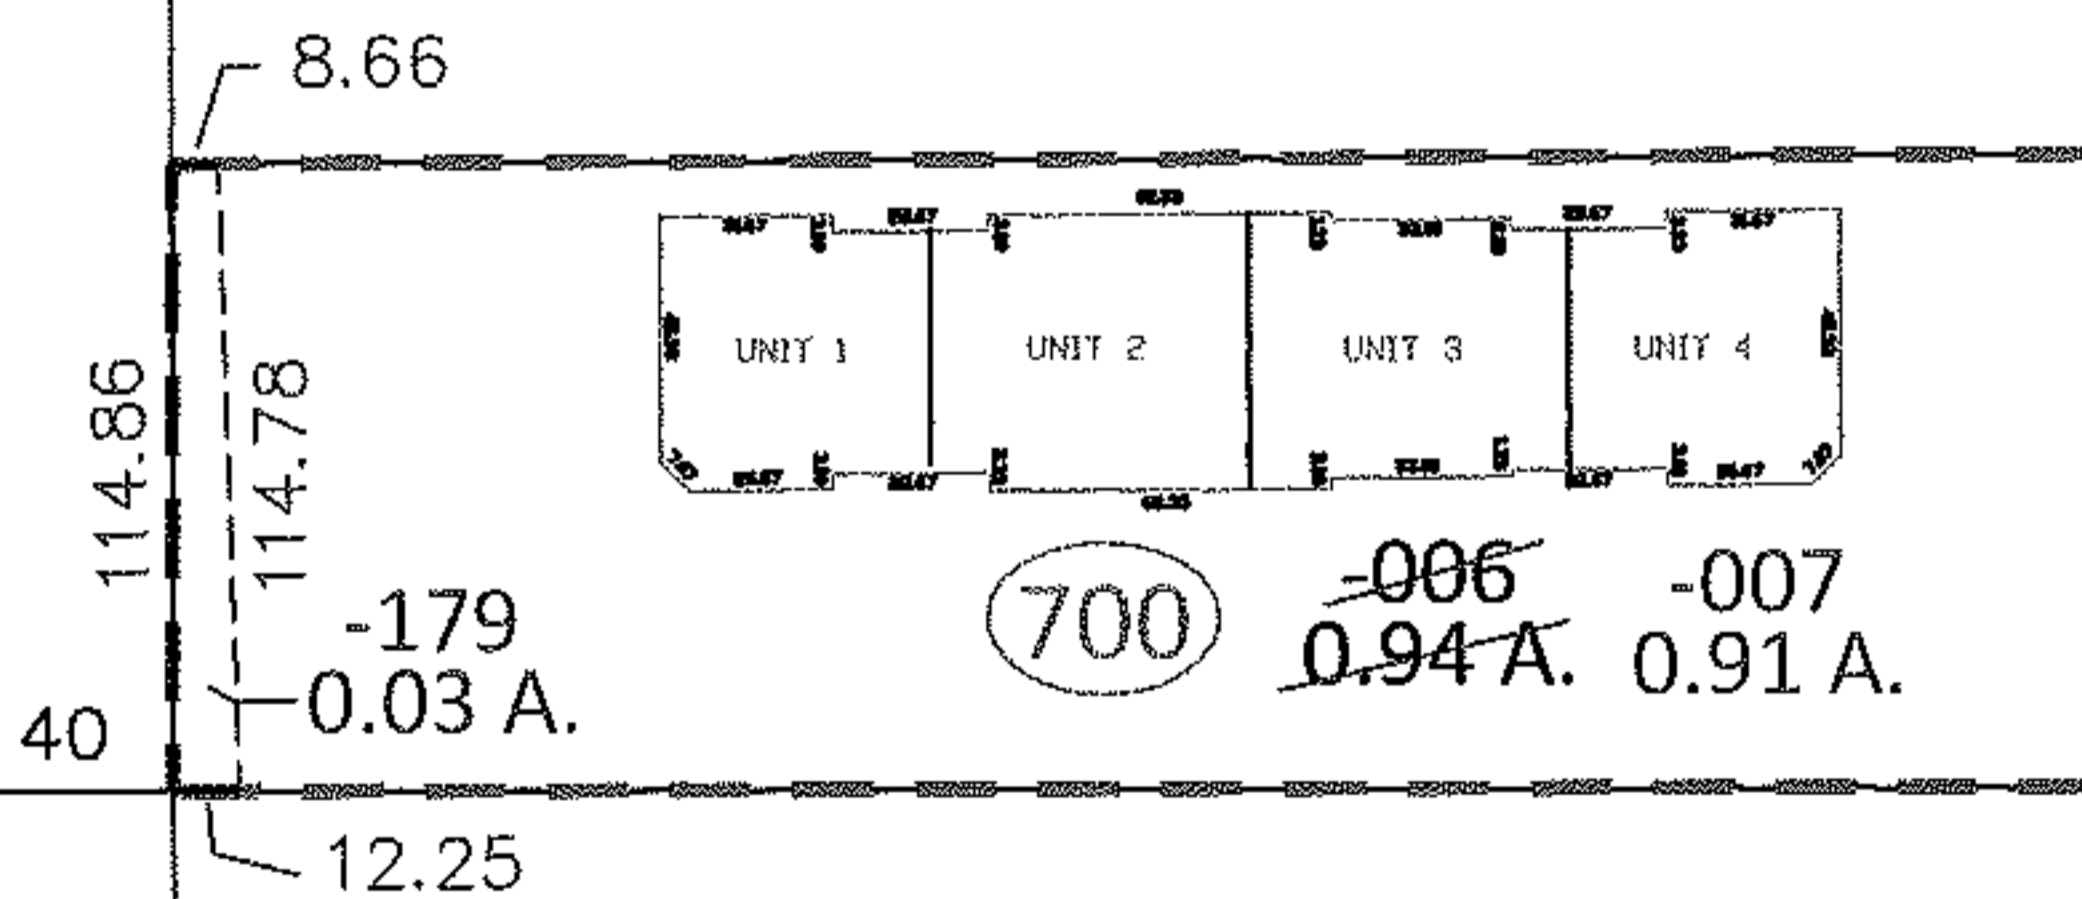

SPLITS/DEEDS PROCESSED

LORAIN COUNTY TAX MAP DEPARTMENT
226 MIDDLE AVE. ELYRIA, OHIO

SURVEYED BY: RICHARD JOHN SWAN

CLOSURE: .01:10,000

MAP PAGE(S): 3-00-001-A

APPROVED BY: RRM DATE: 10-9-12

SCALE: 1"= 100 PRIOR INST.: 20070204185