


PARENT PARCEL: 02-03-005-103-001

CHILD PARCEL: 02-03-005-103-003, -004

STARTING POINT: AT A MON BOX AT THE INTERSECTION OF C/L OF KOLBE RD. AND C/L OF JAEGER RD.

12-00334

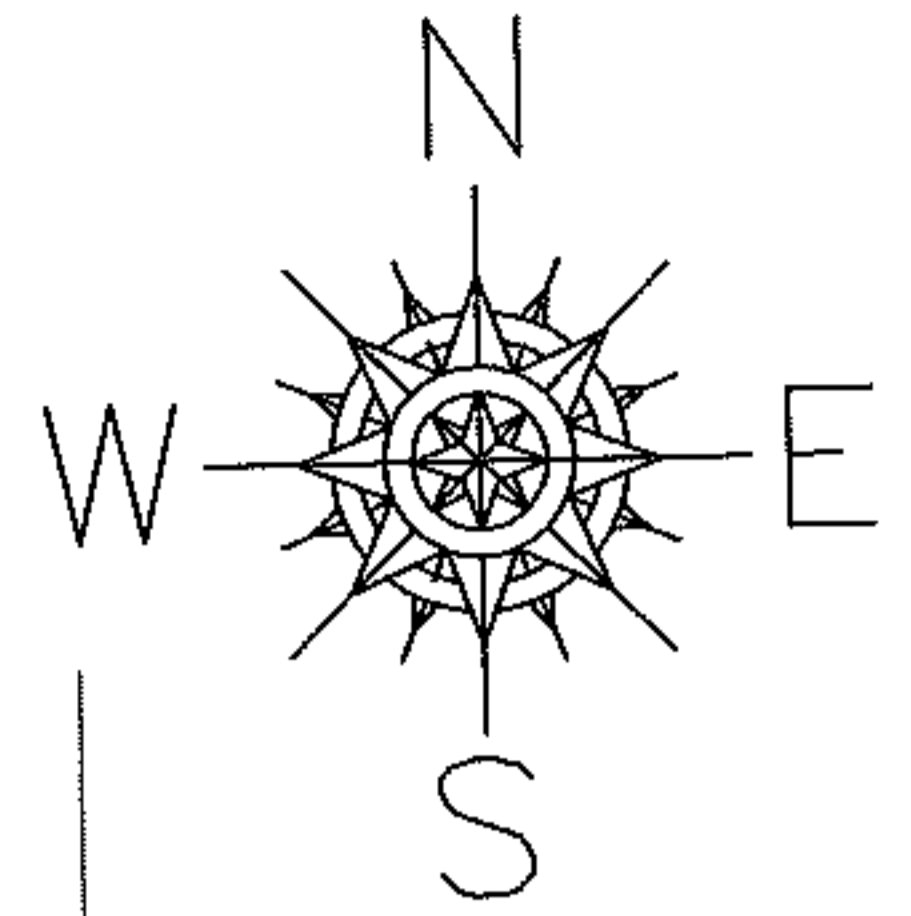

-004  
57.44 A.

~~-001~~  
~~57.66 A.~~

TR.3 O.L.5

TR.2 O.L.10

KOLBE RD.


L=276.63  
R=580

0.22 A.

JAEGER RD.

10.69  
46.44  
31.54  
10.54

9.02  
94  
21

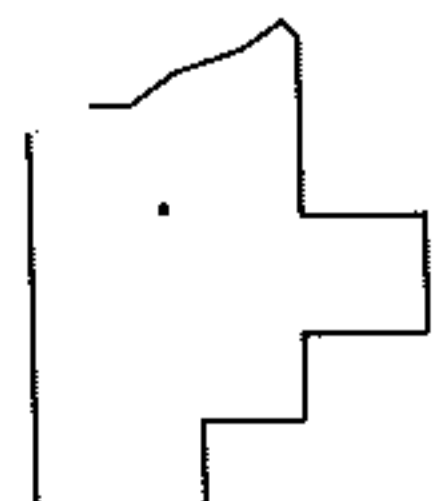

SPLITS/DEEDS PROCESSED

LORAIN COUNTY TAX MAP DEPARTMENT  
226 MIDDLE AVE. ELYRIA, OHIO

SURVEYED BY: TREVOR A. BIXLER

CLOSURE: .01:10,000

MAP PAGE(S): 2-03-005-B

APPROVED BY: RRM DATE: 11-2-12

SCALE: 1"=100 PRIOR INST.: 20000711952