
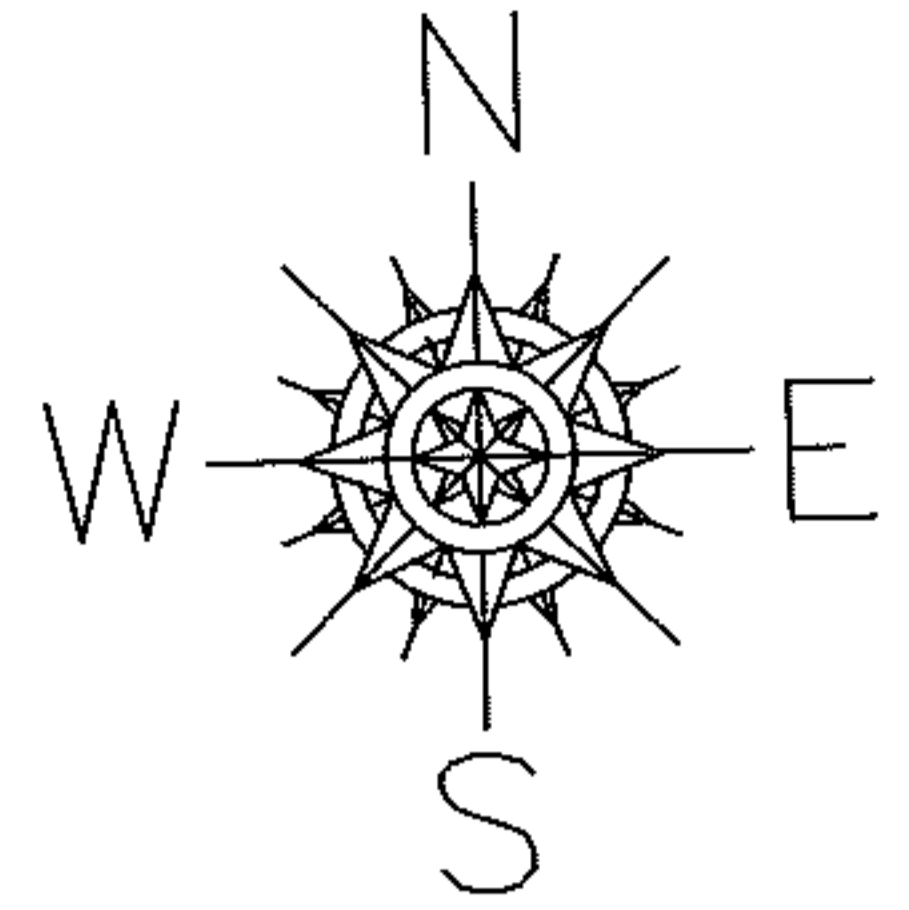


PARENT PARCEL: 03-00-001-000-130

CHILD PARCEL: 03-00-001-000-182, -183

12-00346

STARTING POINT: AT A MON BOX AT THE INTERSECTION OF C/L OF ABBE RD. AND SOUTH LINE OF O.L.1

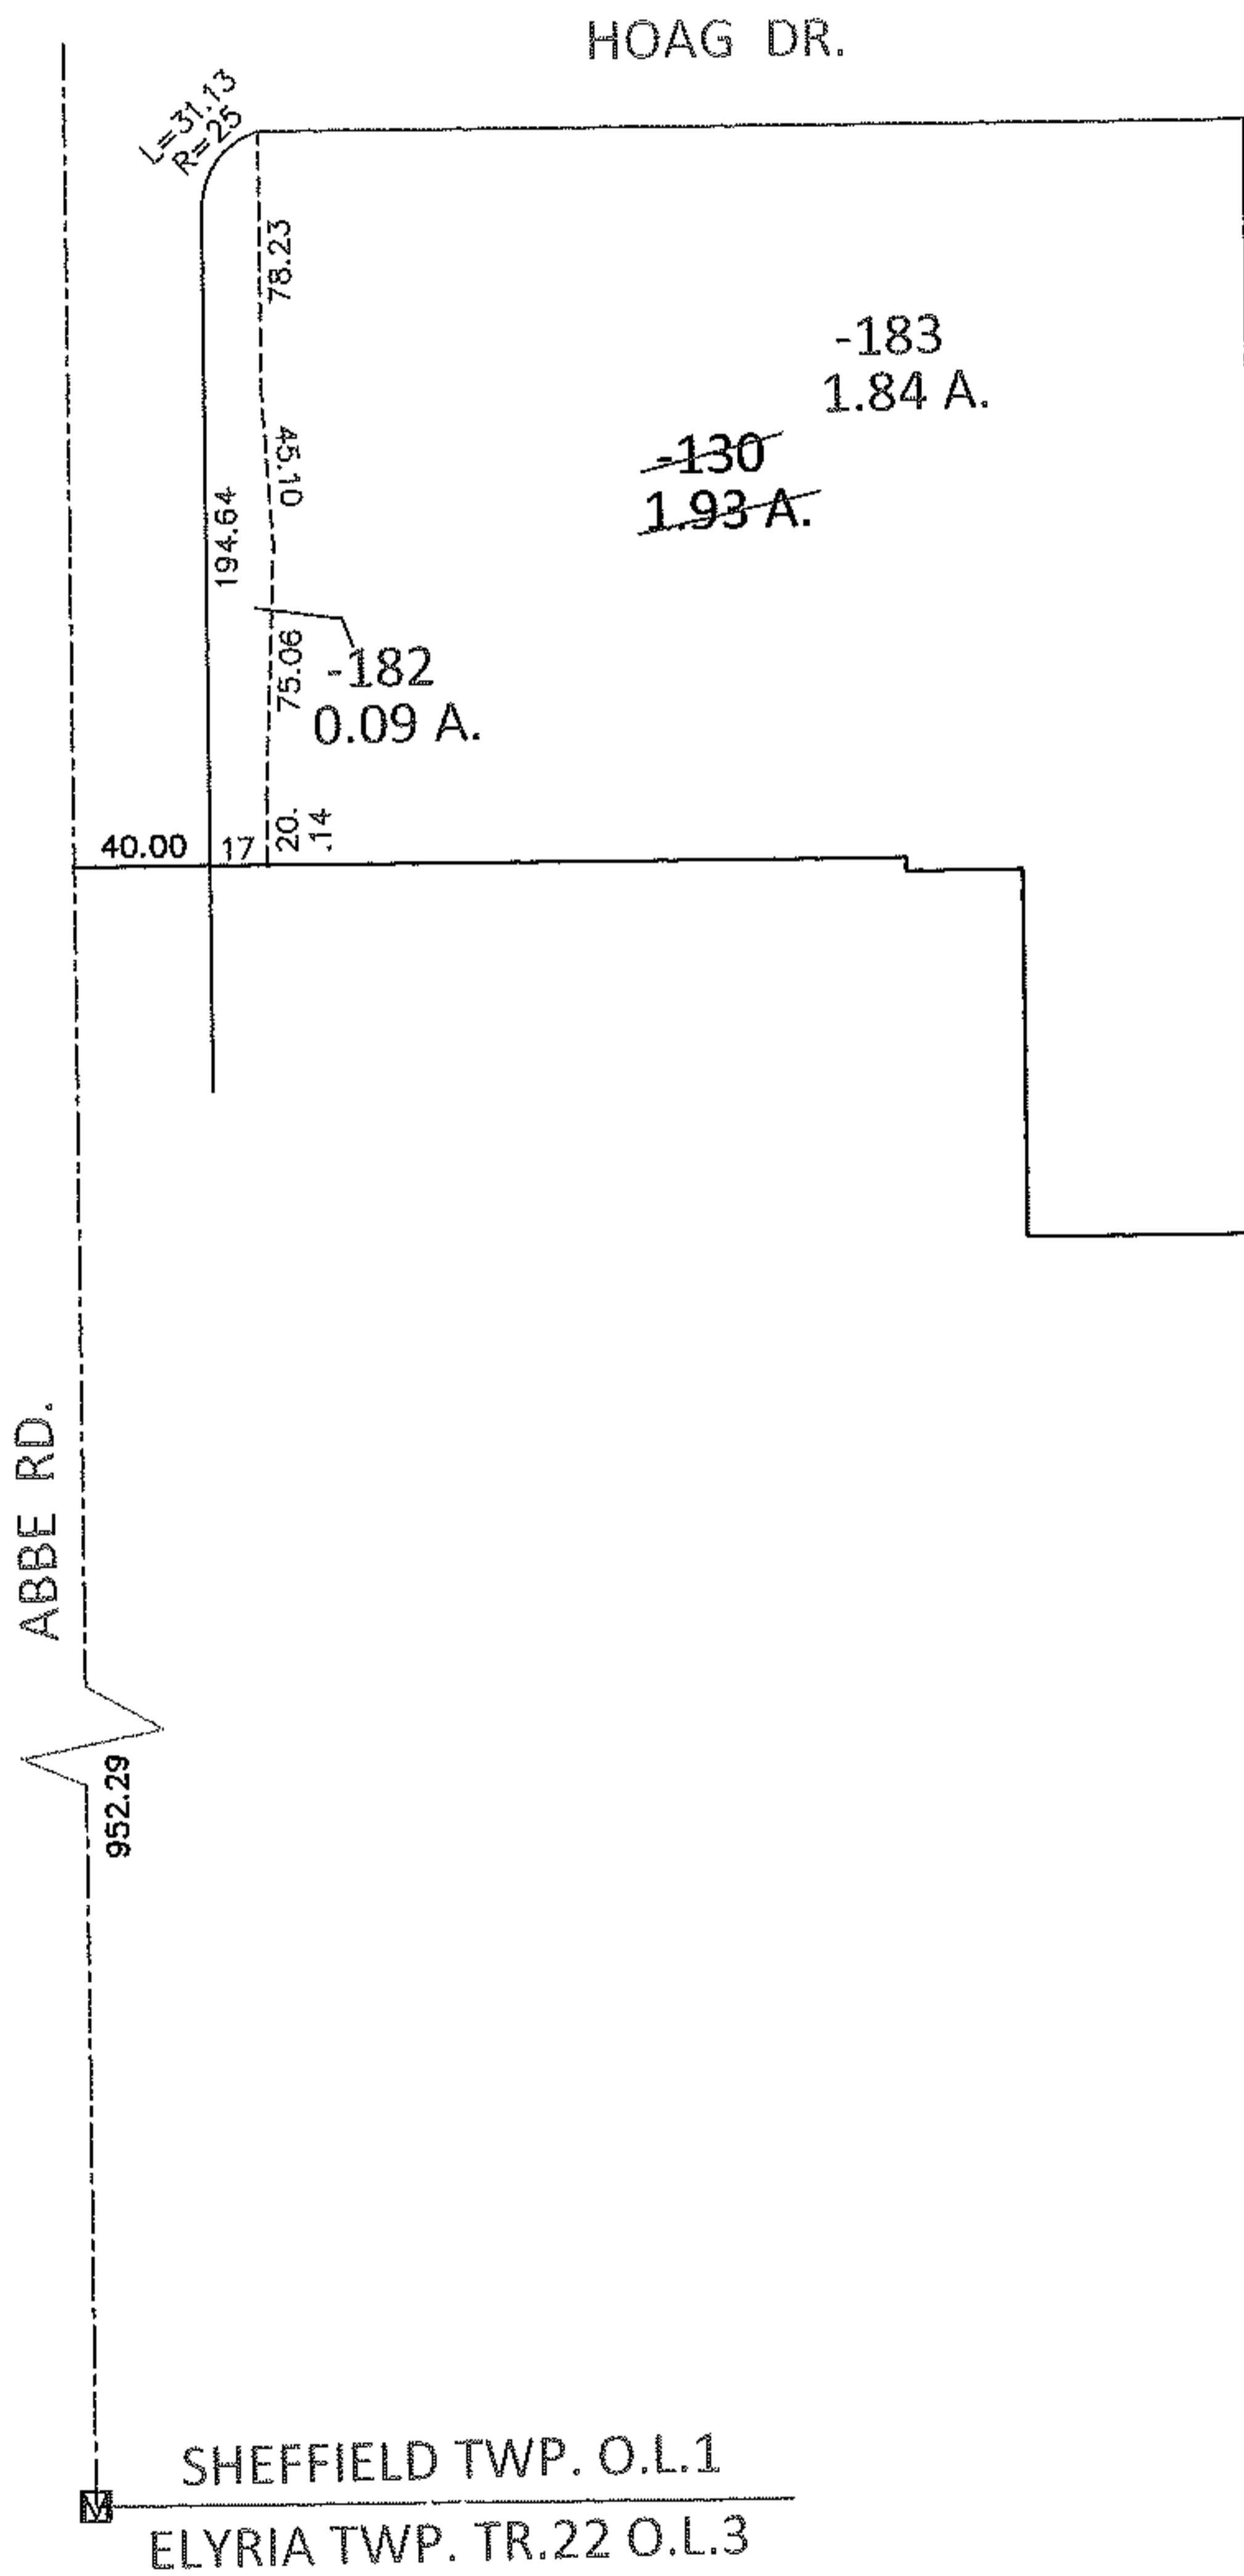

SPLITS/DEEDS PROCESSED

LORAIN COUNTY TAX MAP DEPARTMENT
226 MIDDLE AVE. ELYRIA, OHIO

SURVEYED BY: RICHARD JOHN SWAN

CLOSURE: .01:10,000

MAP PAGE(S): 3-00-001-A

APPROVED BY: RRM DATE: 11-7-12

SCALE: 1"= 100 PRIOR INST.: 19950341414