


PARENT PARCEL: 03-00-001-000-136

CHILD PARCEL: 03-00-001-000-184, -185



12-00347

ARTING POINT: AT A MON BOX AT THE INTERSECTION OF C/L OF ABBE RD. AND C/L OF S.R. 254

DETROIT RD. (S.R.254)

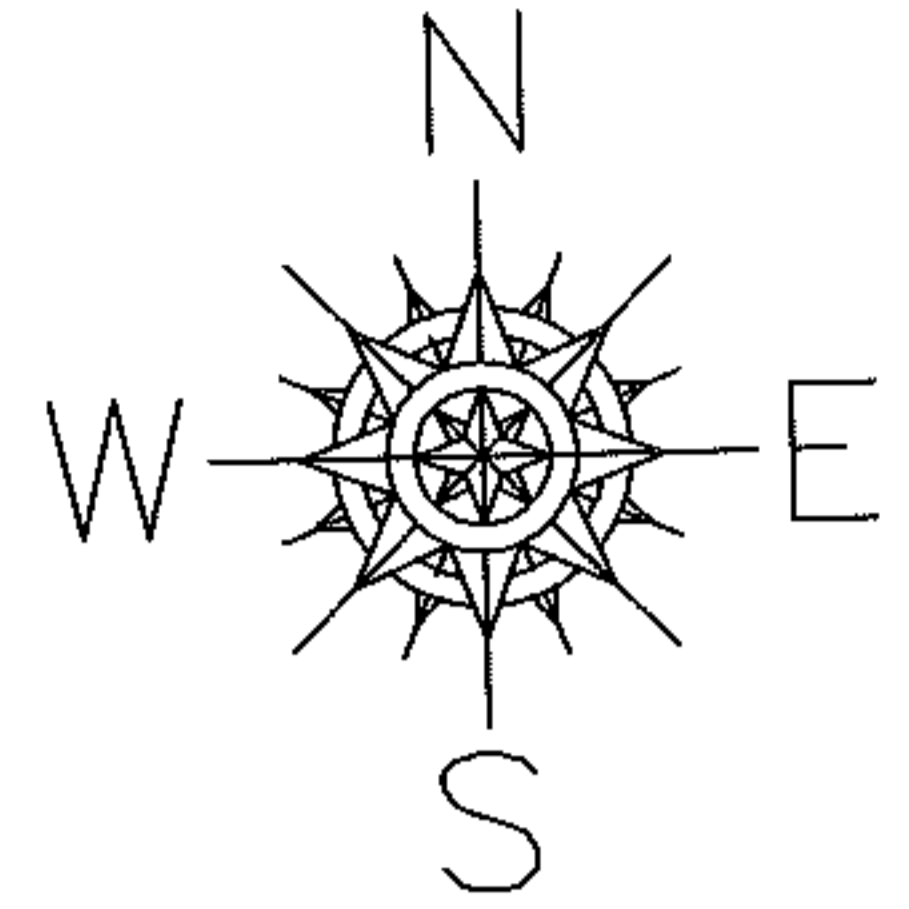

ABBE RD.
1057.36

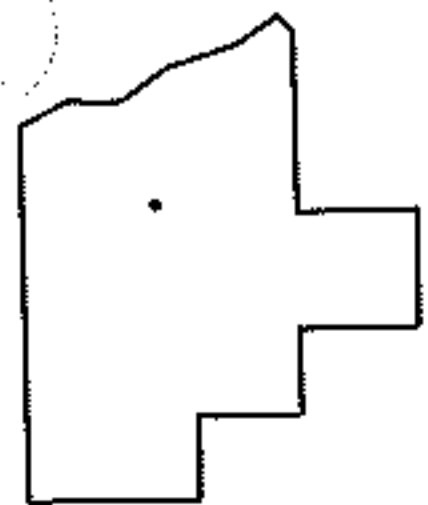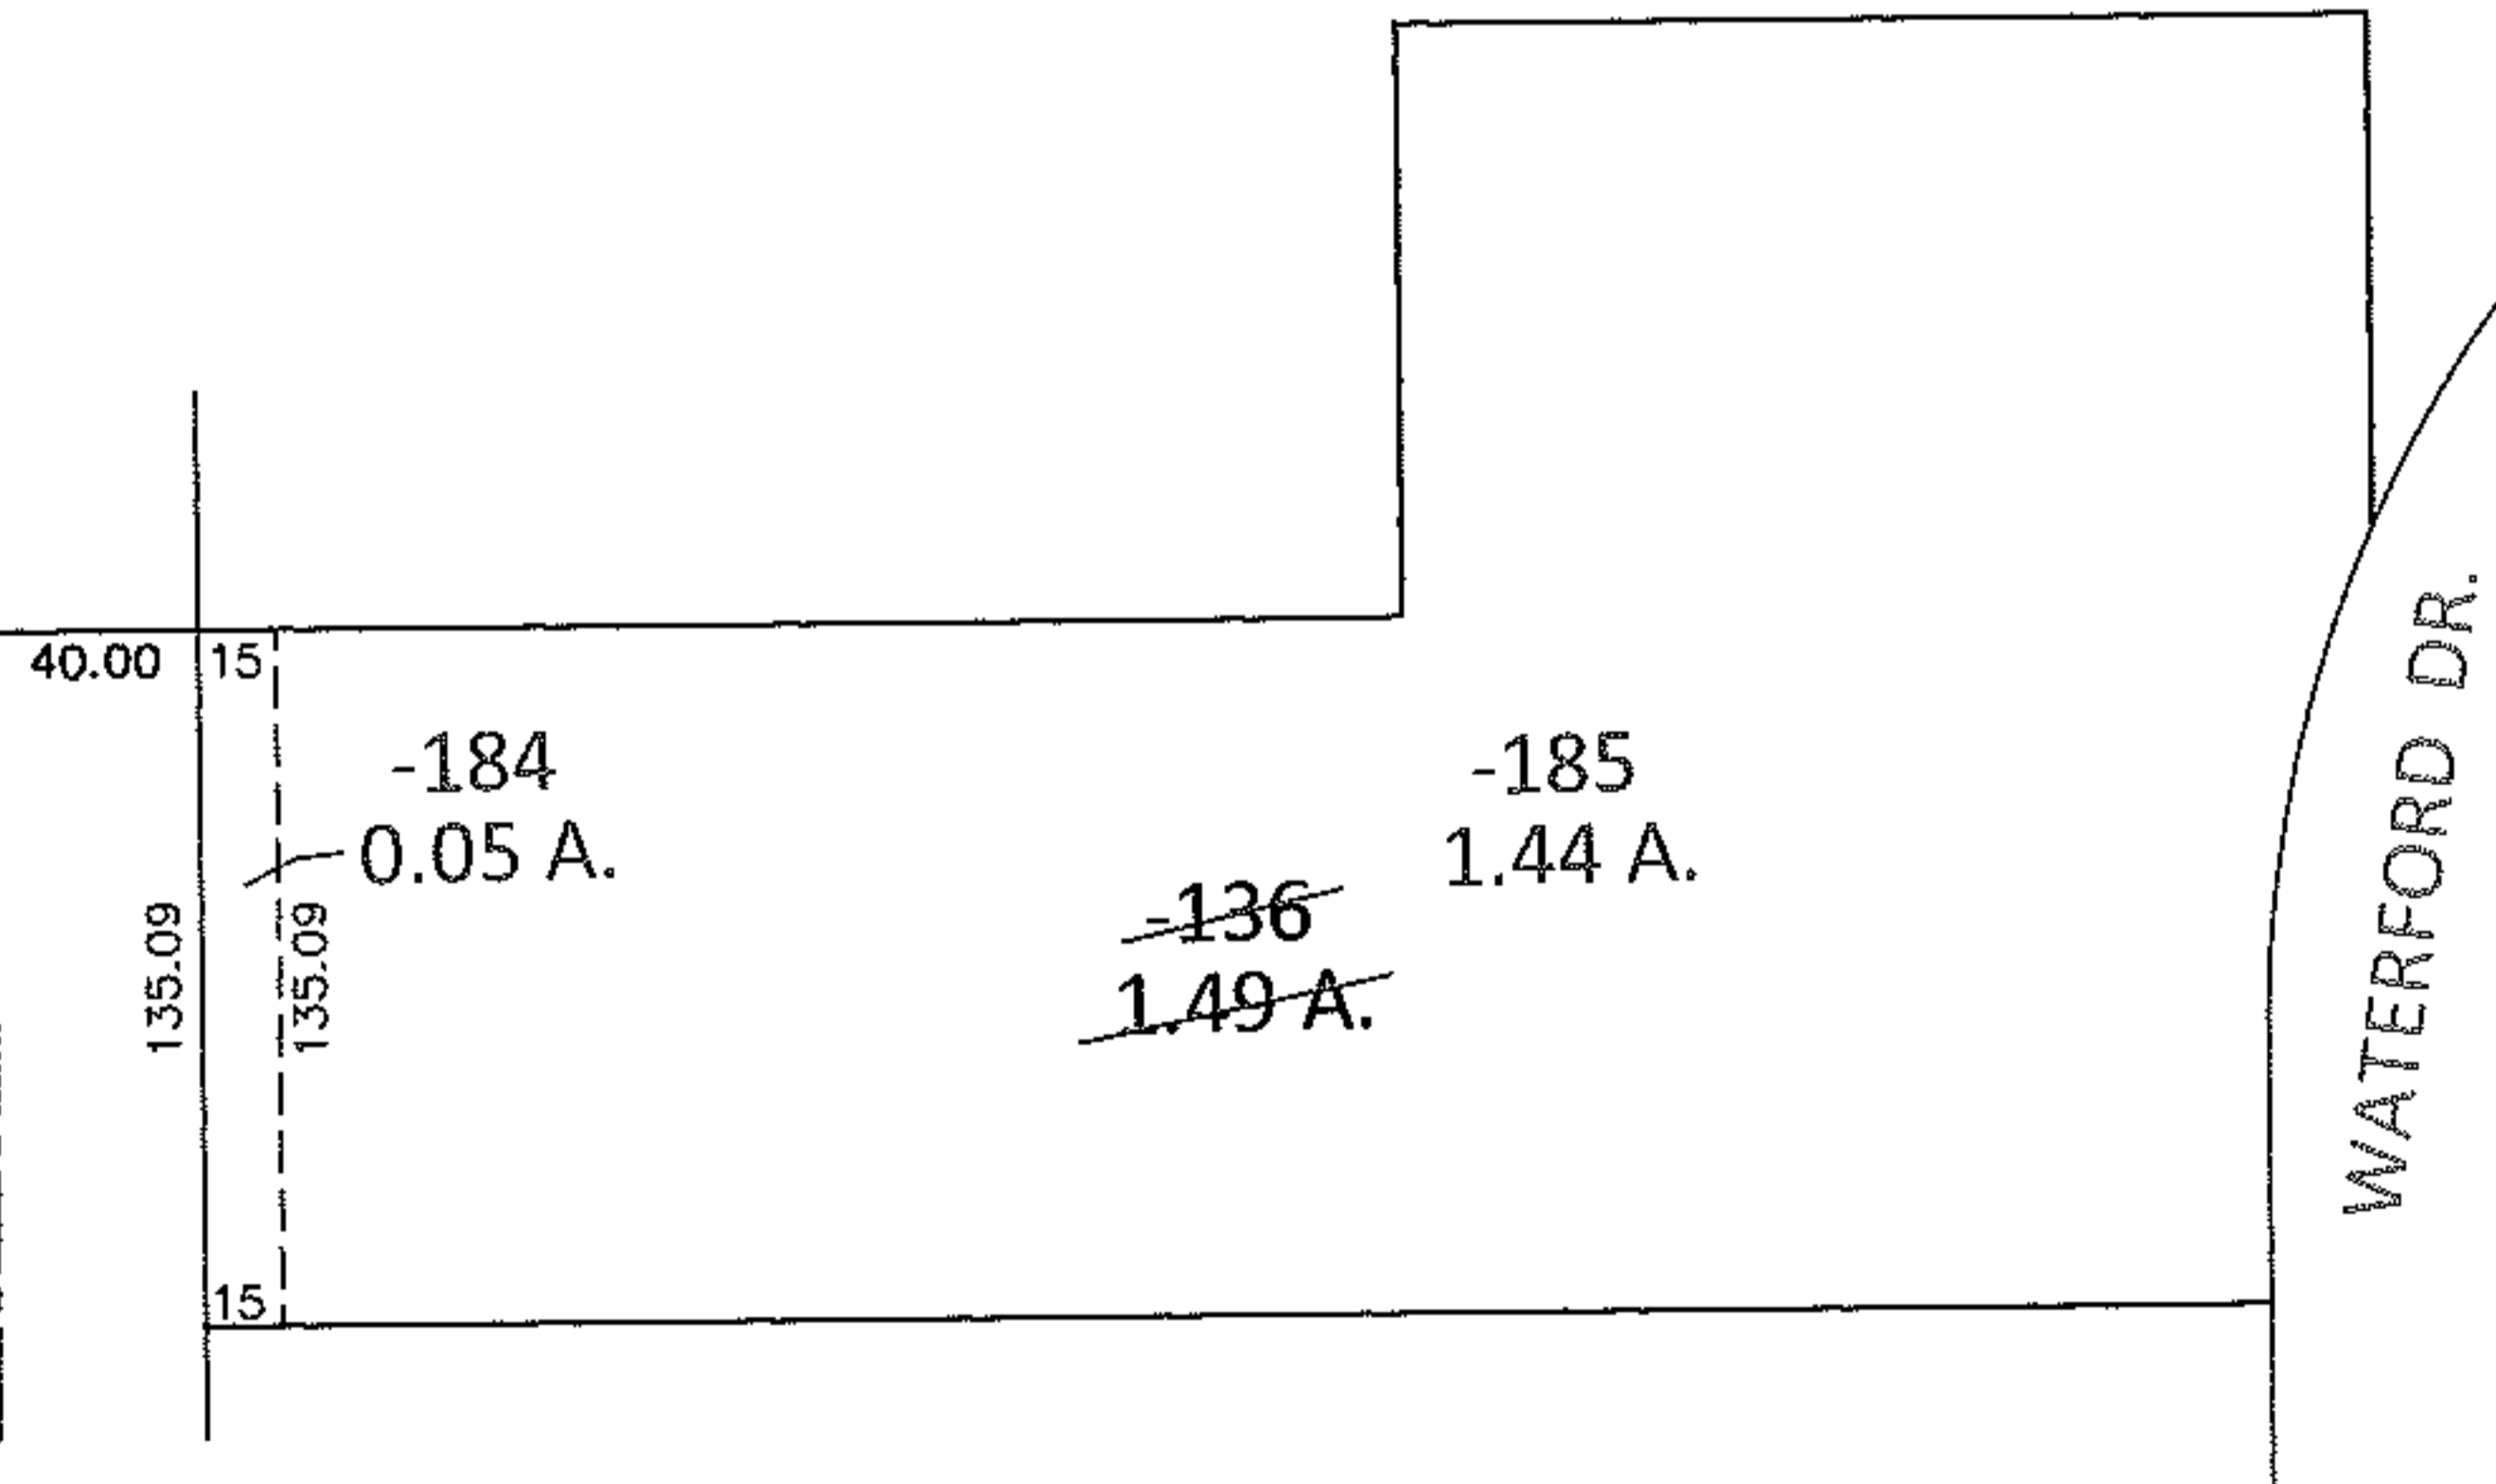

SPLITS/DEEDS PROCESSED

LORAIN COUNTY TAX MAP DEPARTMENT
226 MIDDLE AVE. ELYRIA, OHIO

SURVEYED BY: RICHARD JOHN SWAN

CLOSURE: .00:10,000

MAP PAGE(S): 3-00-001-A

APPROVED BY: RRM DATE: 11-8-12

SCALE: 1"= 100 PRIOR INST.: 20090320144