


PARENT PARCEL: 03-00-001-000-032

CHILD PARCEL: 03-00-001-000-186, -187

ARTING POINT: AT A MON BOX AT THE INTERSECTION OF C/L OF ABBE RD. AND C/L OF S.R.254



12-00348

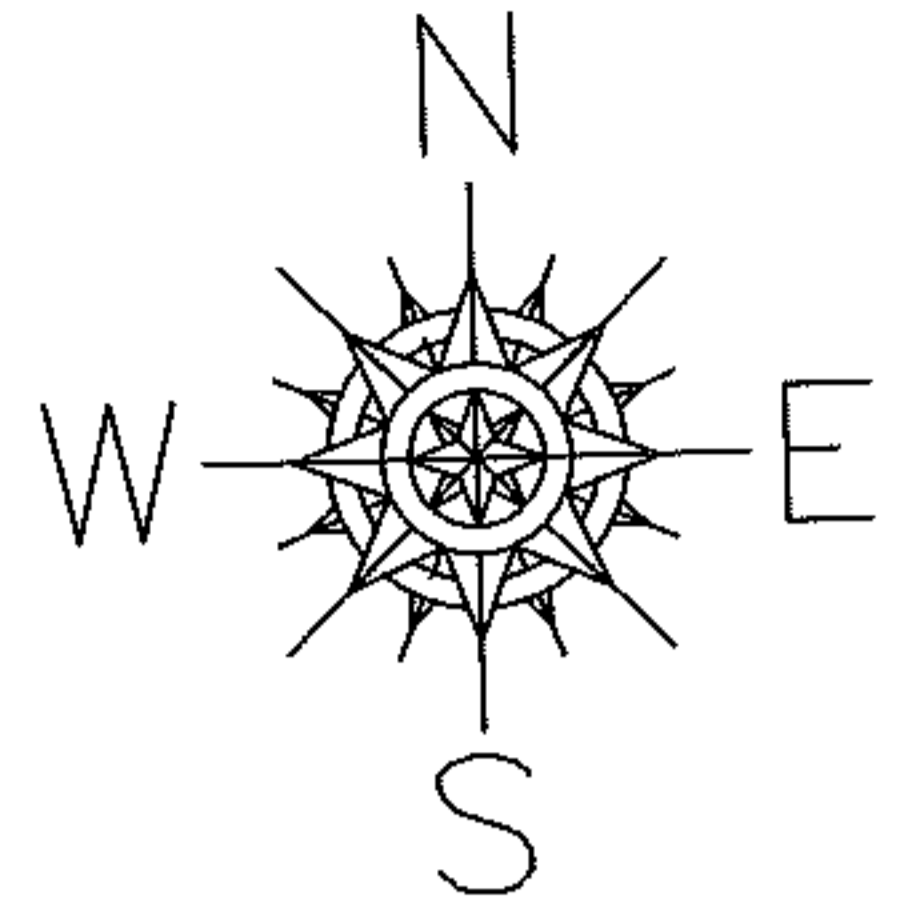

DETROIT RD. (S.R.254)

ABBE RD.

1057.36

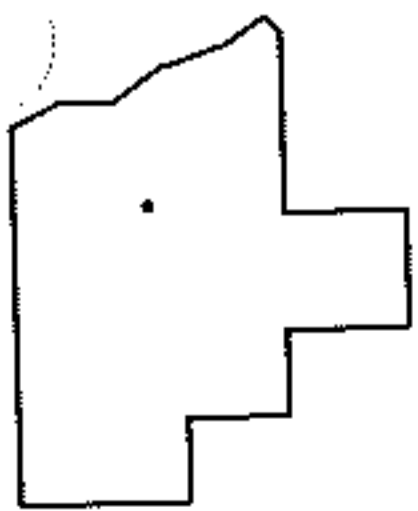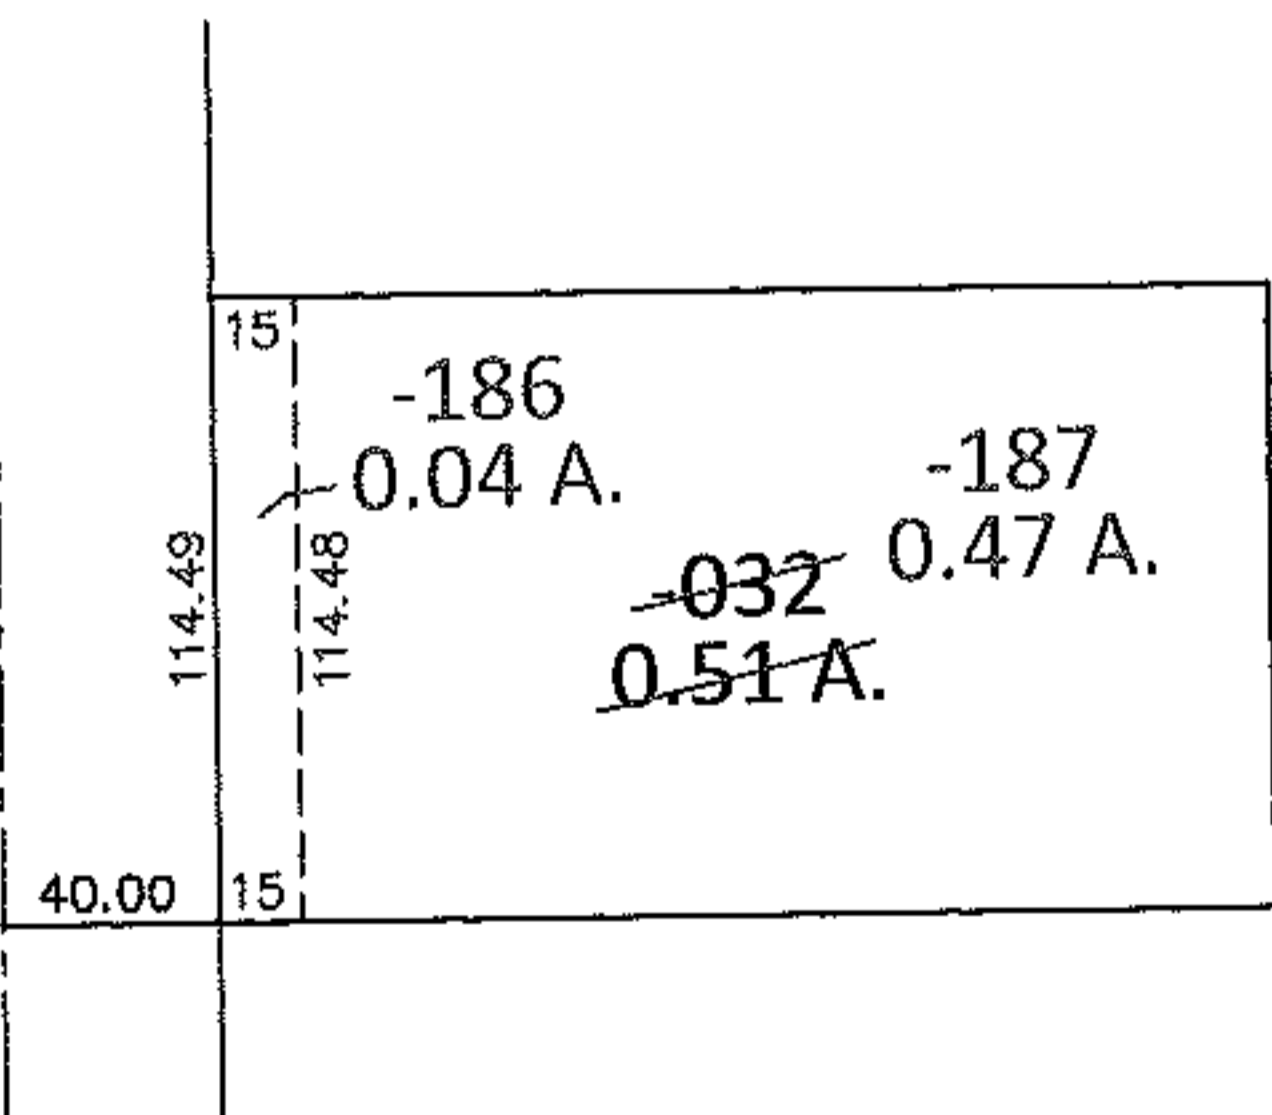

**SPLITS/DEEDS PROCESSED**

LORAIN COUNTY TAX MAP DEPARTMENT  
226 MIDDLE AVE. ELYRIA, OHIO

SURVEYED BY: RICHARD JOHN SWAN  
 CLOSURE: .00:10,000  
 MAP PAGE(S): 3-00-001-A  
 APPROVED BY: RRM DATE: 11-8-12  
 SCALE: 1"= 100 PRIOR INST.: 20090286462