
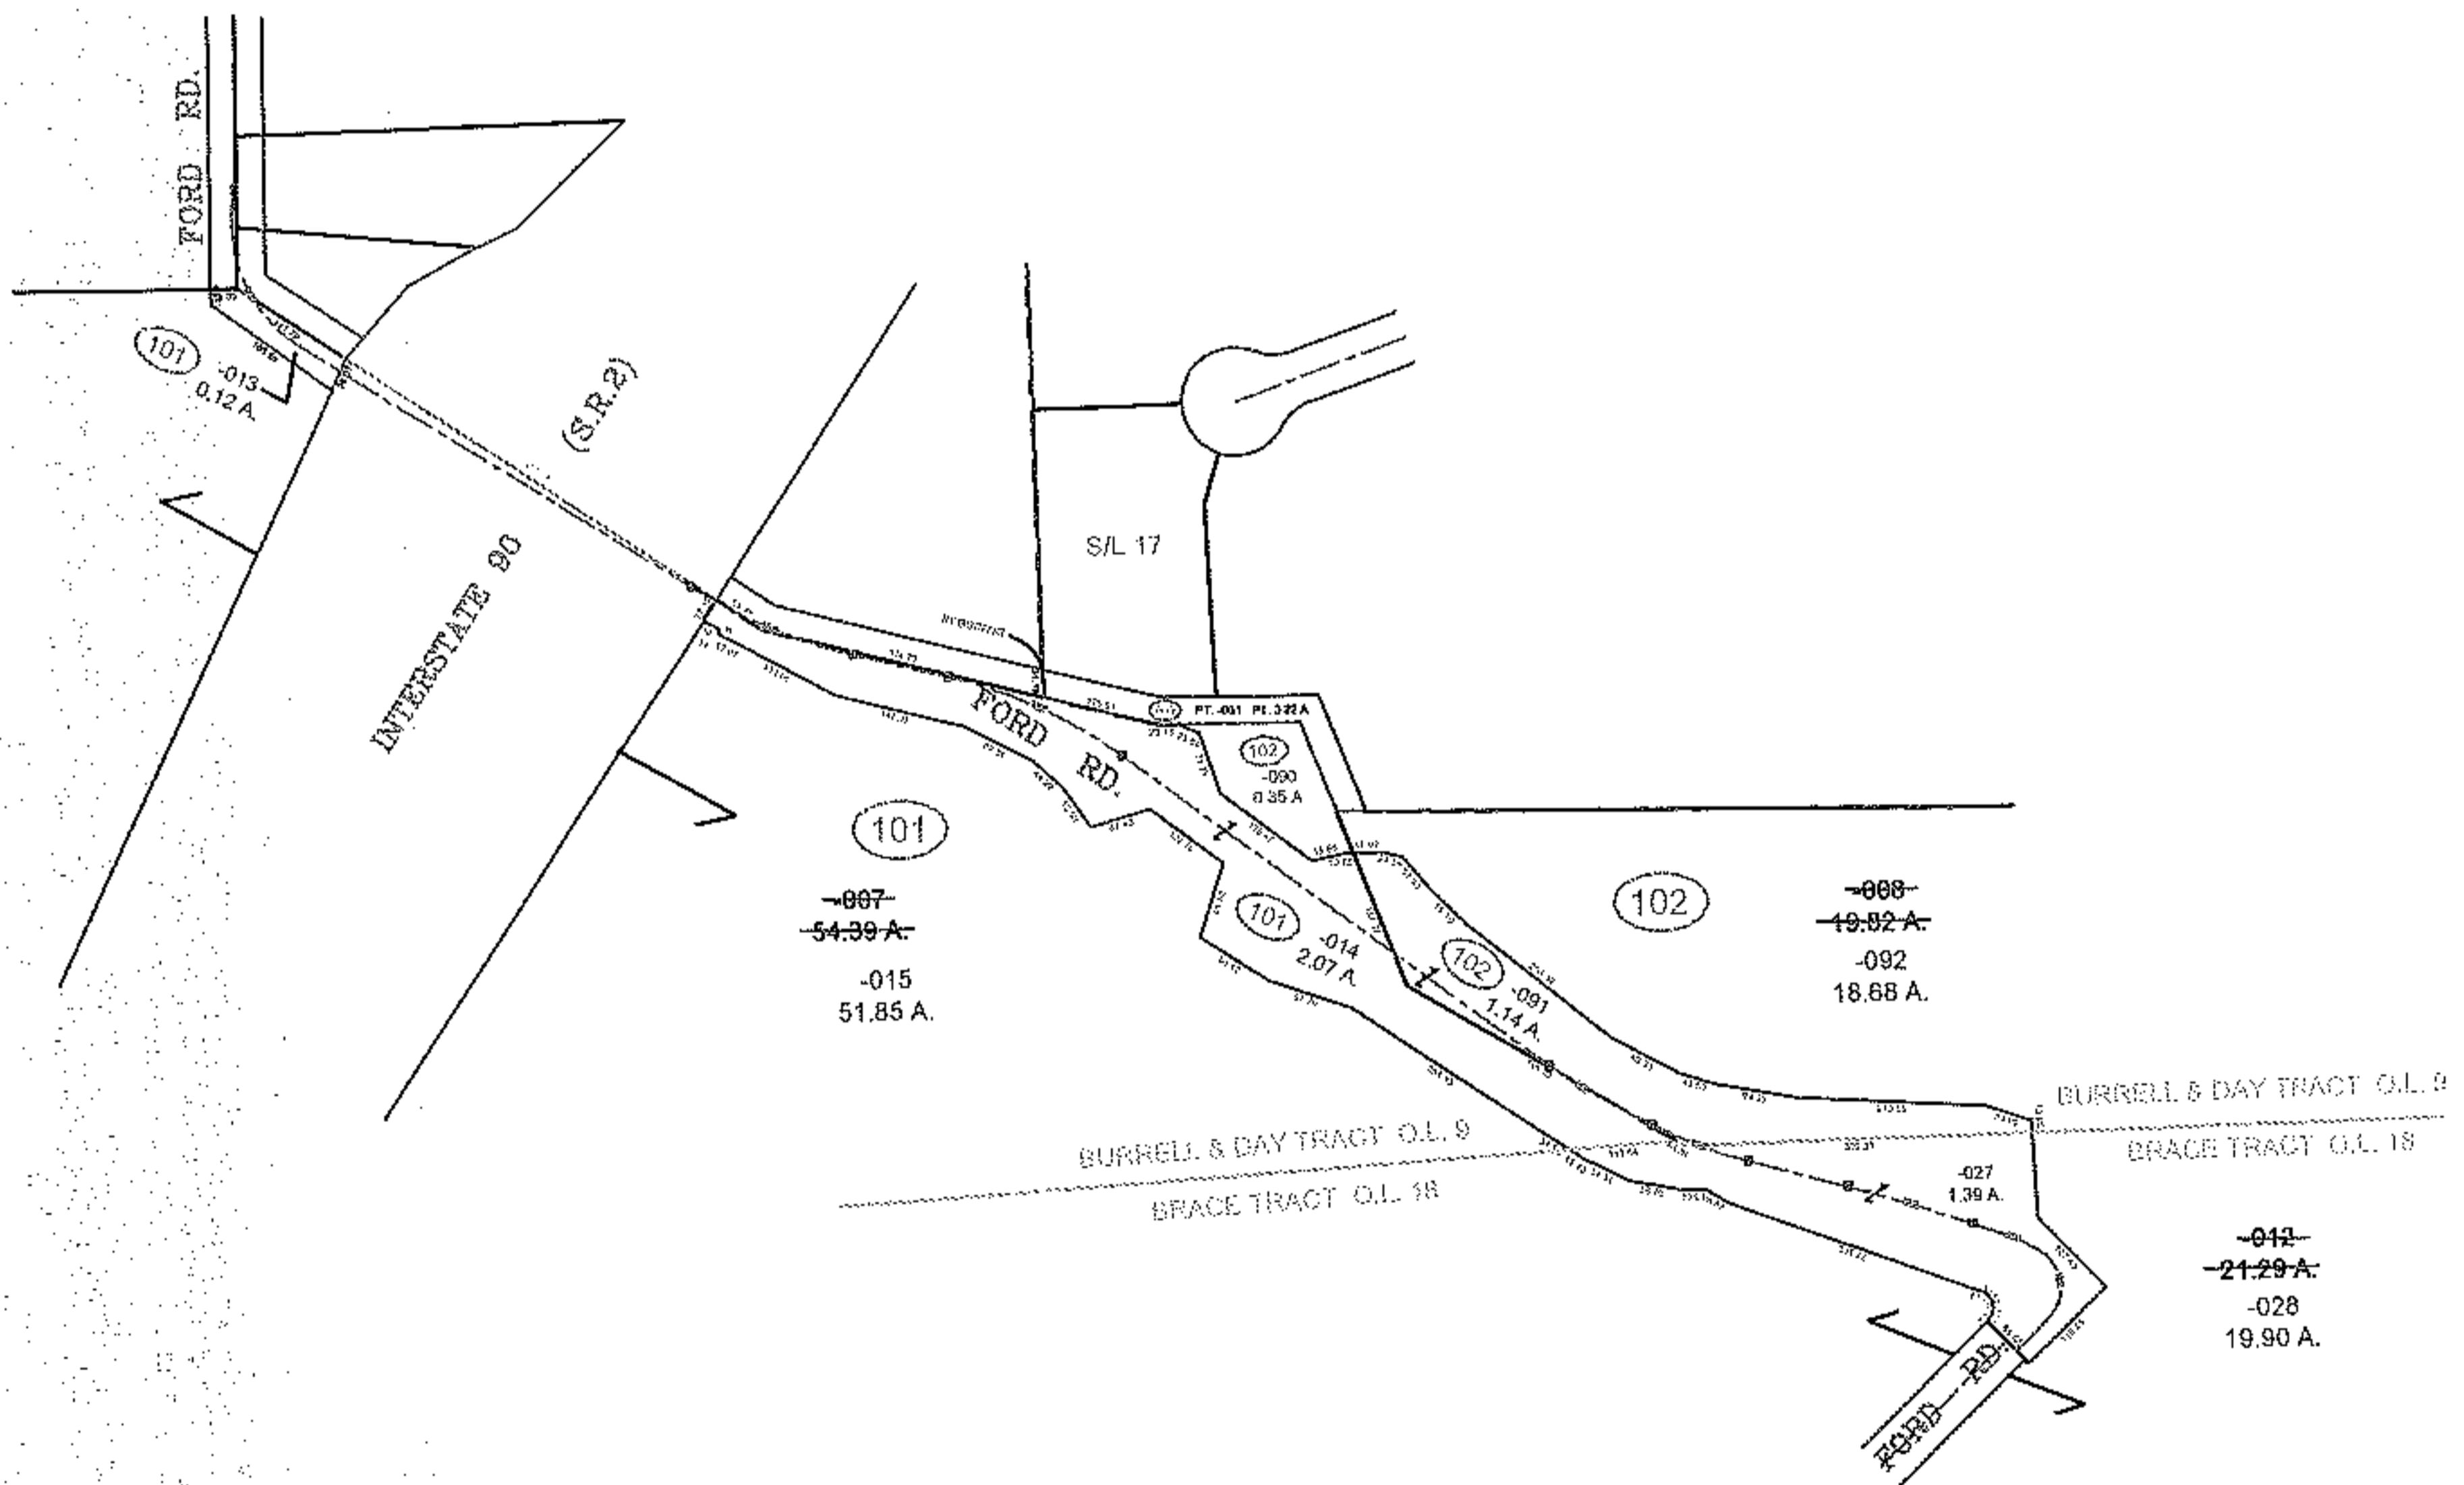


PARENT PARCEL: 06-22-009-101-007, 06-22-009-102-008, 06-23-018-000-012
 CHILD PARCEL: 06-22-009-101-013 THRU -015
 CHILD PARCEL: 06-22-009-102-090 THRU -092
 CHILD PARCEL: 06-23-018-000-027 & -028
 STARTING POINT: I.P. , N.W. R.O.W. CORNER OF FORD RD. DEDICATED IN PLAT VOL. 32 PG. 49


12-00350

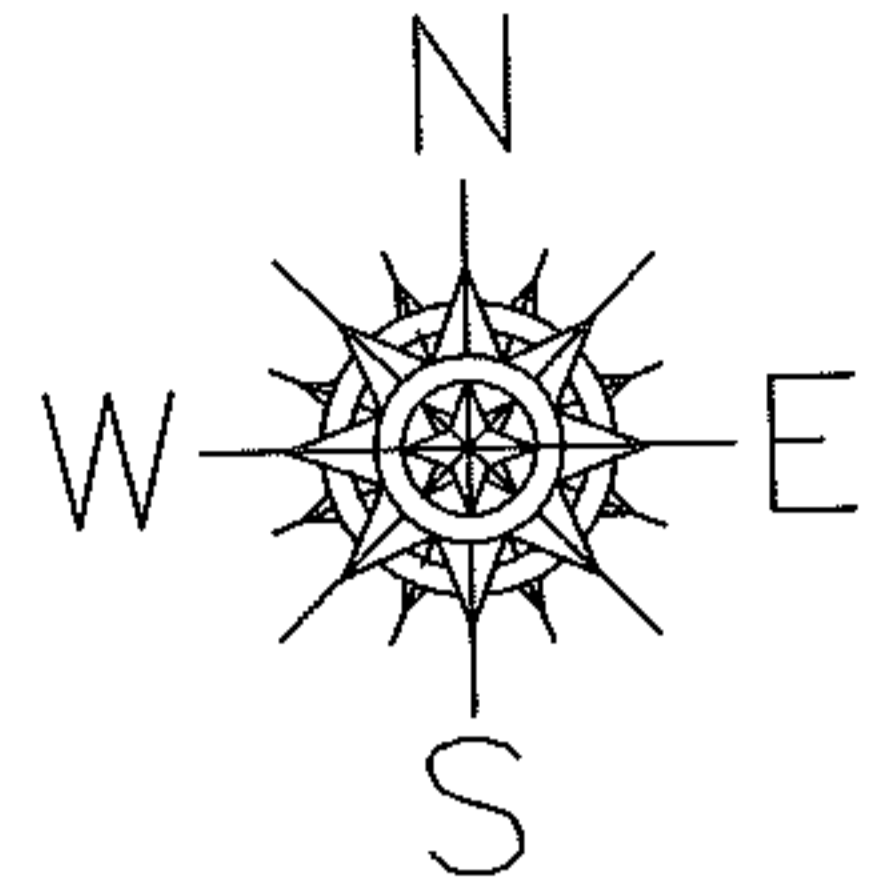

PRIOR INSTRUMENT: DV 912/255

PRIOR INSTRUMENT: DV 912/253

PRIOR INSTRUMENT: DV 890/76

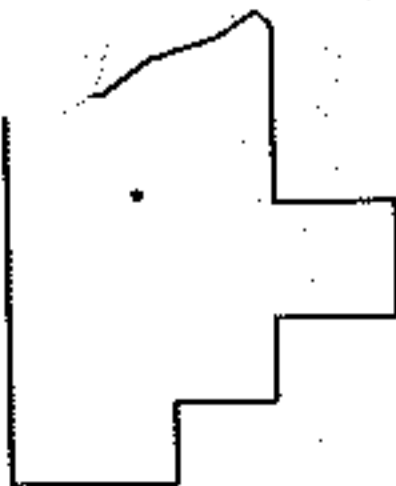

SPLITS/DEEDS PROCESSED
 LORAIN COUNTY TAX MAP DEPARTMENT
 226 MIDDLE AVE. ELYRIA, OHIO

SURVEYED BY: TREVOR A. BIXLER
 CLOSURE: 0.01 : 10,000
 MAP PAGE(S): 6-12 6-14 6-31
 APPROVED BY: TJS DATE: 11/13/12
 SCALE: 1" = 400