


PARENT PARCEL: 03-00-011-102-092

CHILD PARCEL: 03-00-011-102-132, -133

12-00352


STARTING POINT: AT A MON BOX AT THE INTERSECTION OF C/L OF S.R.254 AND C/L OF ABBE RD.

NORTH RIDGE RD. (S.R. 254)

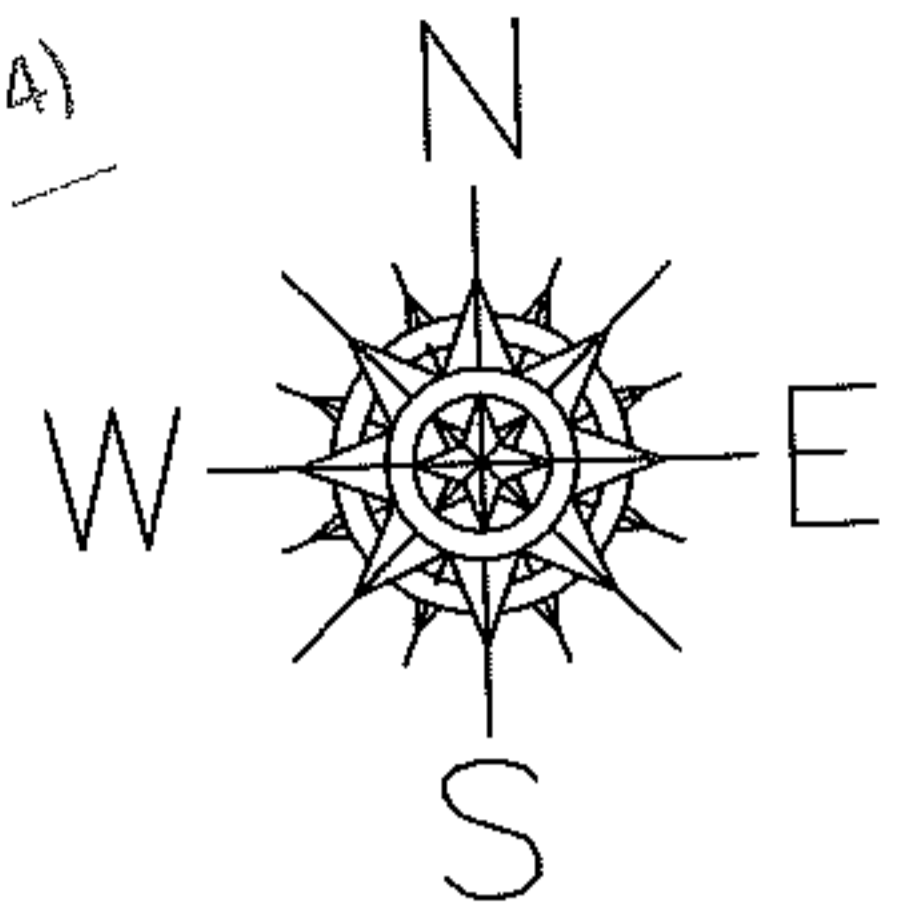

337.16


ABBE. RD.

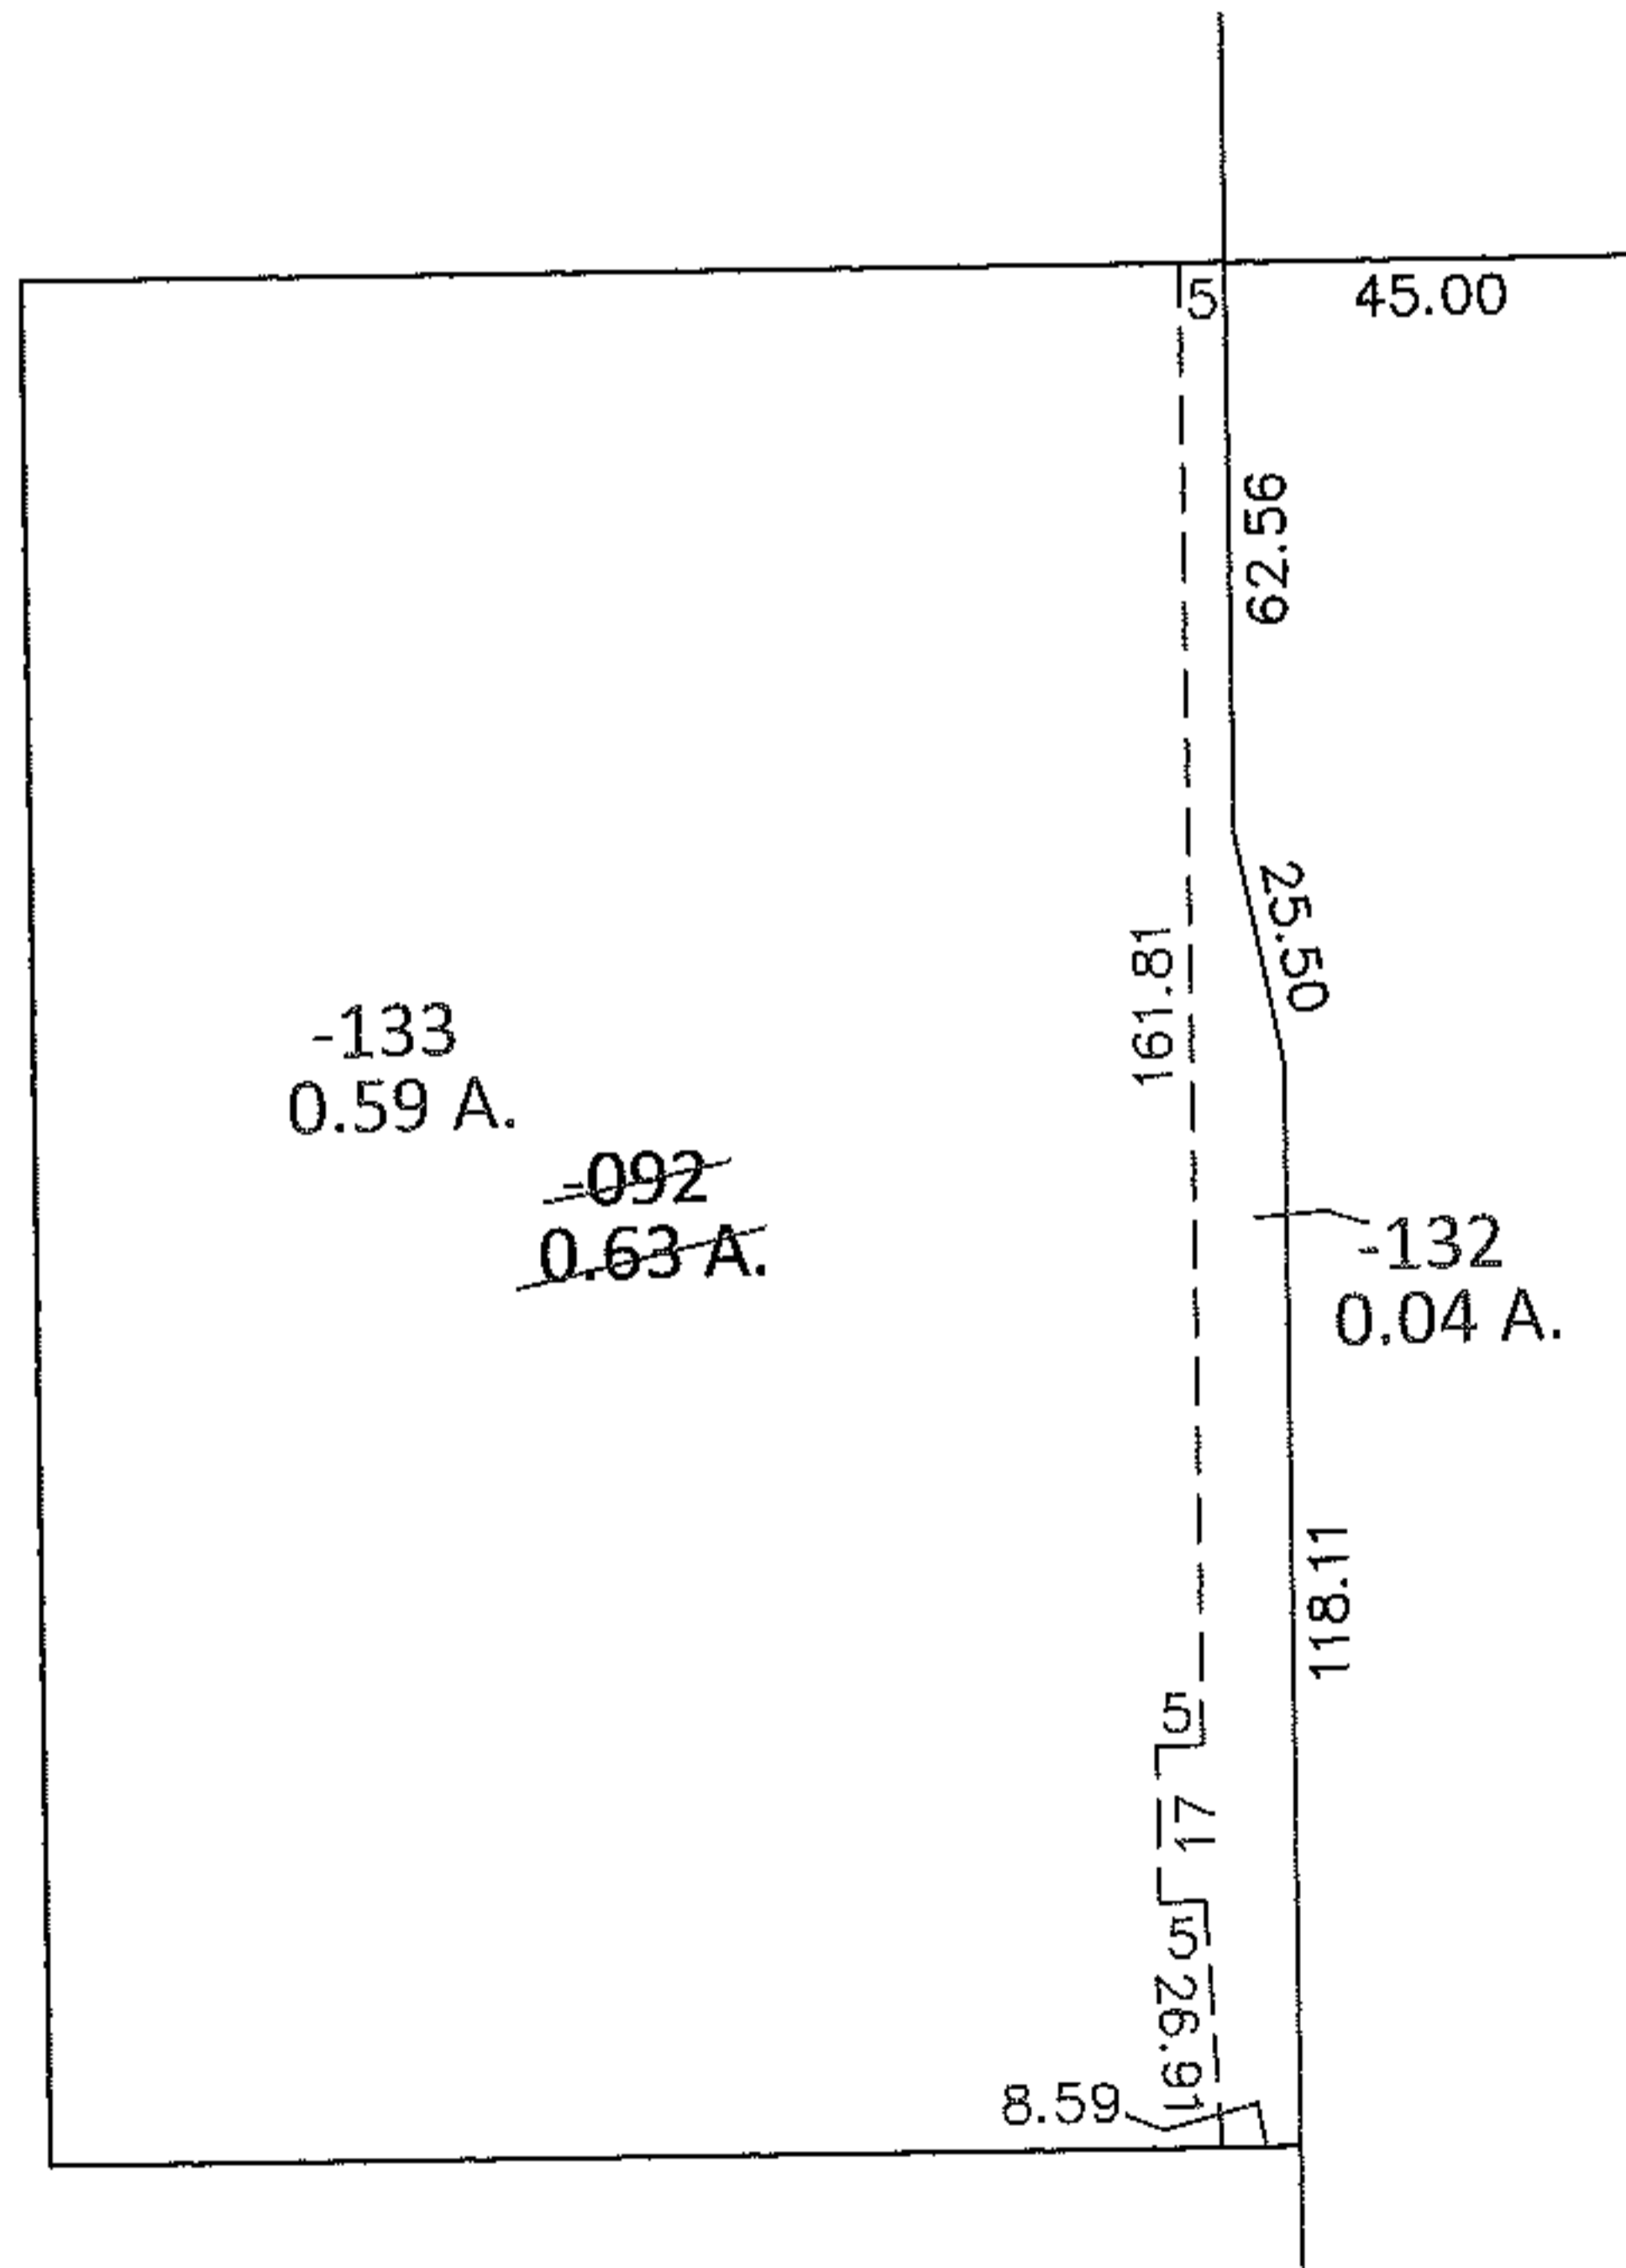

-133
0.59 A.

~~-092~~
~~0.63 A.~~

-132
0.04 A.

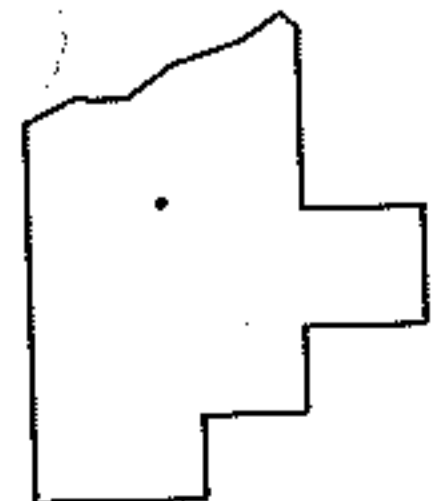

SPLITS/DEEDS PROCESSED

LORAIN COUNTY TAX MAP DEPARTMENT
226 MIDDLE AVE. ELYRIA, OHIO

SURVEYED BY: RICHARD JOHN SWAN

CLOSURE: .01:10,000

MAP PAGE(S): 3-00-011-B

APPROVED BY: RRM DATE: 11-19-12

SCALE: 1"=50' PRIOR INST.: 20050100225