
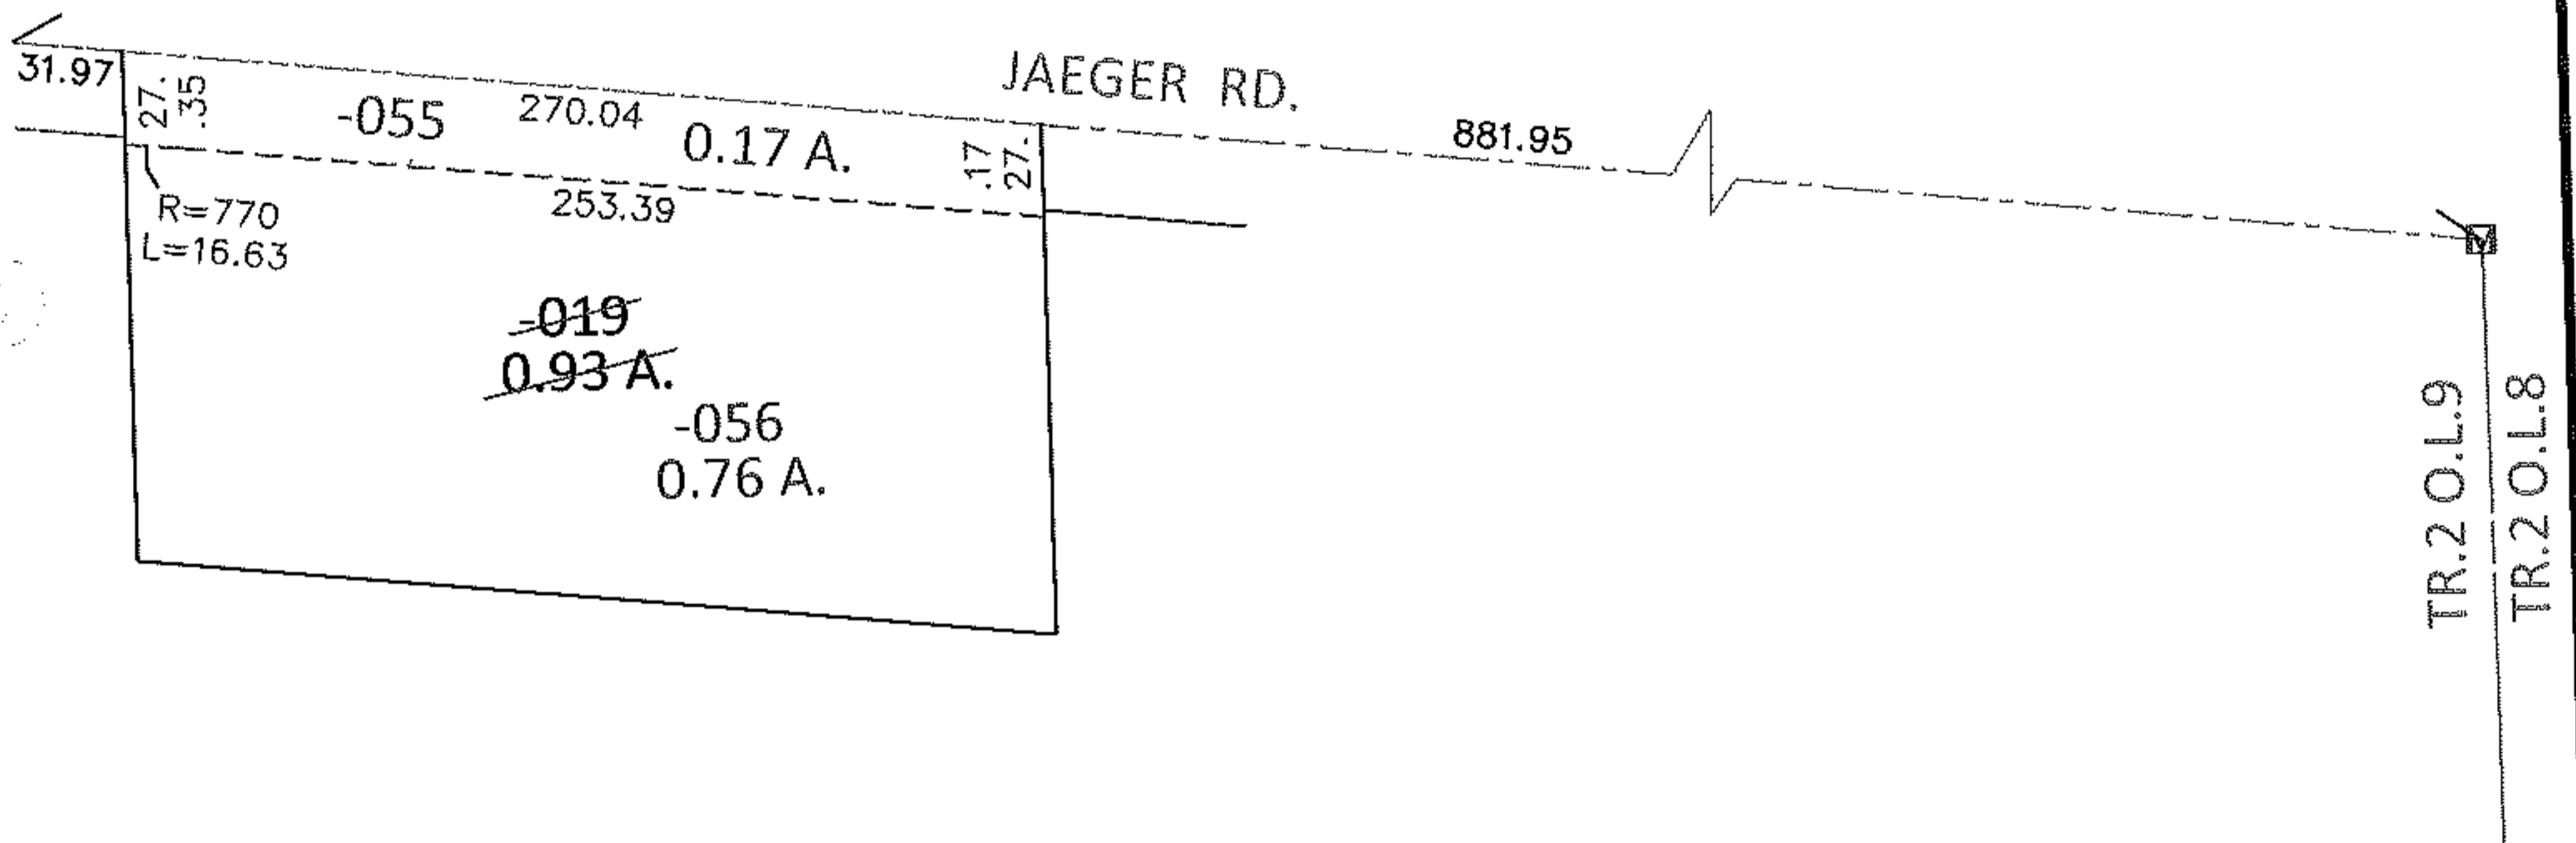


PARENT PARCEL: 02-02-009-102-019

CHILD PARCEL: 02-02-009-102-055, -056

12-00356

ARTING POINT: AT A MON BOX AT THE INTERSECTION OF C/L OF JAEGER RD. AND EAST LINE OF TR.2 O.L.9

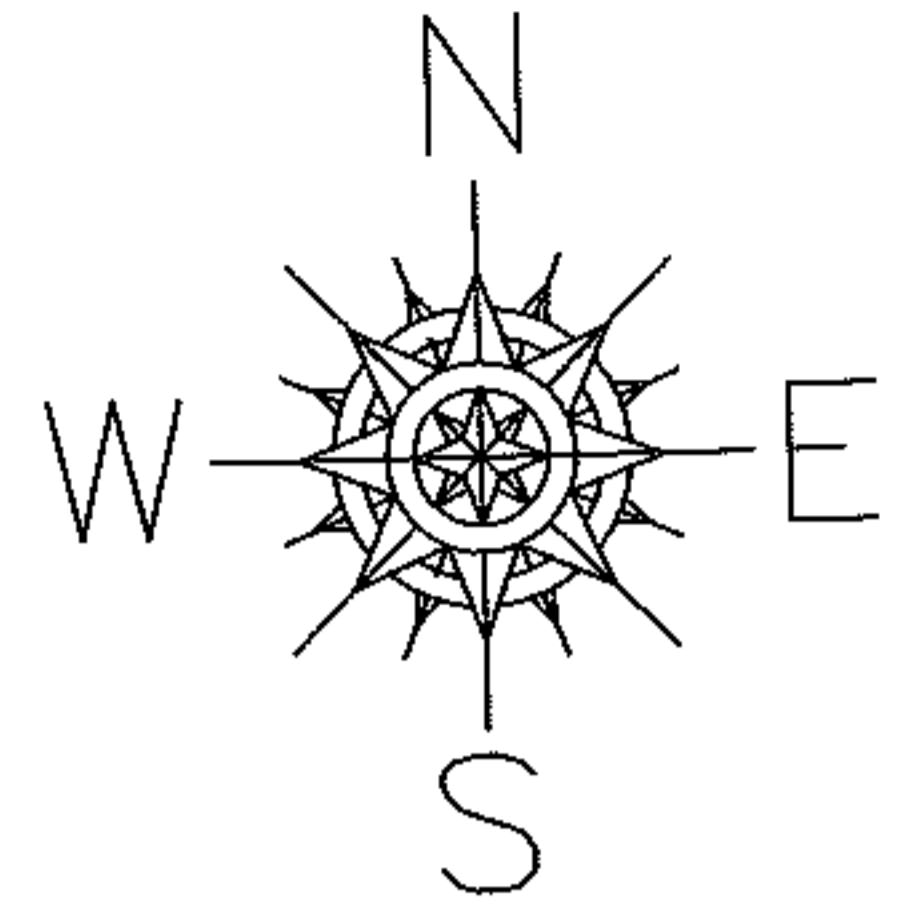

SURVEYED BY: TREVOR A. BIXLER

CLOSURE: .00:10,000

MAP PAGE(S): 2-02-009-B

APPROVED BY: RRM DATE: 12-5-12

SCALE: 1"= 100 PRIOR INST.: DV 1254/363

SPLITS/DEEDS PROCESSED

LORAIN COUNTY TAX MAP DEPARTMENT
226 MIDDLE AVE. ELYRIA, OHIO

