


#12001

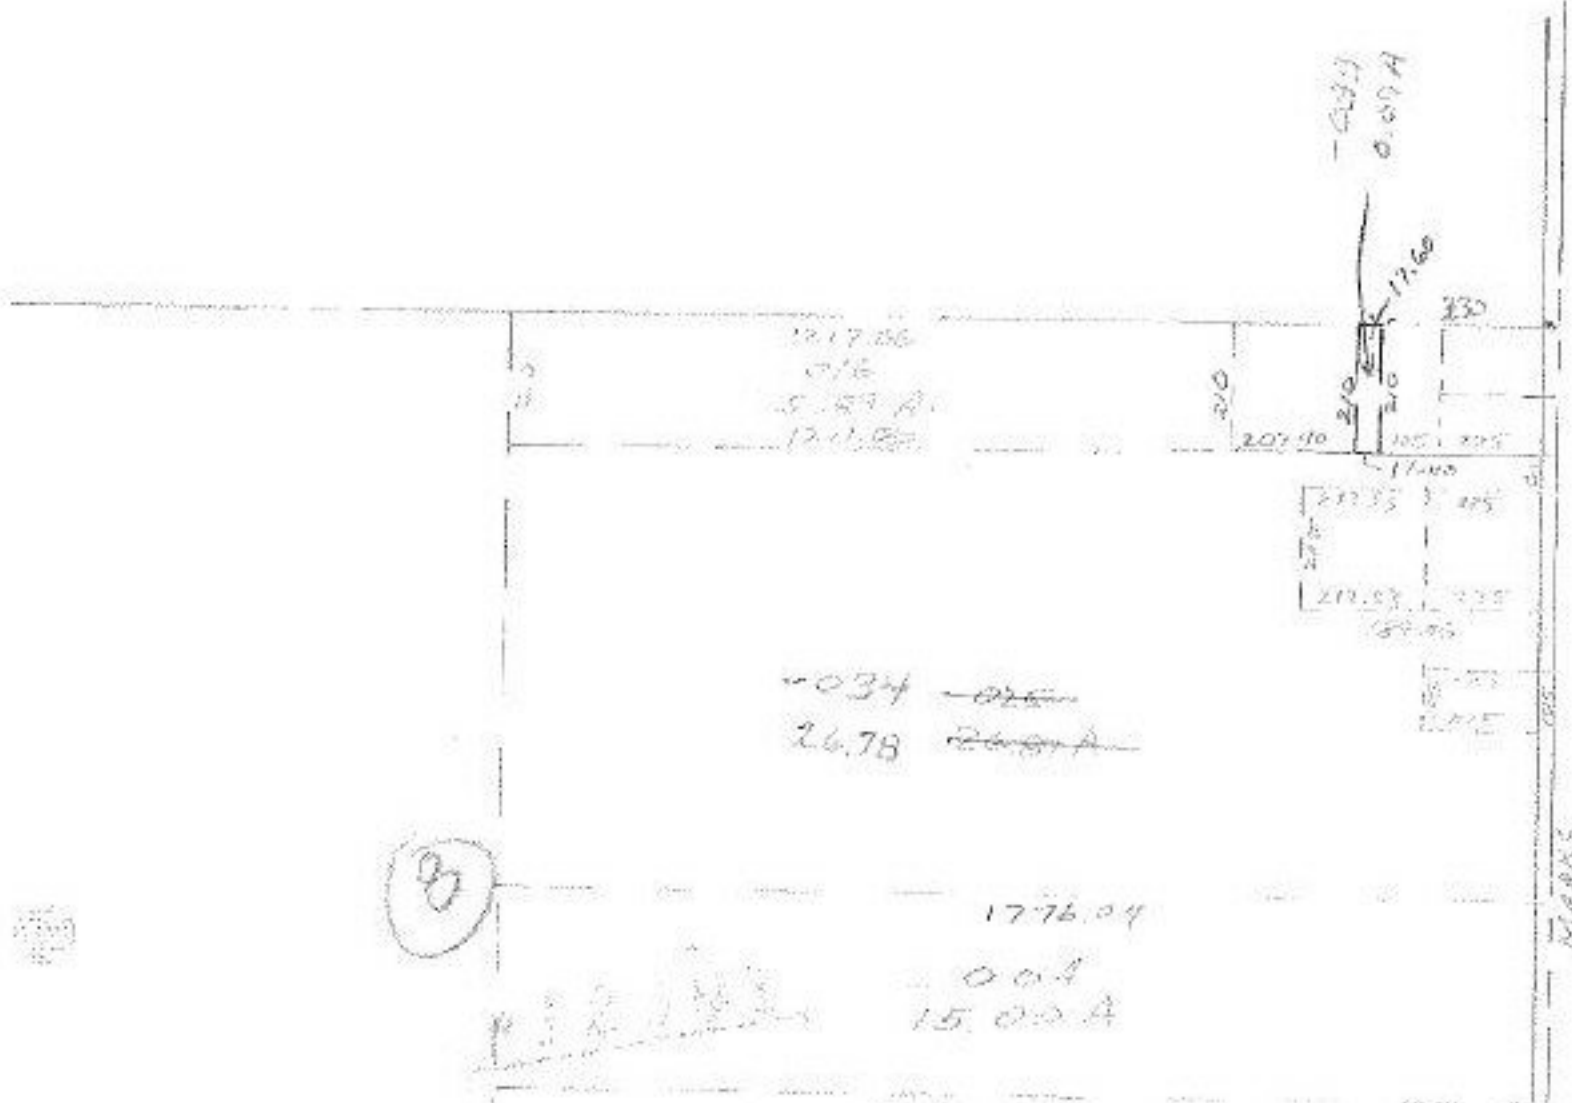

MAR 19 1979

*[Handwritten signature]*

**#12001**  
**APPROVED**  
**LORAIN CO.**  
**MAP DEPT.**

DATE	9-1-78
PAGE	12-14
BY	T.M.K. [initials]
VOID AFTER	

*[Handwritten notes]*