

MEADOWS

VOL. 33 PGS


113

ROLLING

CASSELL

MAPLE

Vermilion City

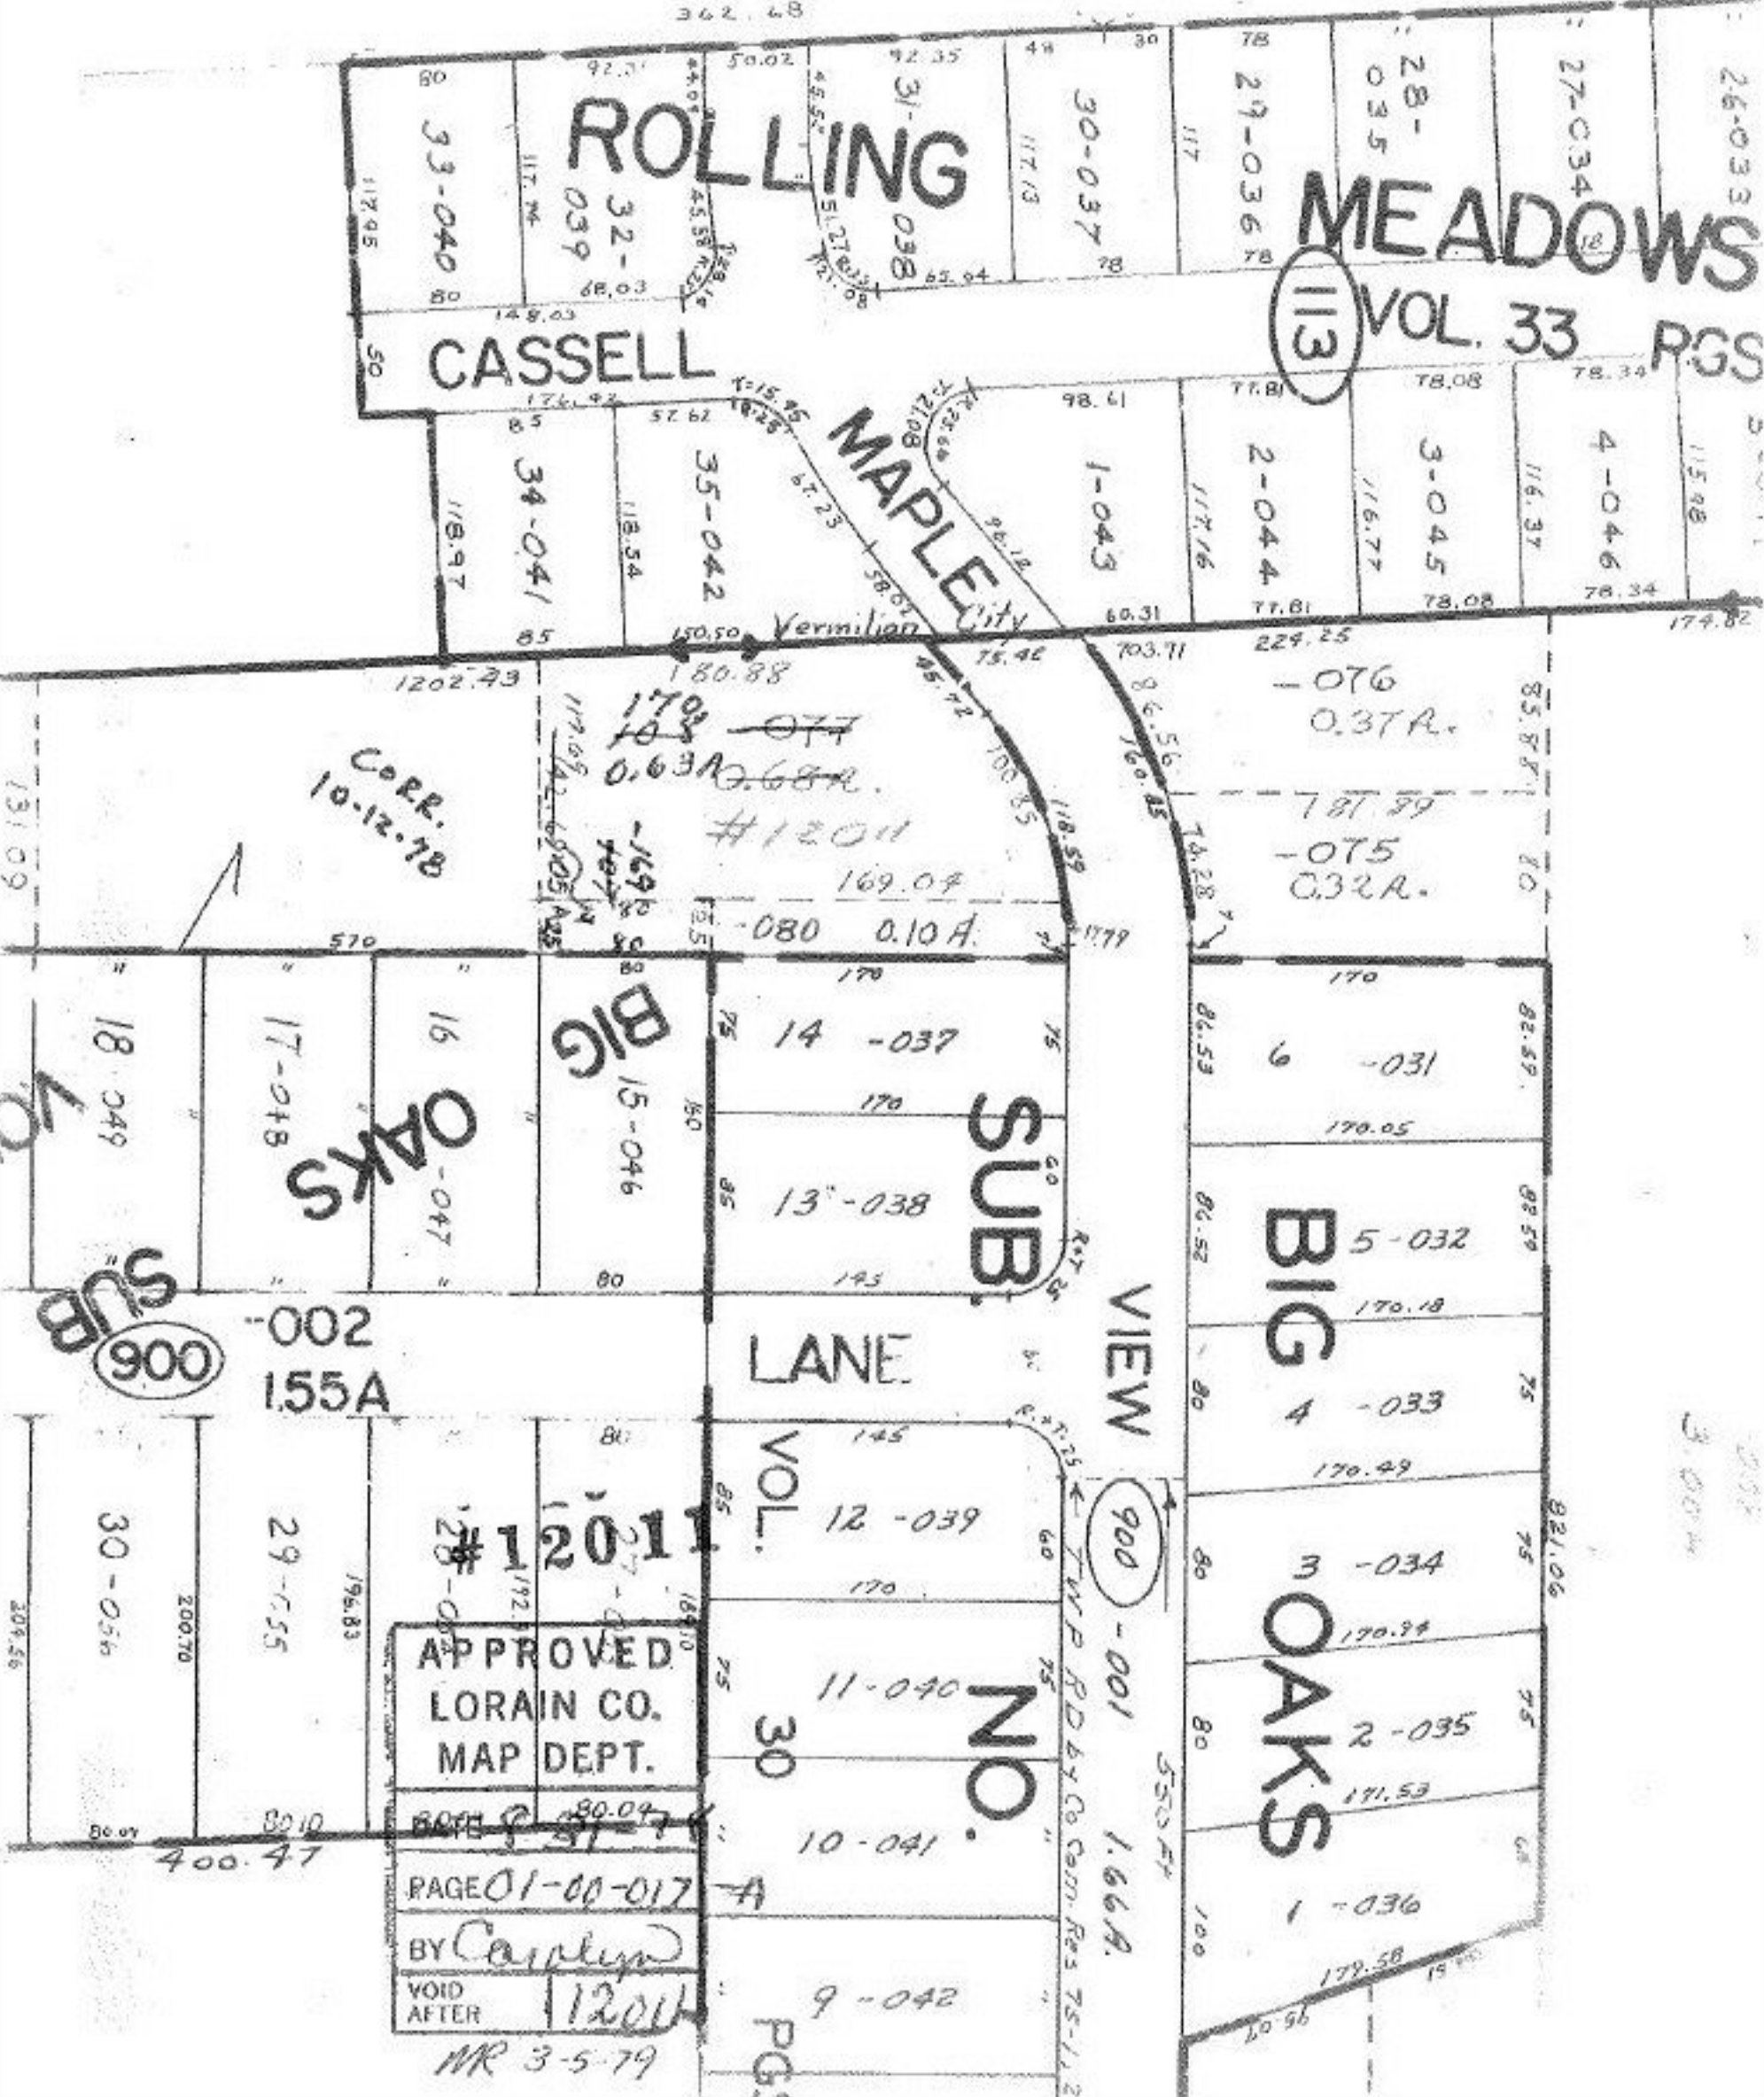

CORR. 10-12-78

BIG OAKS

SUB

BIG OAKS

VIEW

LANE

VOL.

30

NO.

APPROVED
LORAIN CO.
MAP DEPT.

PAGE 01-00-017-A

BY Carolyn

VOID AFTER 12011

MR 3-5-79

SUB 900

900 -001 1.66A.

3.000

PGS