


#12016

-04
6.4

1207.06

TINIL

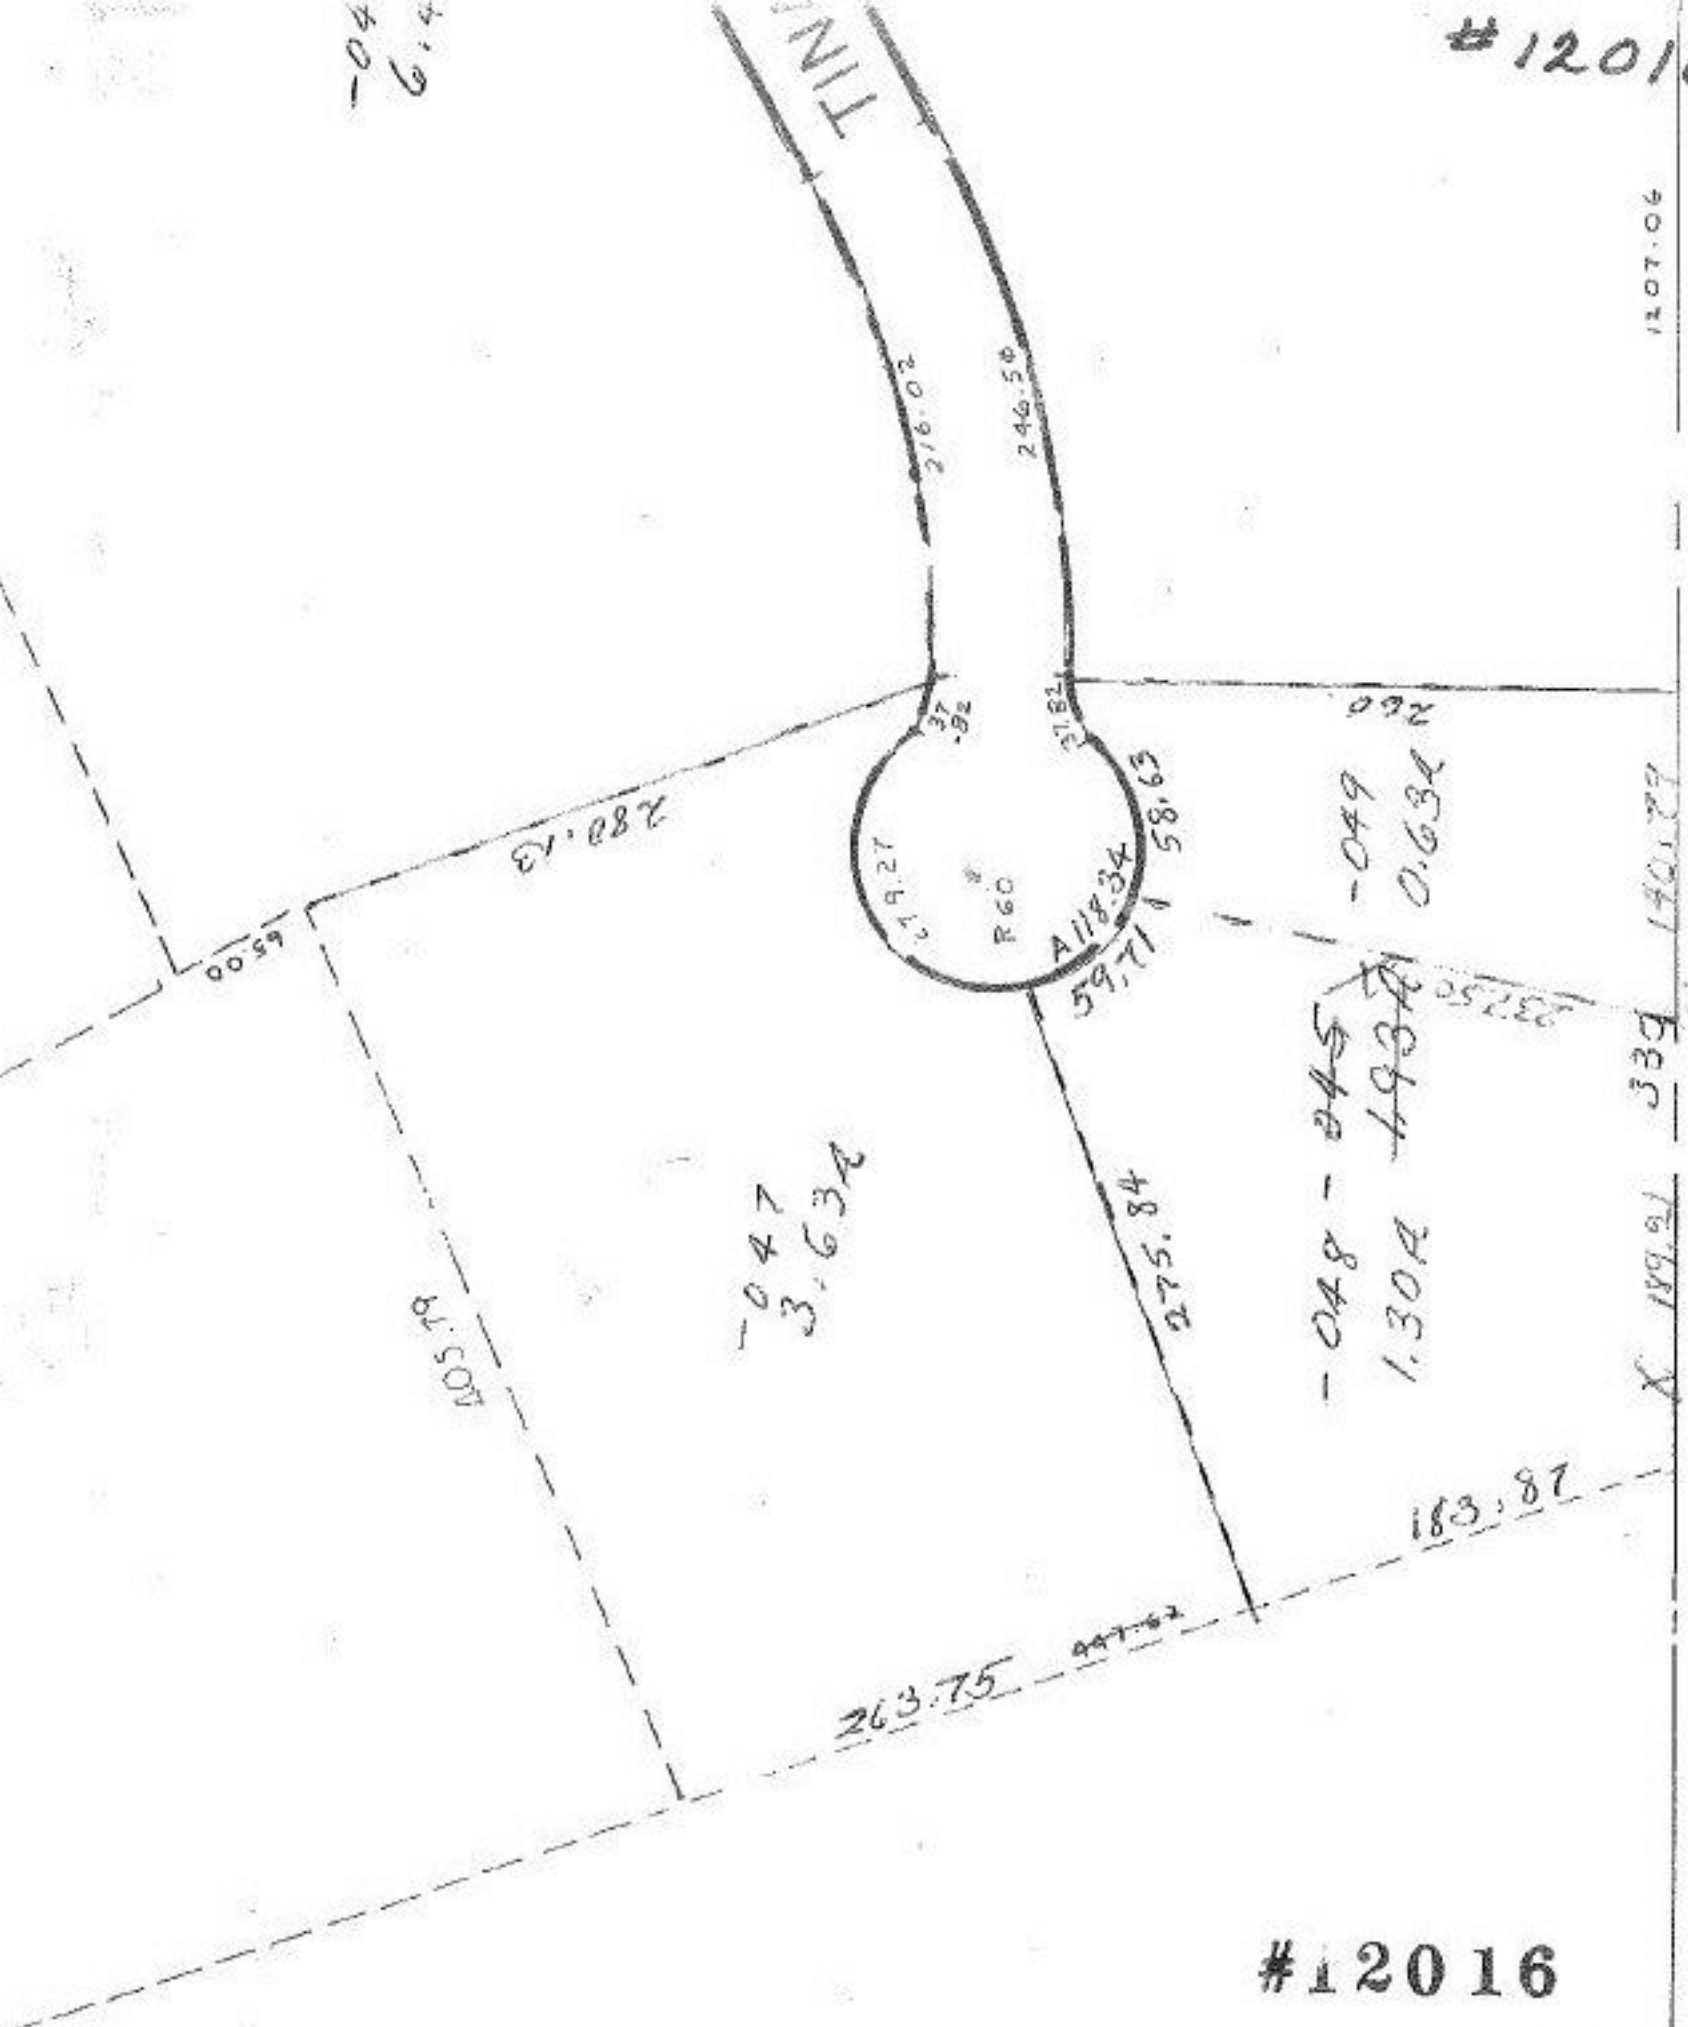

#12016

MAY 8 1979

APPROVED	
LORAIN CO.	
MAP DEPT.	
DATE	9-5-78
PAGE	05-00-097-B
BY	Carolyn
VOID AFTER	12016

7 3