

12019

#16019

APPROVED	
LORAIN CO.	
MAP DEPT.	
DATE	9-5-78
PAGE	15-00-072-018
BY	Cognolin
VOID AFTER	12019

MAR 9 1979

*[Signature]*

P+15-00-072-000-018


R. 500A

P+15-00-072-000-020

R. 500A

P+15 00-072-000-022

R. 500A

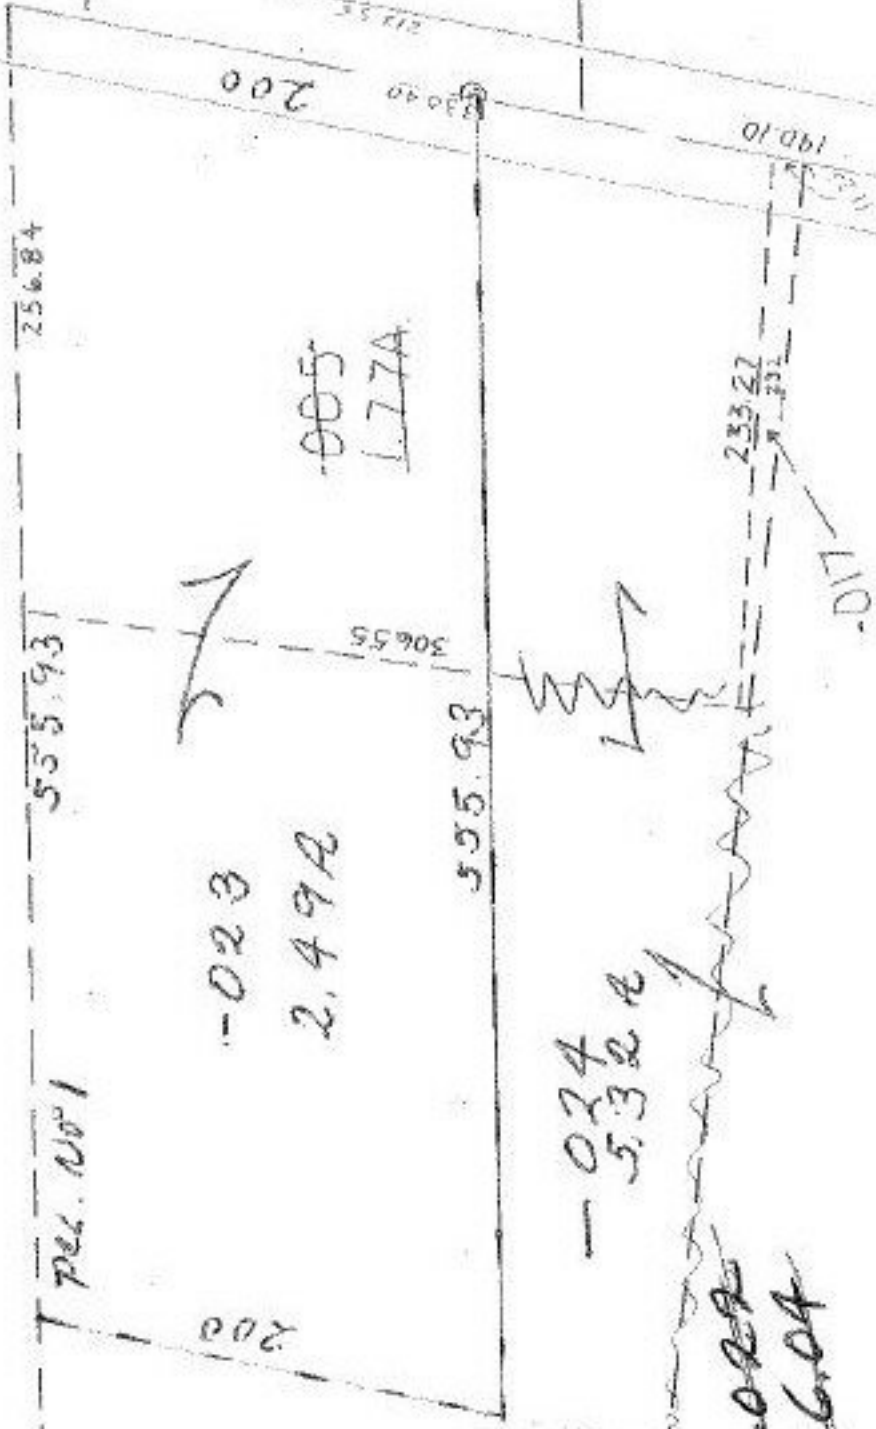

Rec. No 1

200

-023

2.49A

-005

1.77A

555.93

-034

5.32A

-02A

6.04

-017

233.27

190.10

190.10

190.10

256.84

555.93

306.55

190.40

200

212.58

151.10

P+15-

10A