

151

RD.

837  
1667.60

#12020

#12020

MAR 21 1979

APPROVED LORAIN CO. MAP DEPT.
DATE 9-6-78
PAGE 11-00-014-BA
BY <i>F. Elliott</i>
VOID ASTER


-019  
5.03 Ac.

1951.84

Pt. -016 -020

Pt. 85.23A

80.20 Ac.

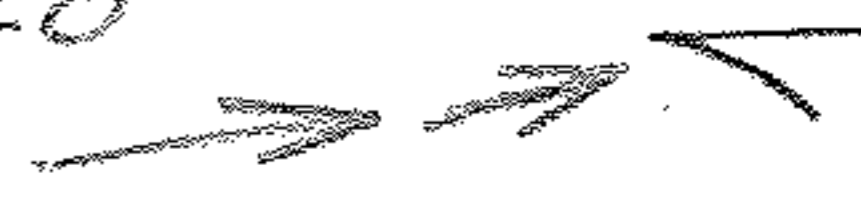

85.23
5.03
<hr/>
80.20

1451.84

1667.60
679.60
<hr/>
988.0
151
<hr/>
837

151

1561.72