

SEE 4-
WEBBER

SEE 4-
#12025

- 010
11.13F

#12025


APPROVED LORAIN CO. MAP DEPT.
DATE 9-7-78
PAGE 4-B
BY T. McHale
VOID AFTER MAR 3-27-79

8

- 015
23.89F

2672.4

MOORE

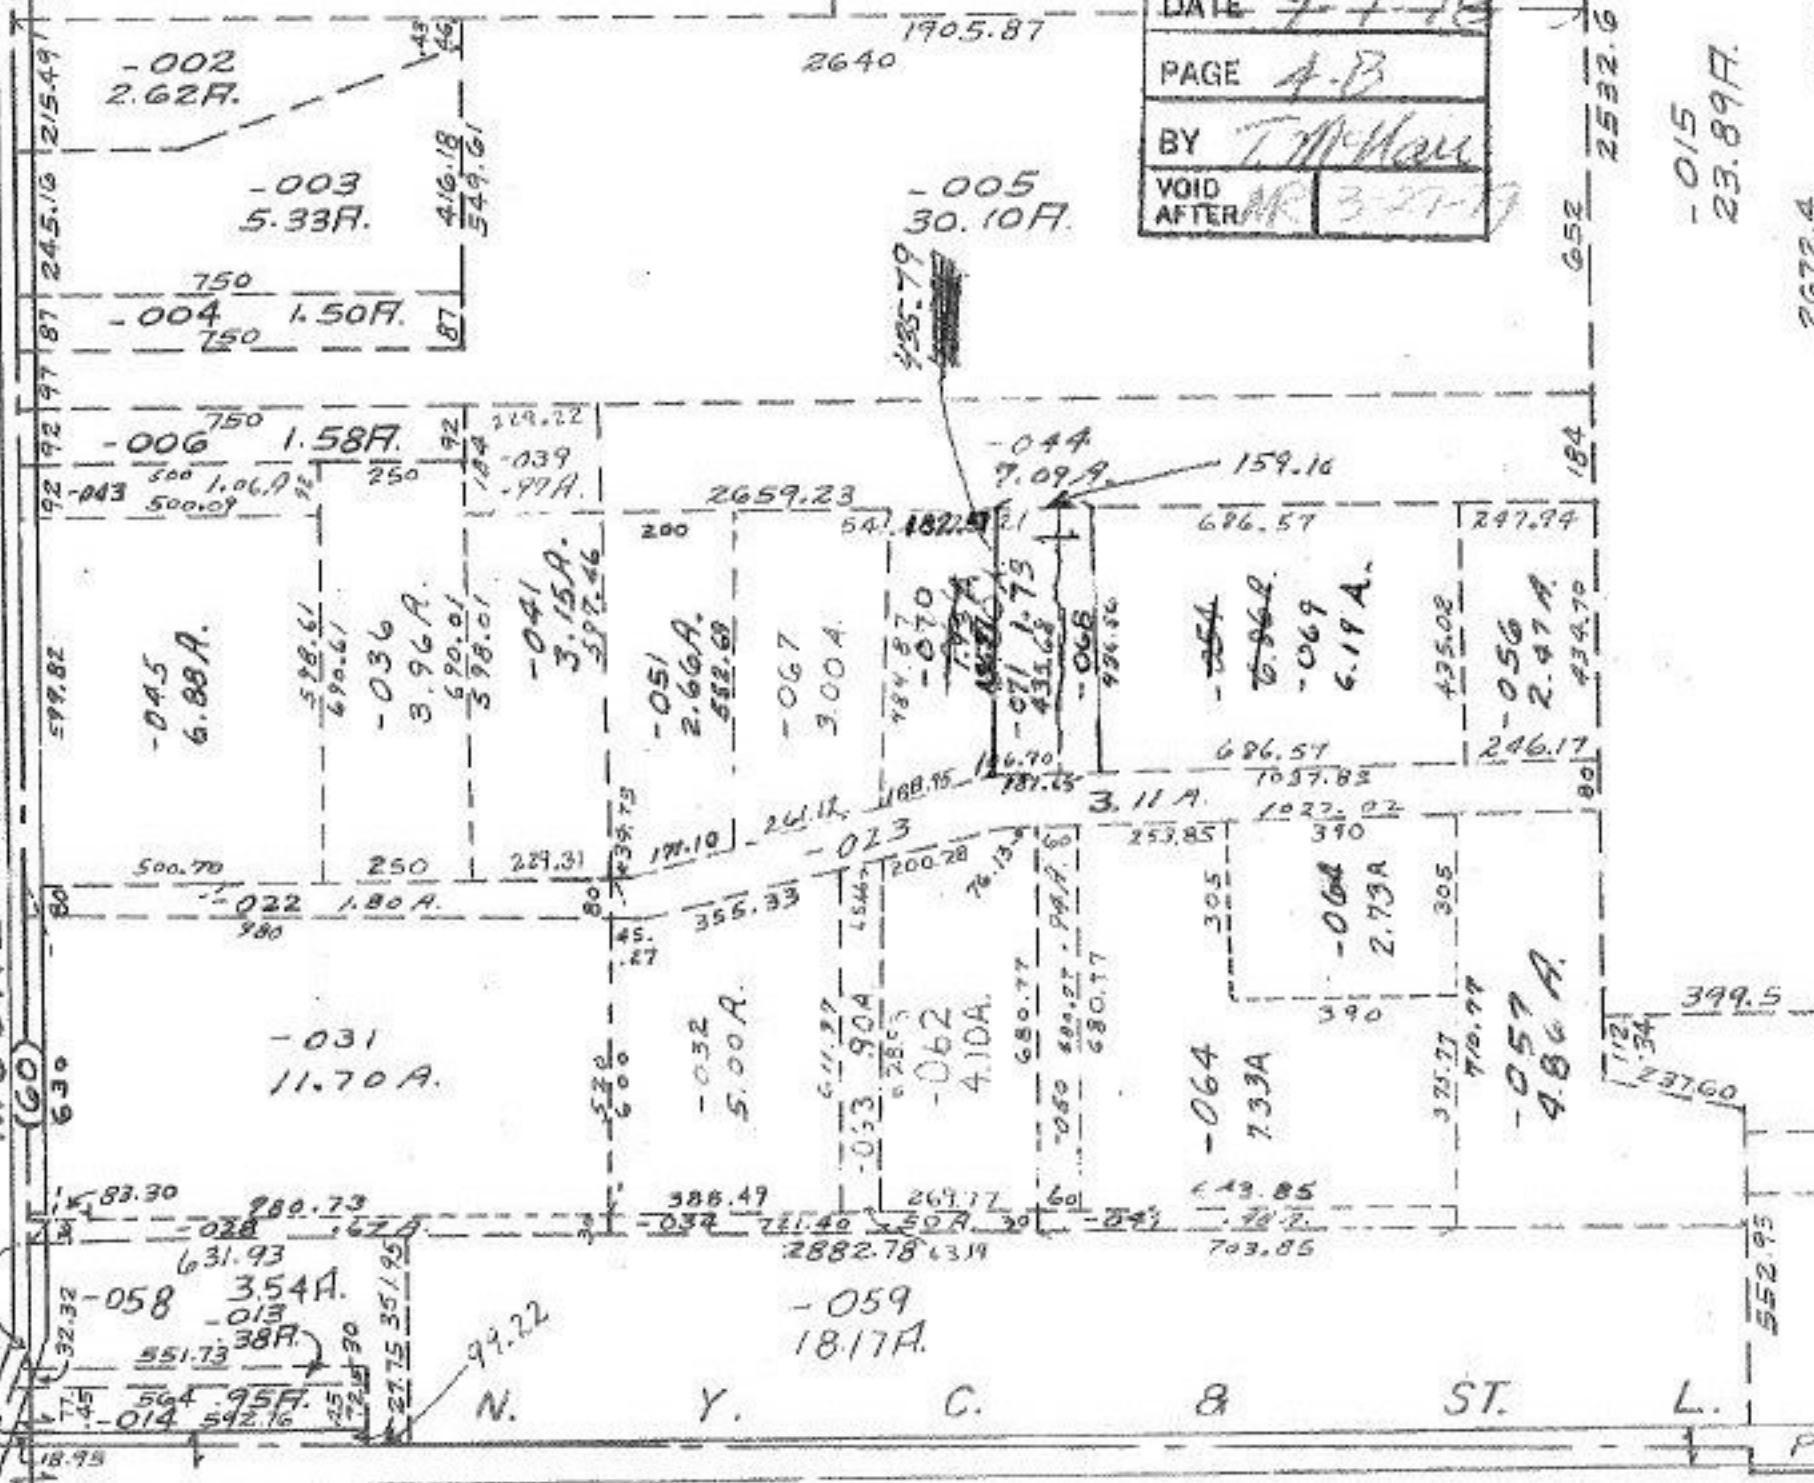

2532.6

652

184

80

305

340

552.95

399.5

703.85

552.95

PT.