


A-D

1106.80 ?  
1104.80 °

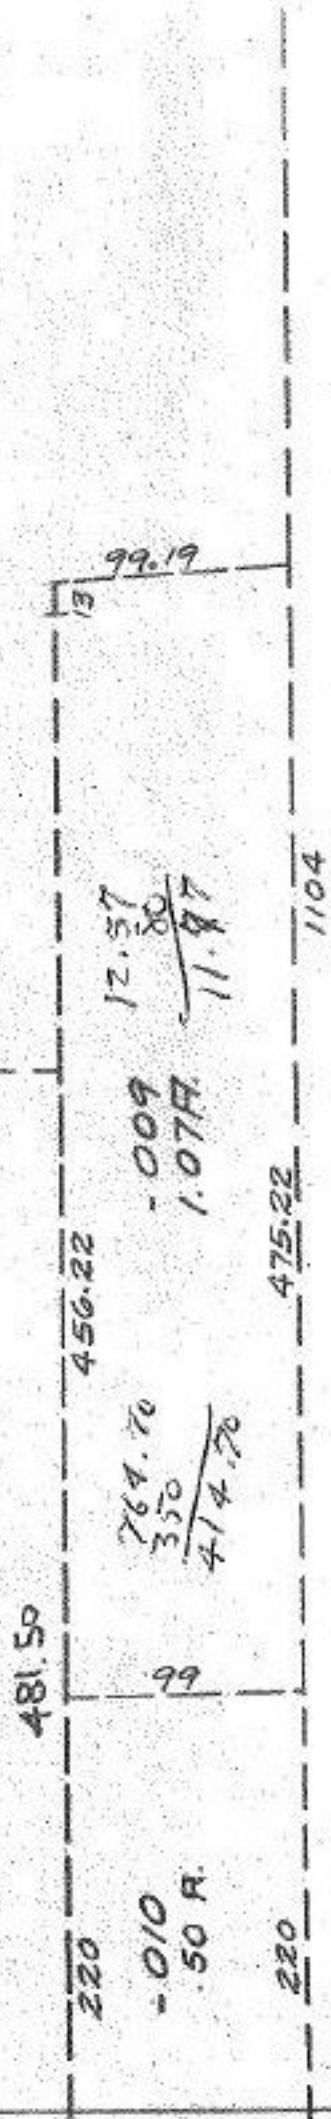

-0.48  
-0.38  
12.57A  
11.77A

#12042

APPROVED	
LORAIN CO.	
MAP DEPT.	
DATE 9-12-78	
PAGE 4-00-036 E	
BY	<i>J. Balluff</i>
VOID	
AFTER	

T.M  
9-6-79

67.06

414.70

764.70

481.50

456.22

475.22

1104

220

-0.10  
50 A.

220

99

764.70  
350  
414.70

12.57  
11.97

-0.09  
1.07A

99.19

350

-0.47  
0.60A.

350

164.47 264.47

100

160.80

RB

*[Faint handwritten notes]*