


12049

RD.

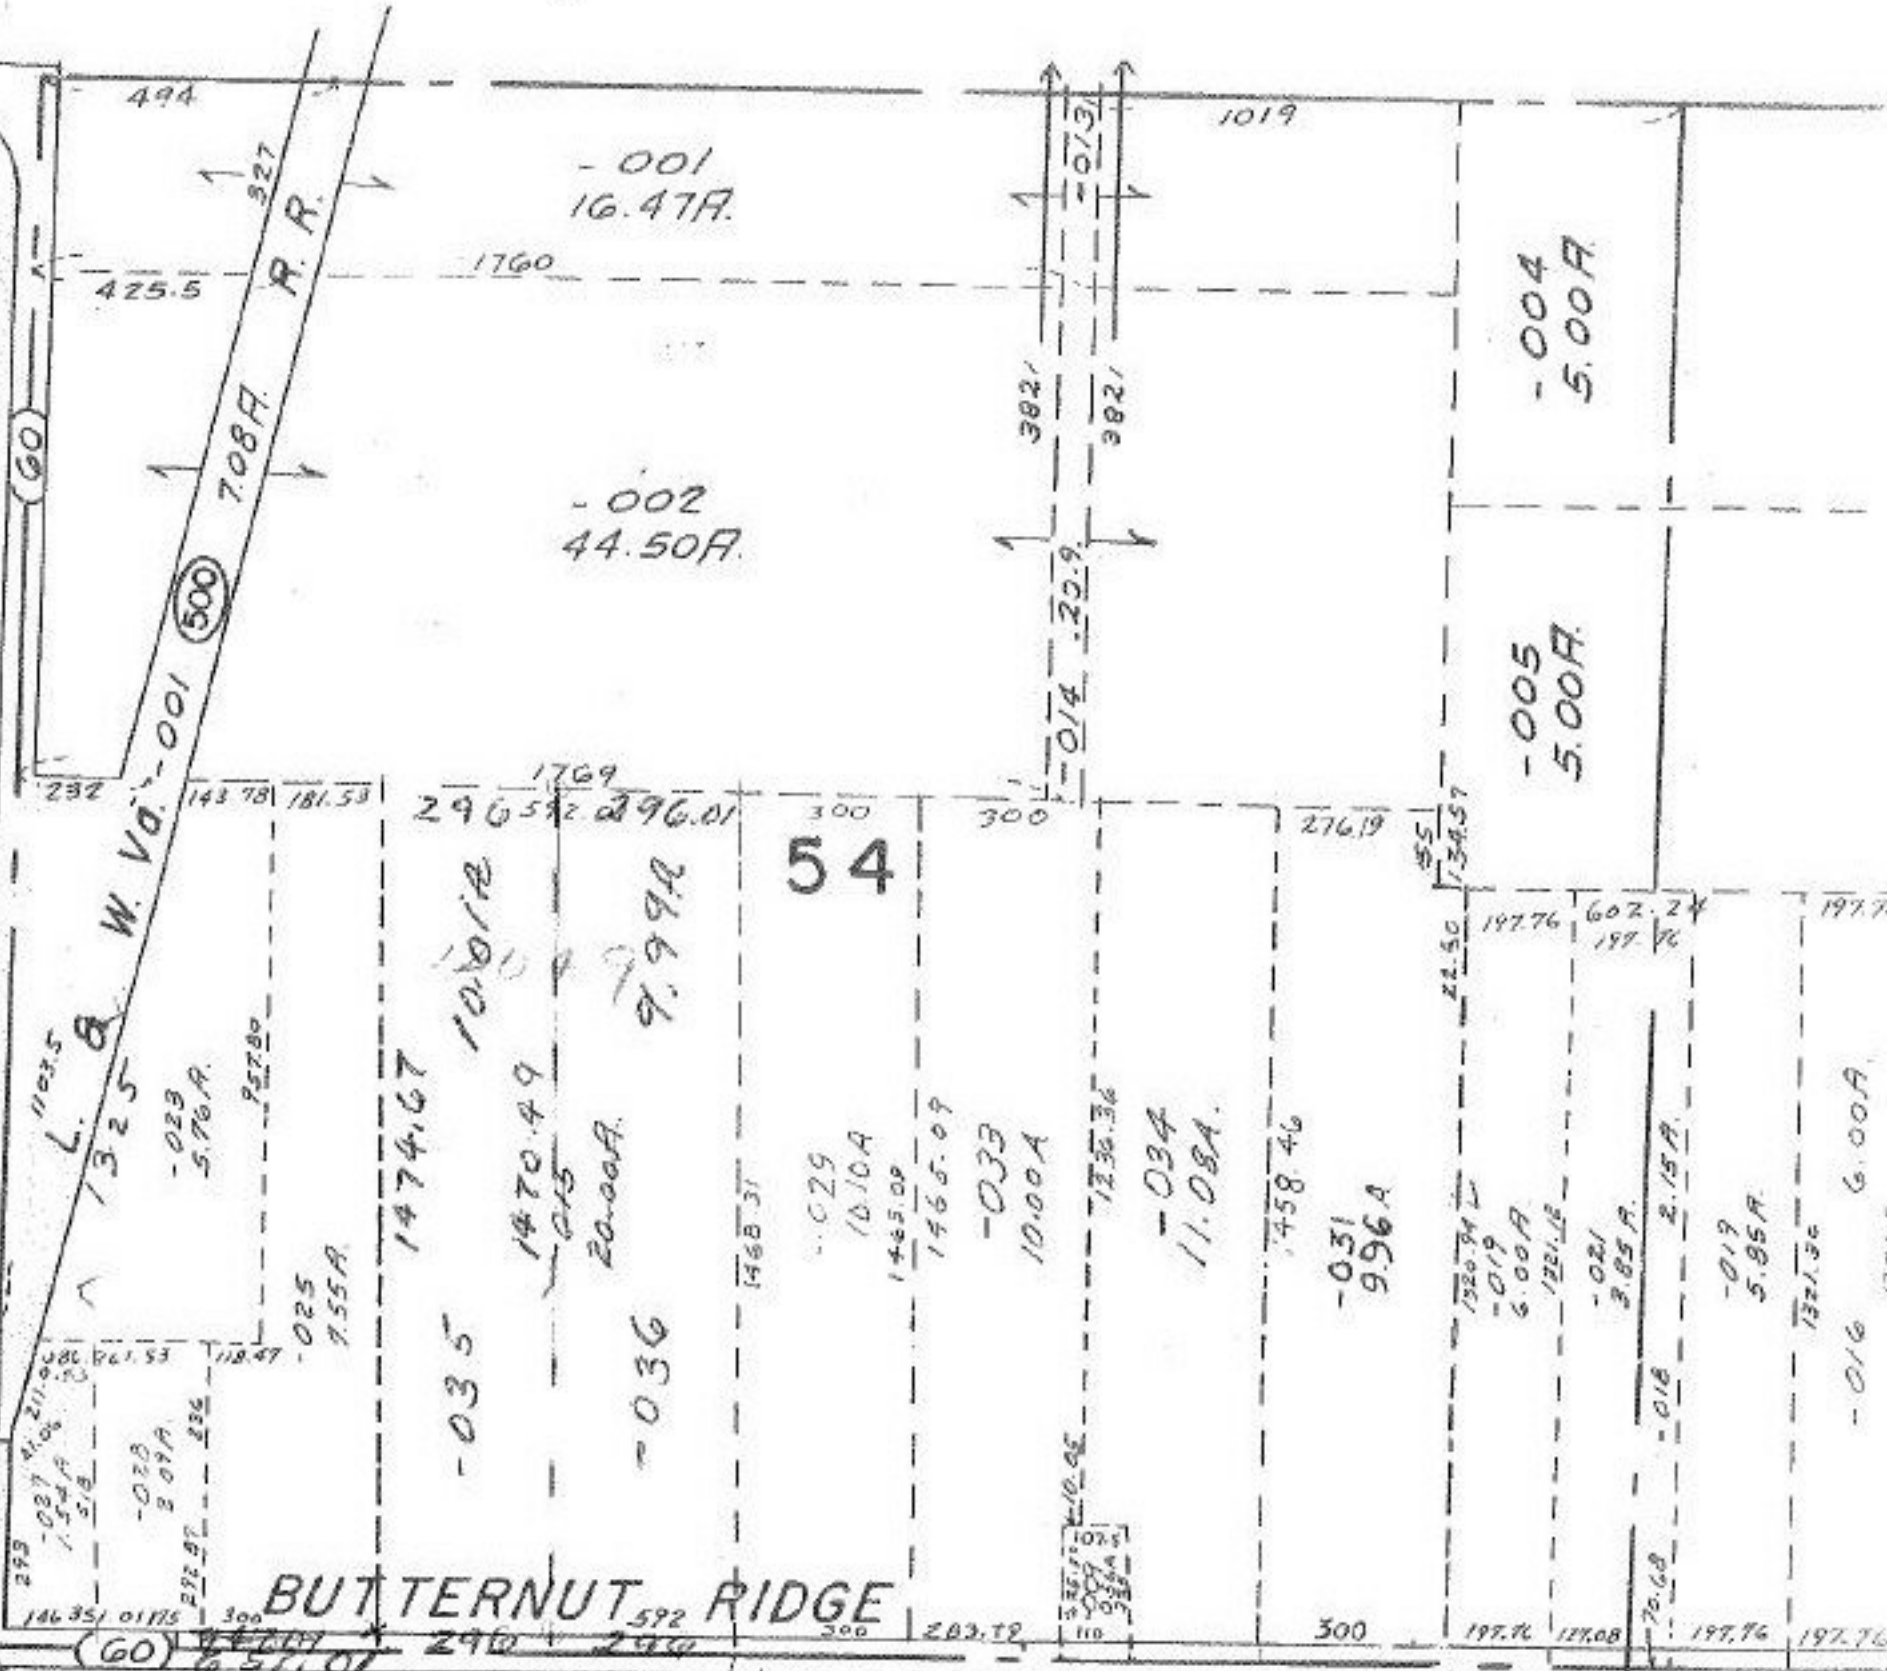

BUTTERNUT RIDGE

2775.36 Co Record
2776.64 Meas.

#12049

APPROVED
LORAIN CO.
MAP DEPT.
DATE 9-12-78
PAGE 9-F
BY CAROLYN
VOID AFTER 12049

TM
3-13-79

064-A

064-B