


12079

-020 STILL EXISTS

~~NORTH RIDGE~~

#12079

APPROVED
LORAIN CO.
MAP DEPT.
DATE 9-22-78
PAGE 4-00-001 A
BY T. McNeil
VOID AFTER

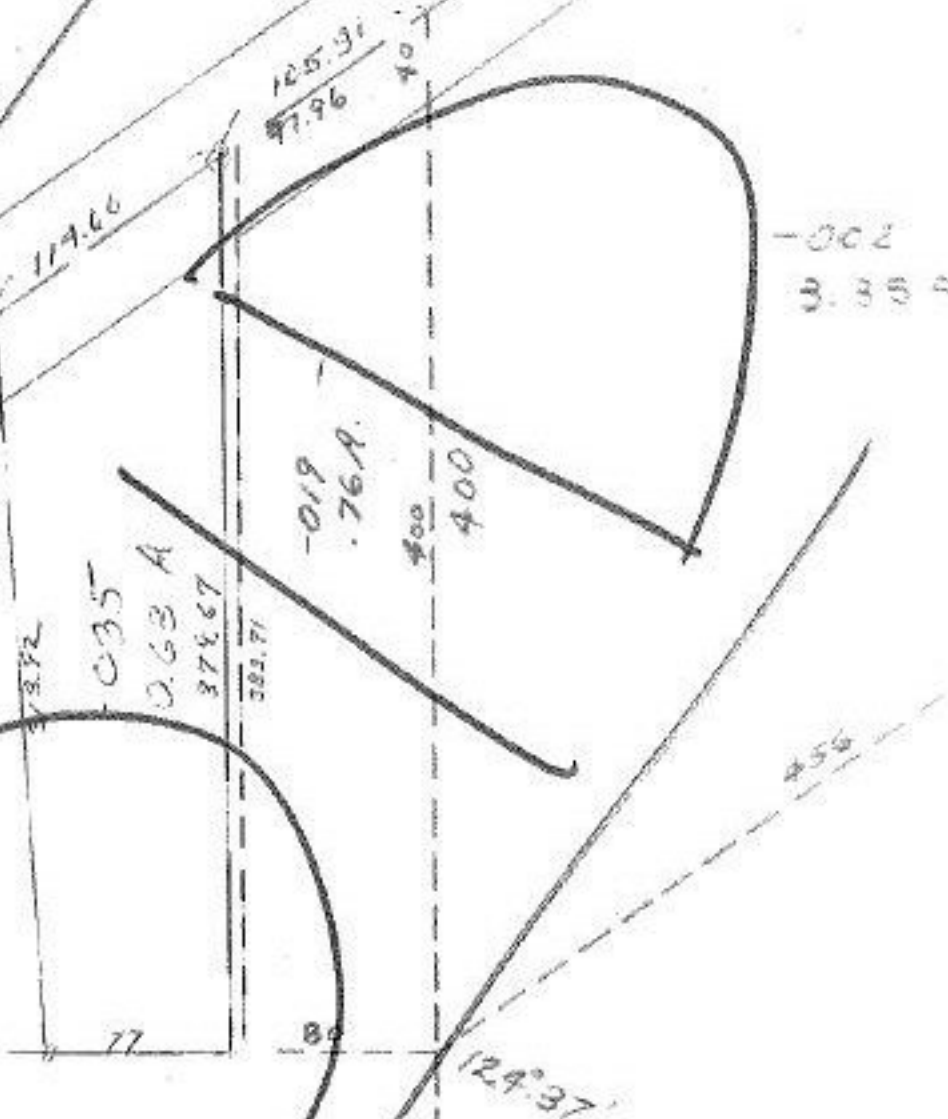

-002  
3.35 D

-036  
16.38 A.

3-6-79

6A.