

#12097

-003
37.68A.

-003
20.00A.

#12097


APPROVED LORAIN CO. MAP DEPT.
DATE 10-5-78
PAGE 13-B
BY T. McRair
VOID AFTER

MAR 13 1979

[Signature]
-010
35.21A.

280 -004 .51A
-005 .51A
-006 .51A
-007 .51A
280

801.33
250.23
551.08

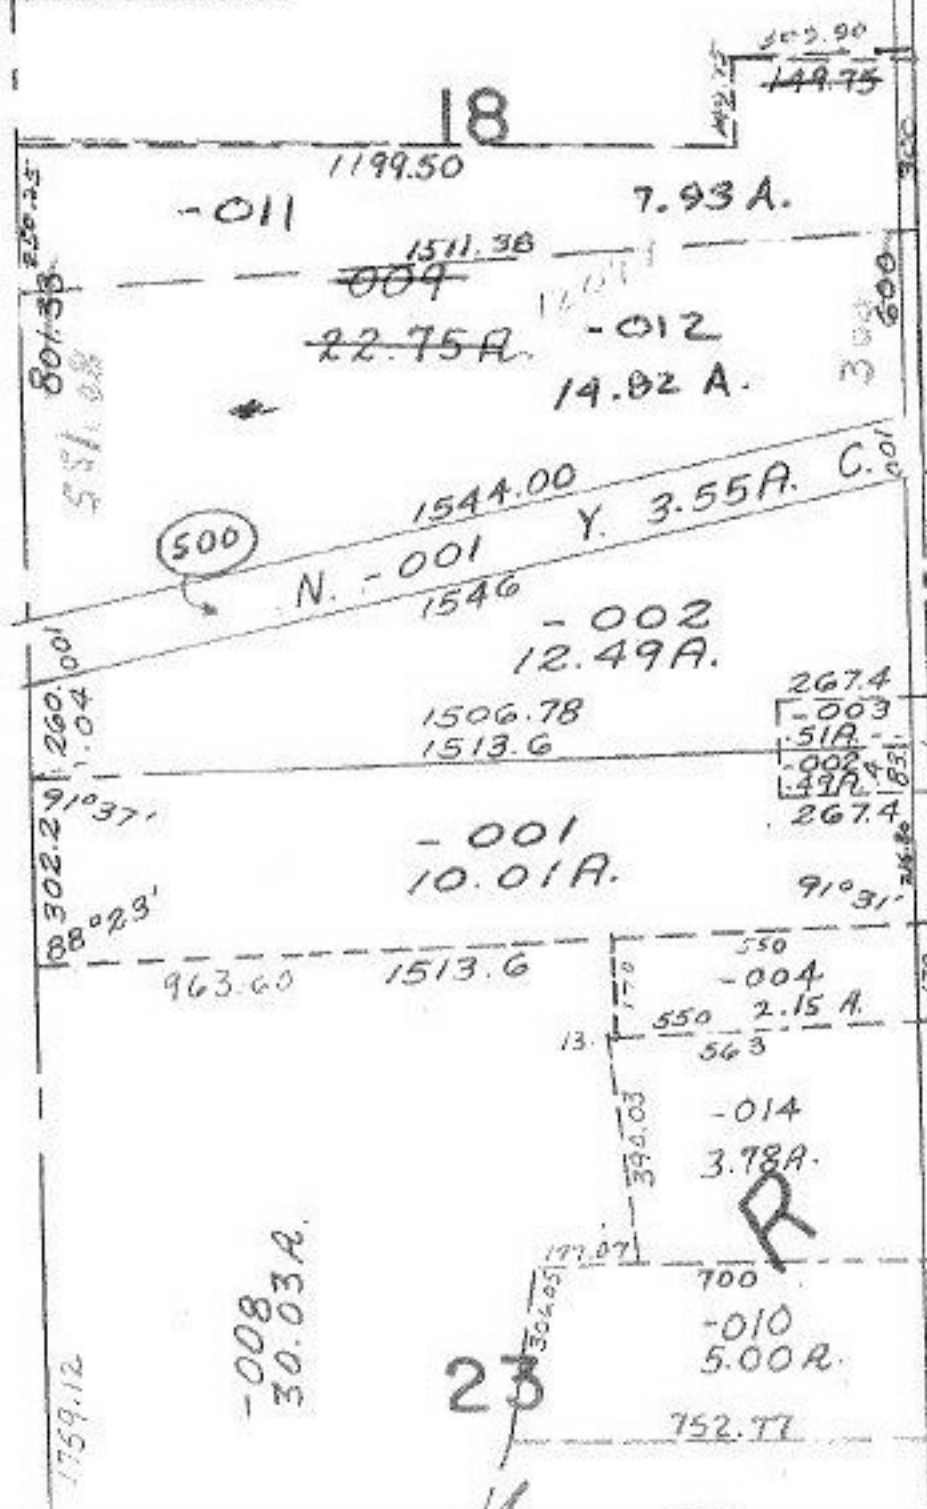

SEE 13-
HAIGH

C

A

R