




1. Res. 68-1010

DR.

BLVD.

SUB.

NO. 1

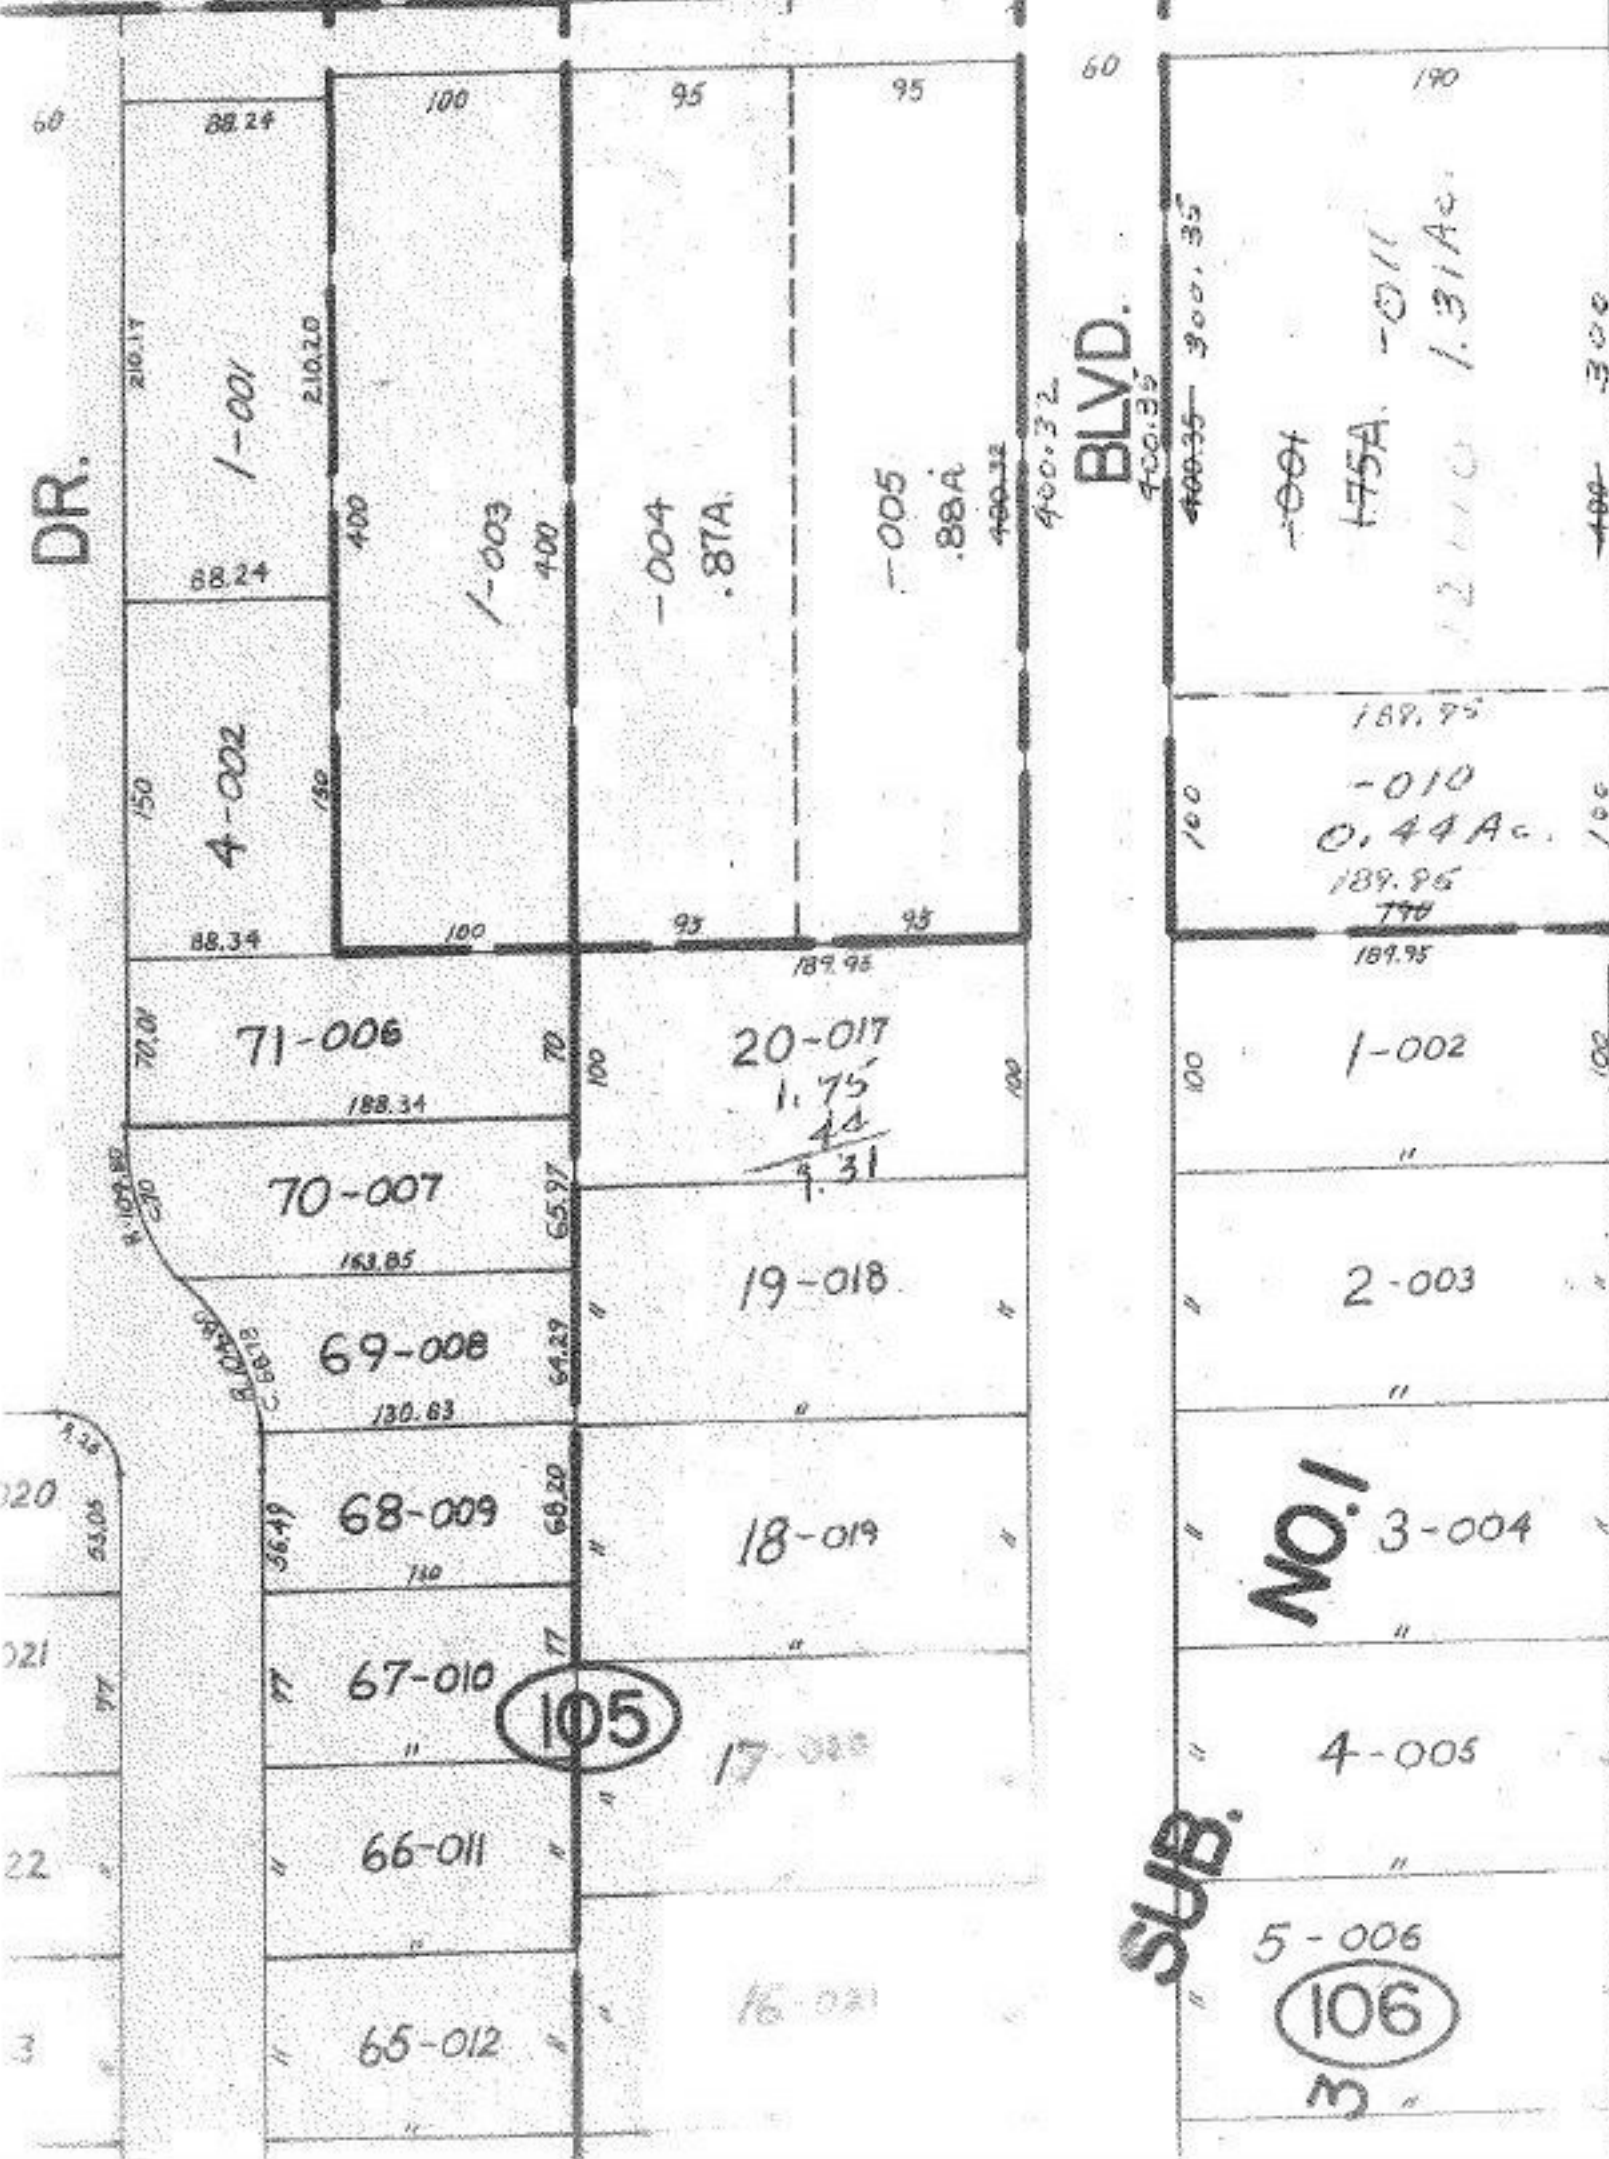

#12110

APPROVED
LORAIN CO.
MAP DEPT.

DATE 10-5-78

PAGE 5-00-080 B

BY *[Signature]*

VOID
AFTER

MAY 8 1979

[Signature]

105

106

3