


#12149

1343.47

17
175
275
60
DURKEE

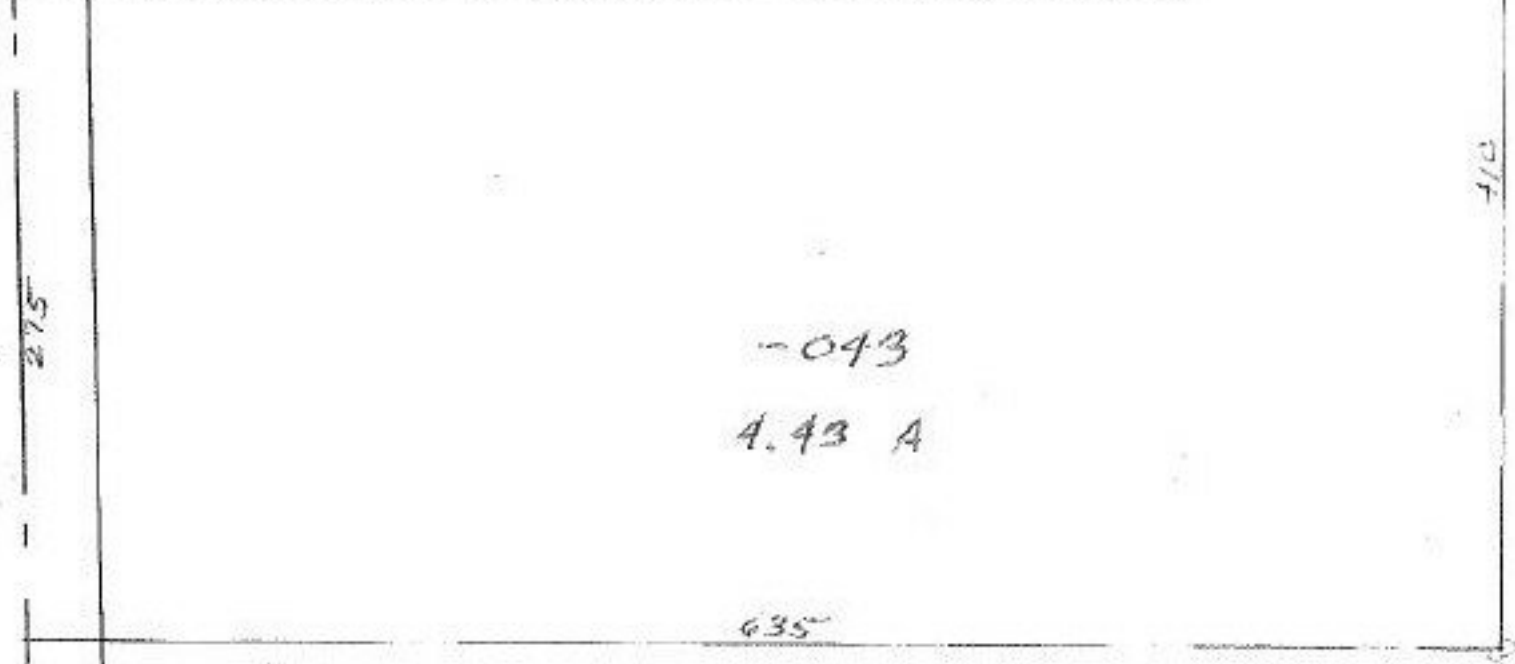

~~-040~~
~~26.41A~~
~~-042~~
~~25.64A~~
~~-044~~
 21.21A

19567

#12149

APPROVED LORAIN CO. MAP DEPT.	
DATE 10-17-78	
PAGE 11-00-076-A	
BY F. McRae	
VOID AFTER	

MAR 22 1979

1380

SEE 11-00