


MURRAY RIDGE

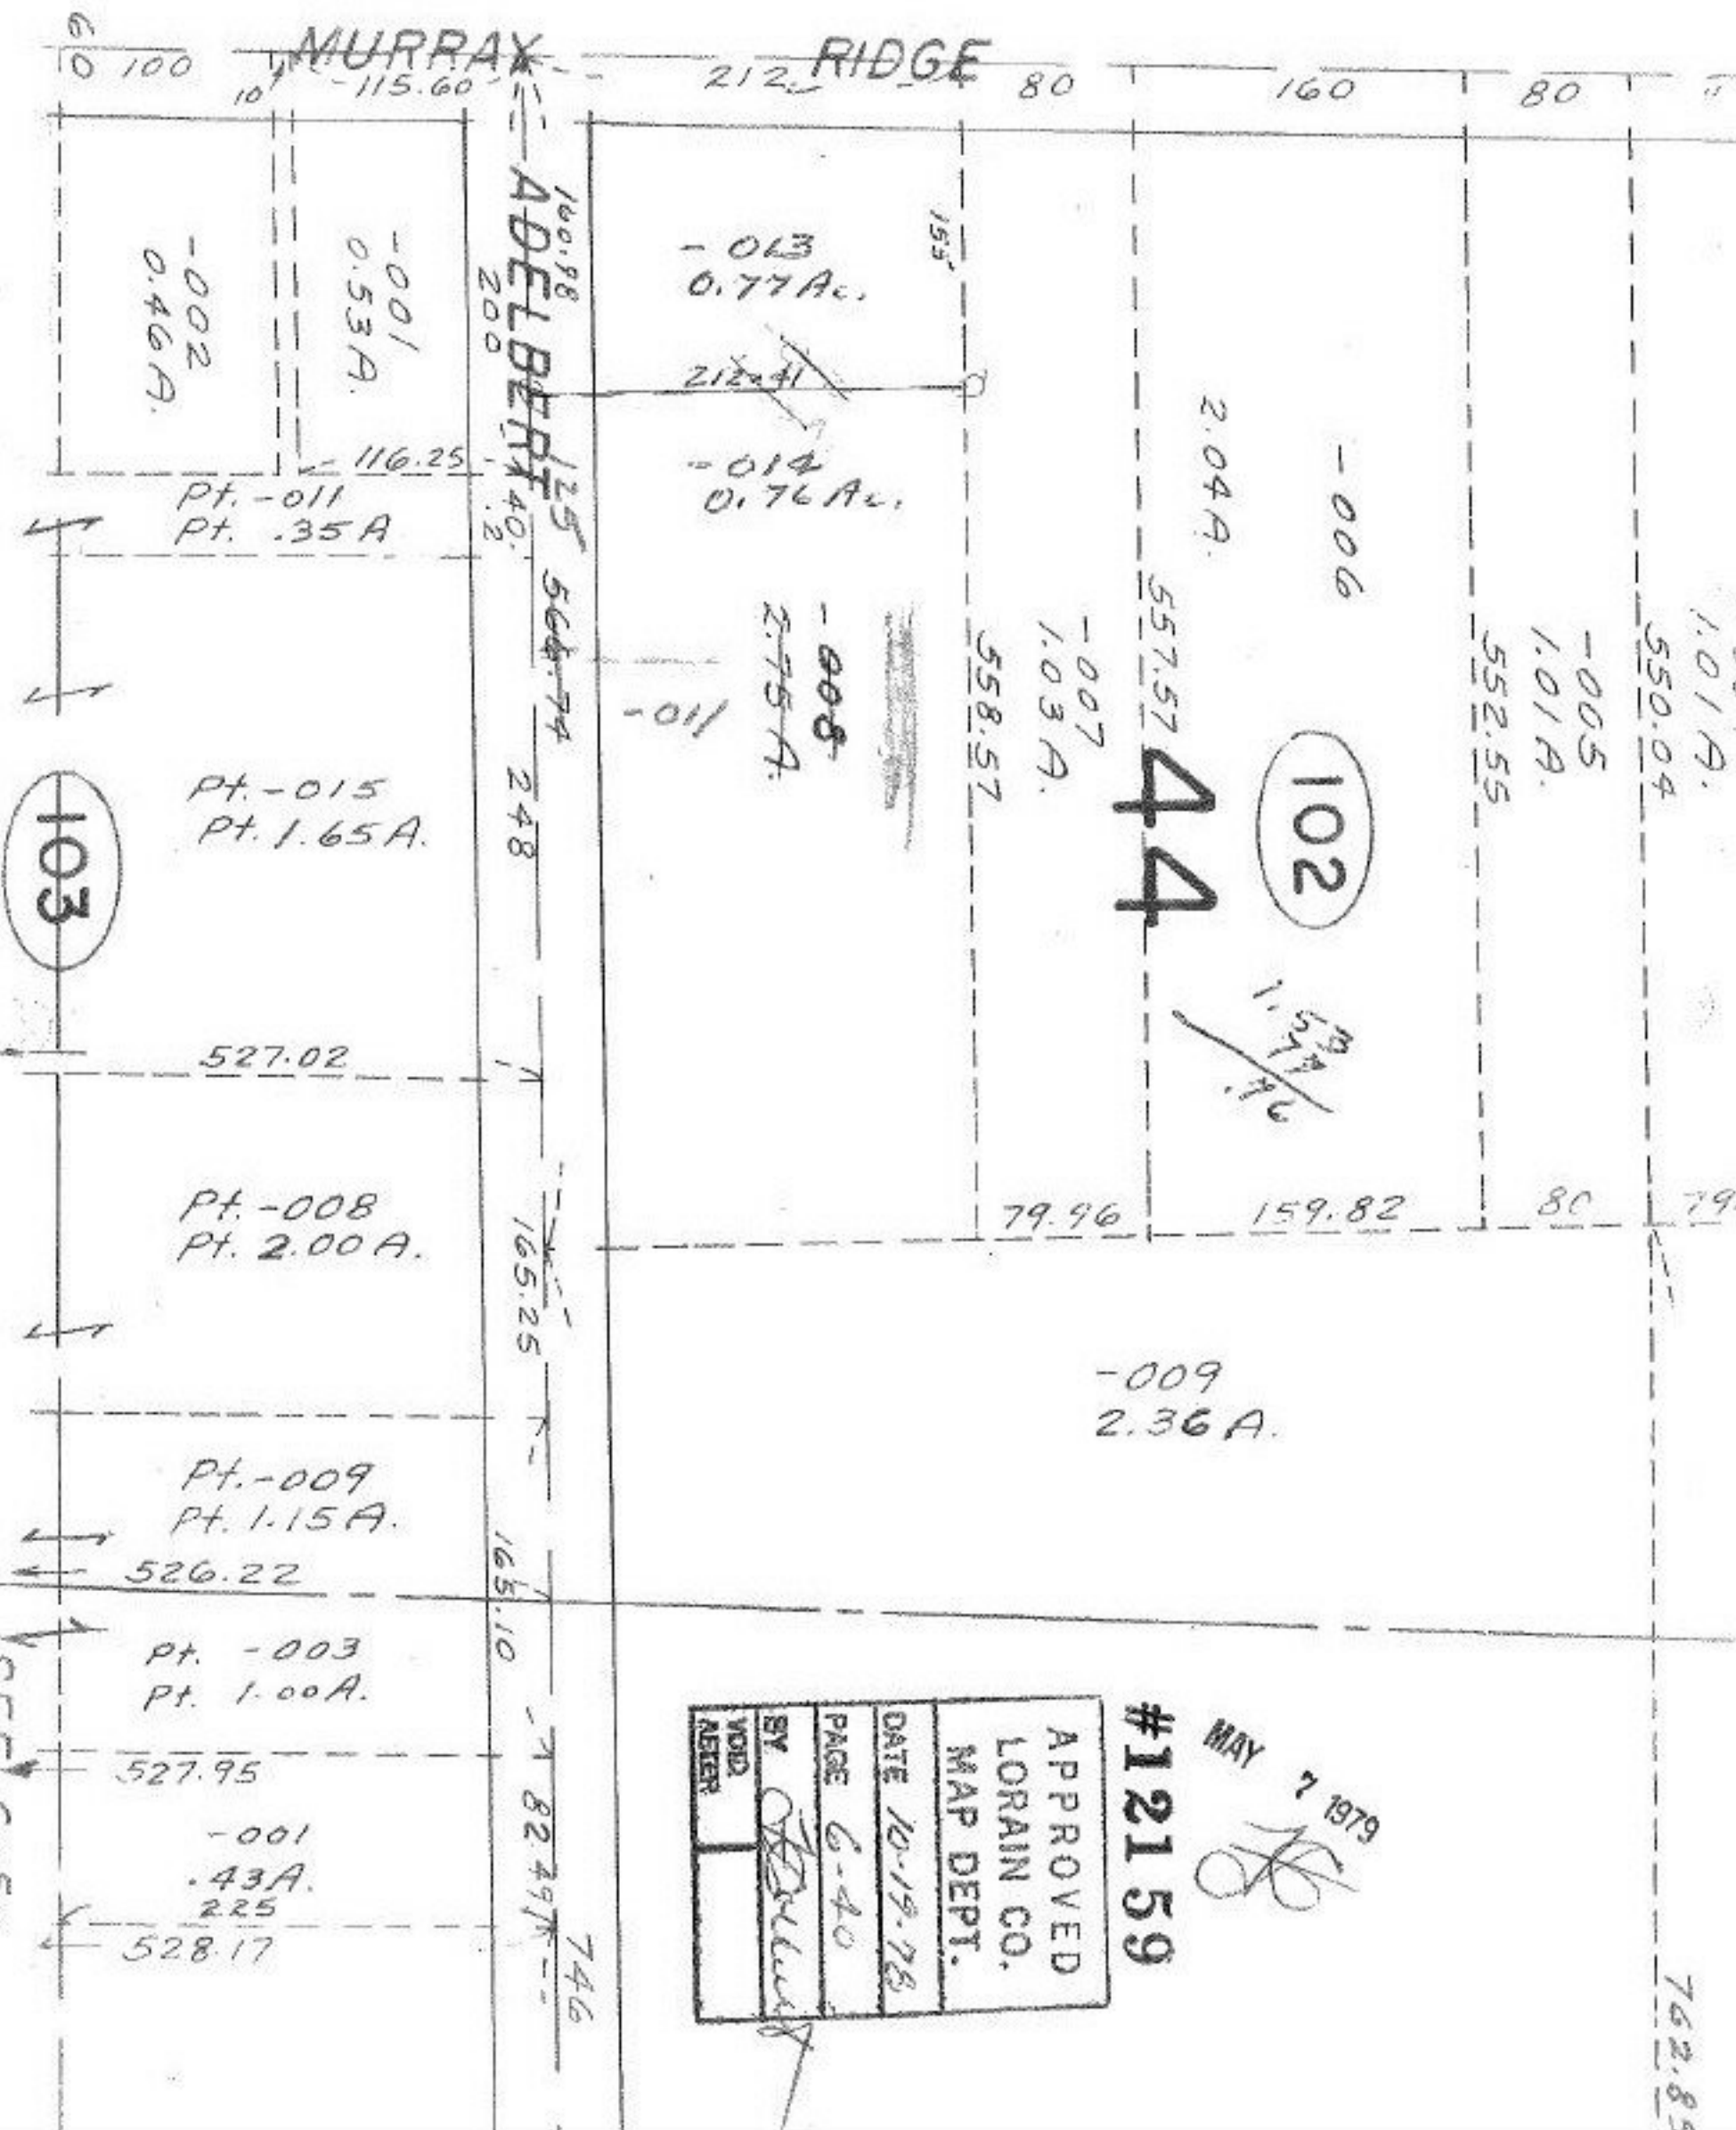

DATE	10-19-78
PAGE	6-40
BY	<i>[Signature]</i>
VOID	<input type="checkbox"/>
ASTER	<input type="checkbox"/>

#12159

APPROVED  
LORAIN CO.  
MAP DEPT.

MAY 7 1979

*[Signature]*

SEE 6-58

762.85