


#12185

#12185

APPROVED
LORAIN CO.
MAP DEPT.
DATE 11-2-78
PAGE 10-00-015-D
BY T. McLean
REVIS AFTER

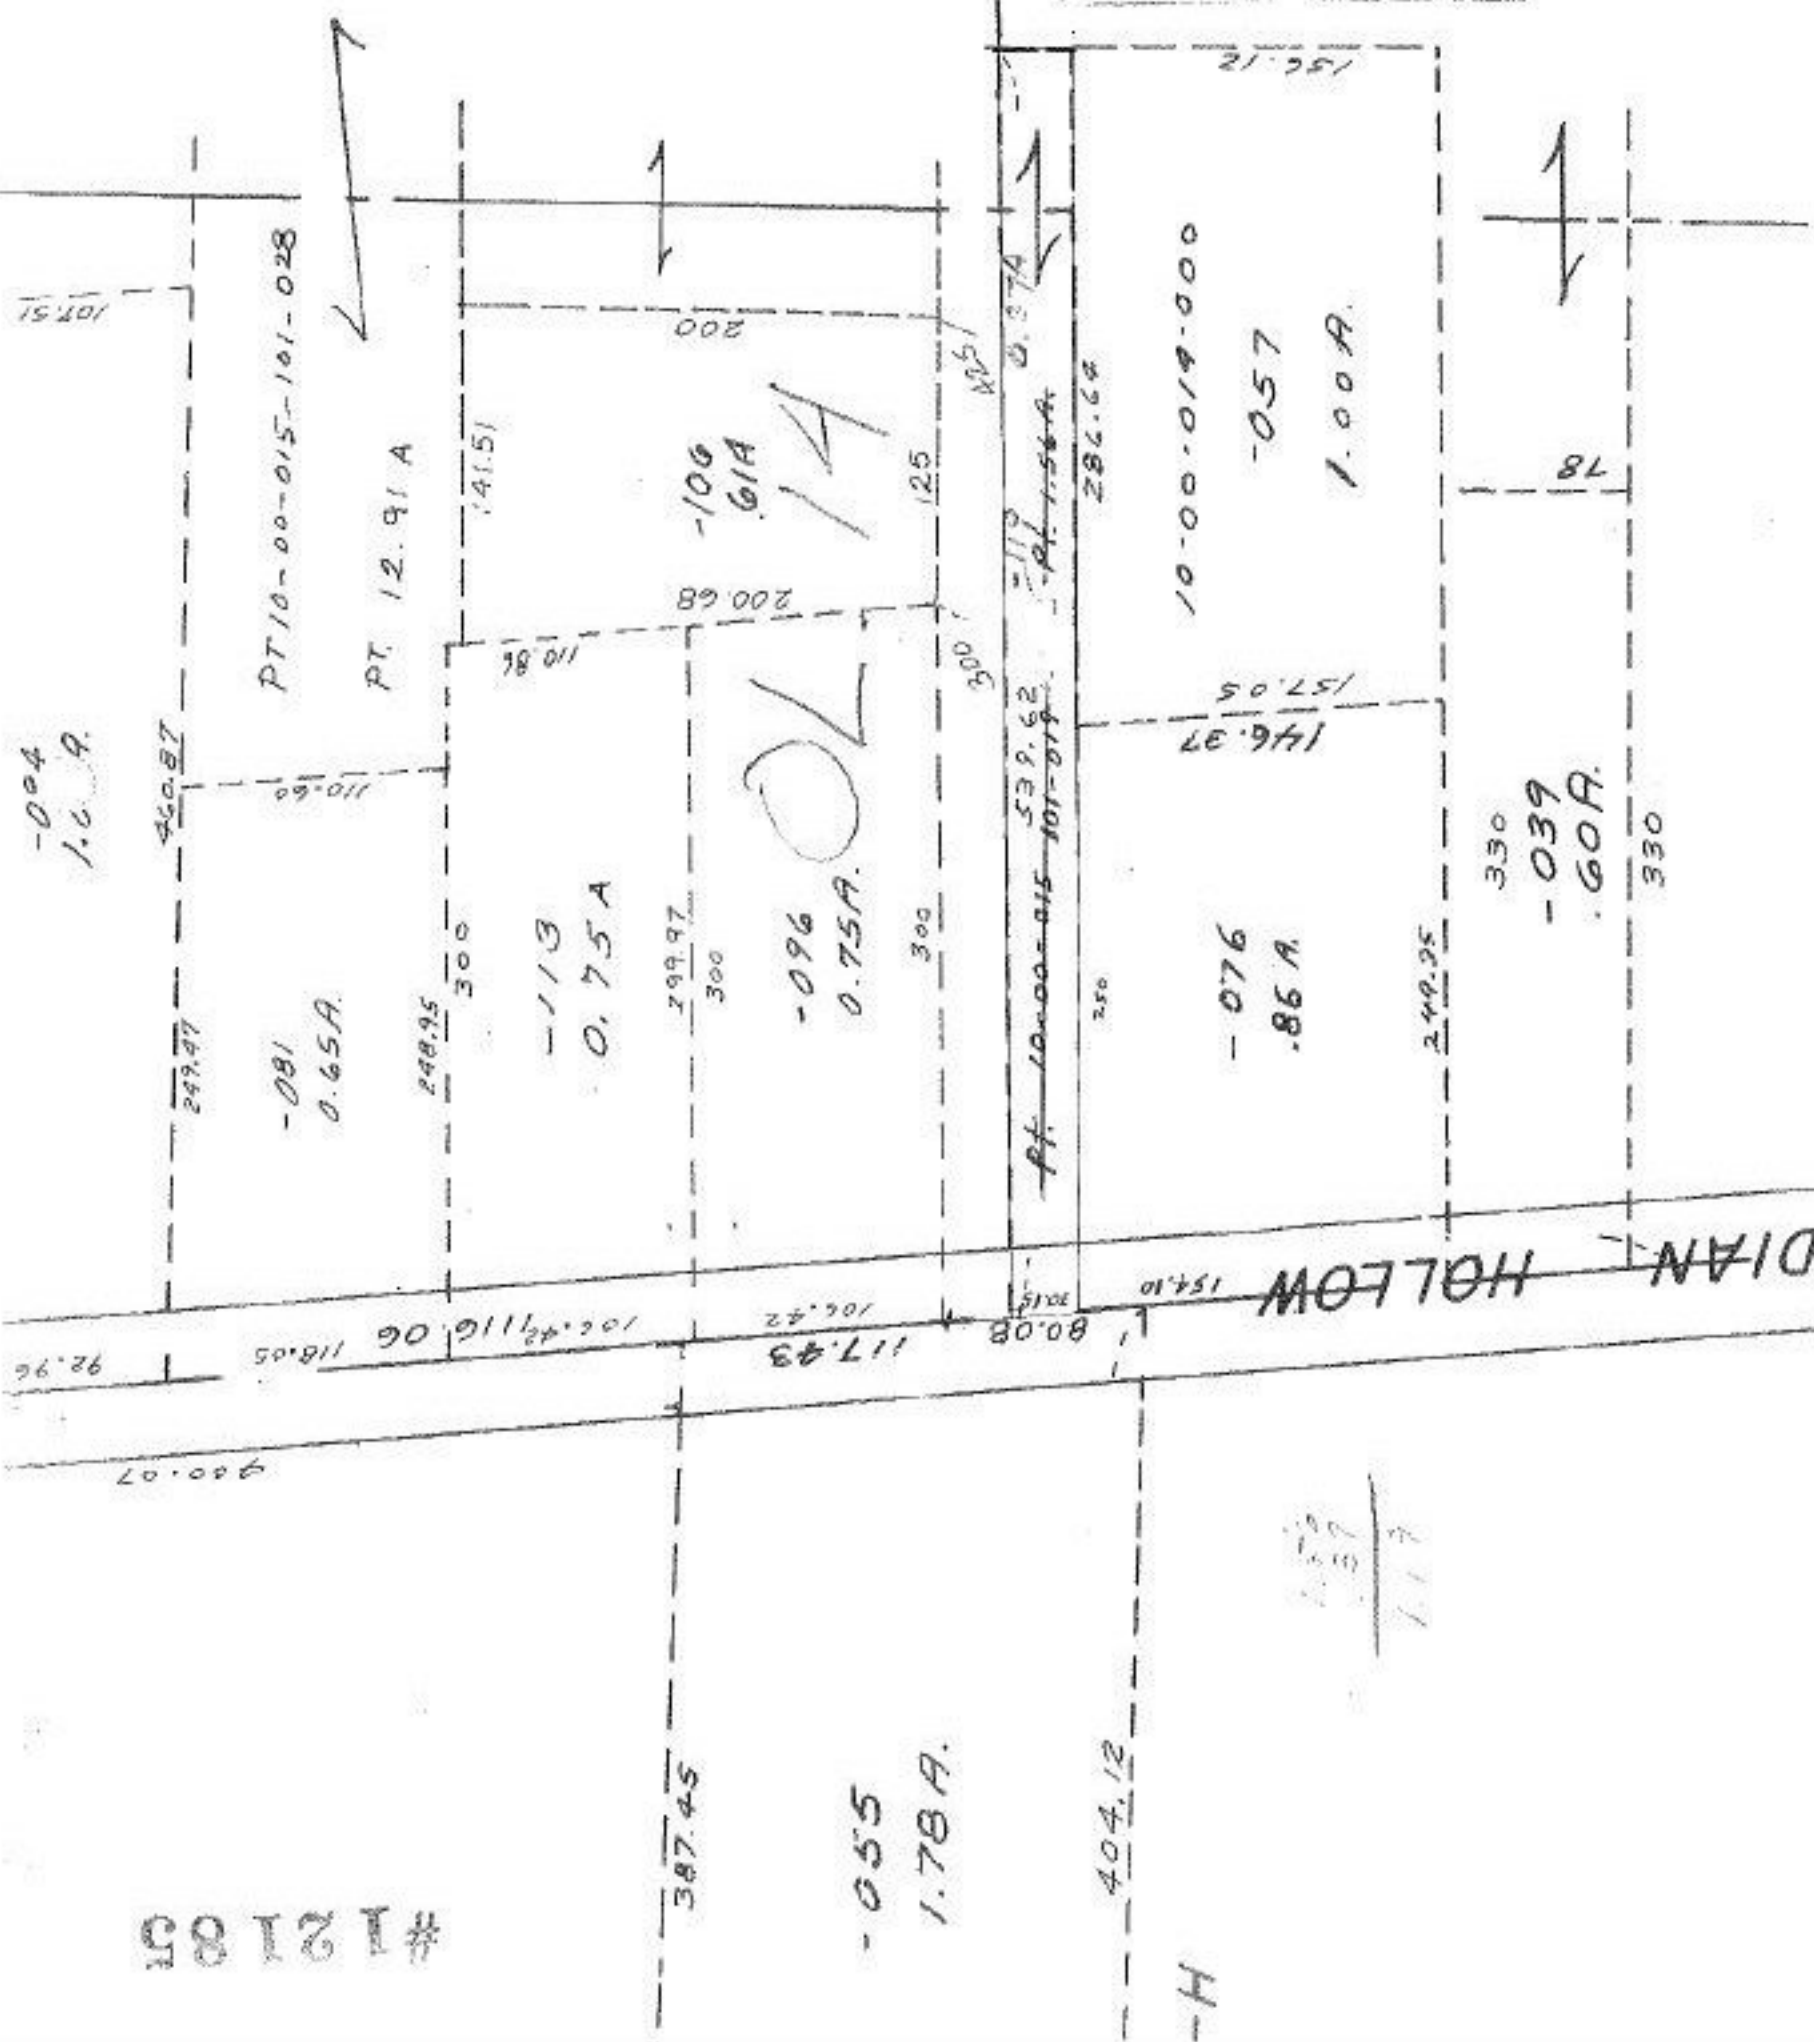

1.57
1.57
1.17