


#12187

T.H.
A.5.79

2050
121

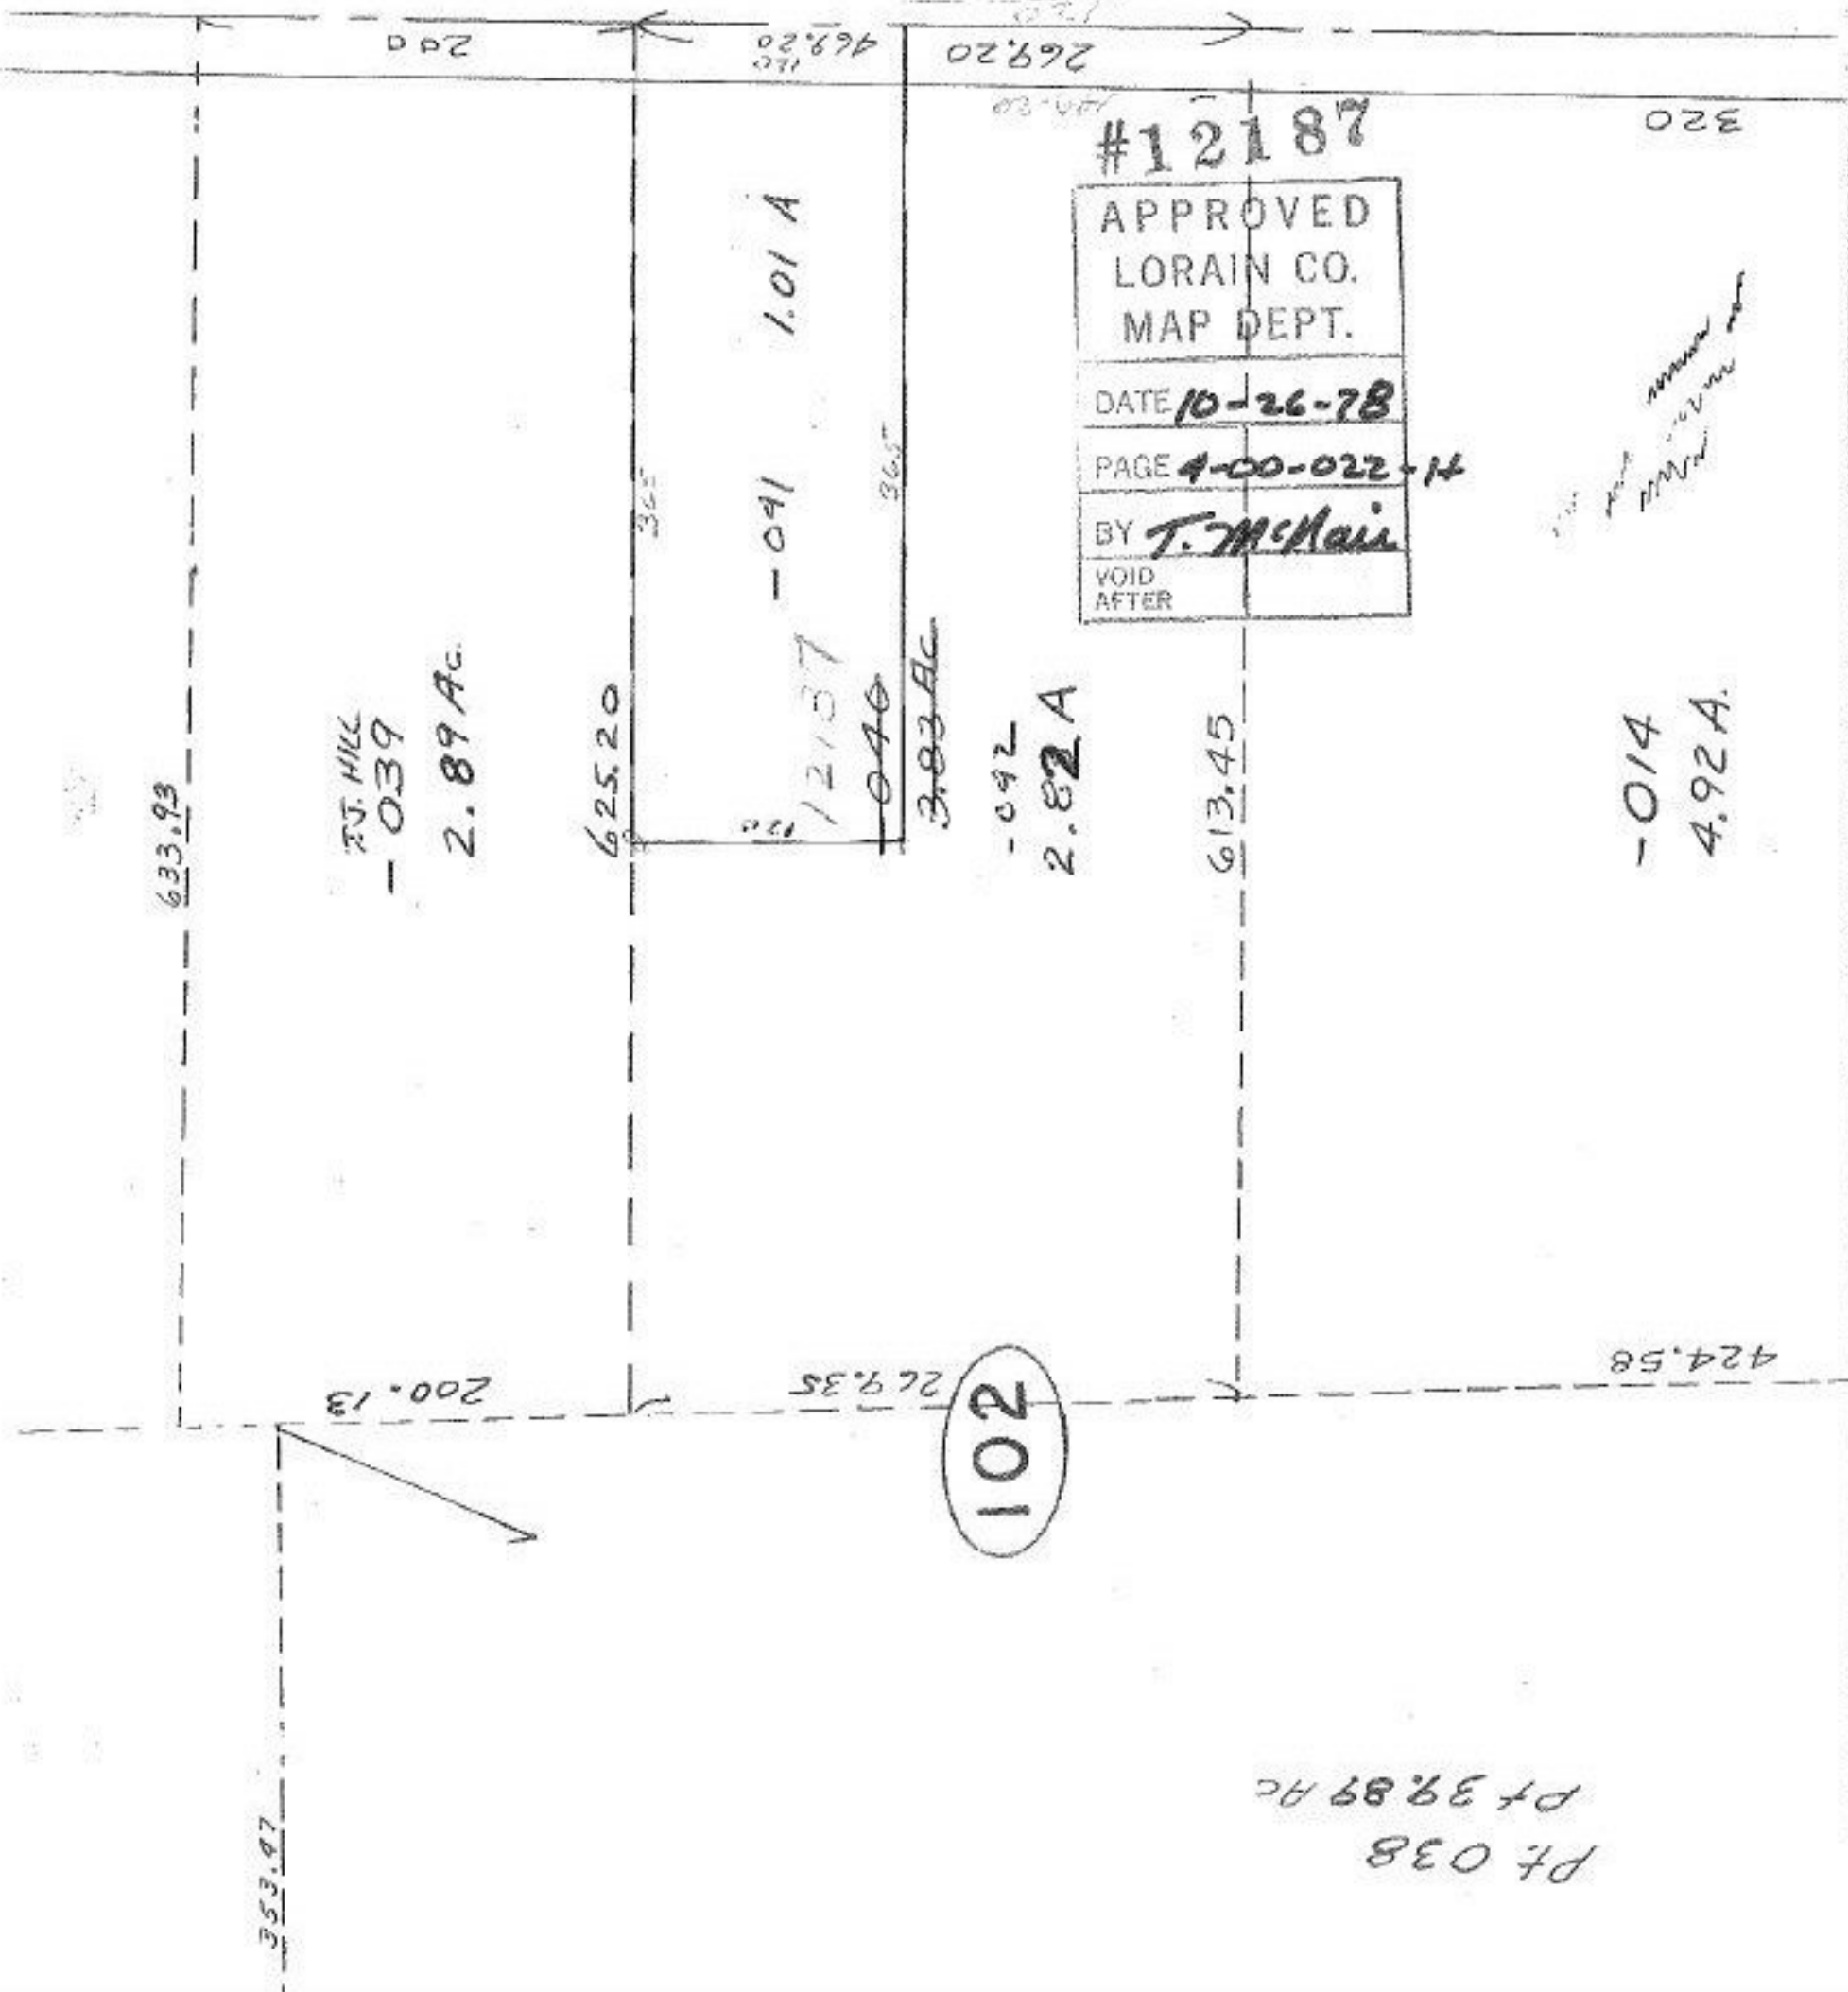

#12187

APPROVED
LORAIN CO.
MAP DEPT.

DATE 10-26-78

PAGE 4-00-022-14

BY T. McNeil

VOID
AFTER

Handwritten notes:
...
...
...

633.93

T.J. HILL
- 0.39
2.89 AC

625.20

1.01 A

- 0.41

12187

0.40

3.83 AC

- 0.42
2.82 A

613.45

- 0.14
4.92 A.

102

200.13

269.35

424.58

353.97

Pf 038
Pf 39.89 AC