


*12203

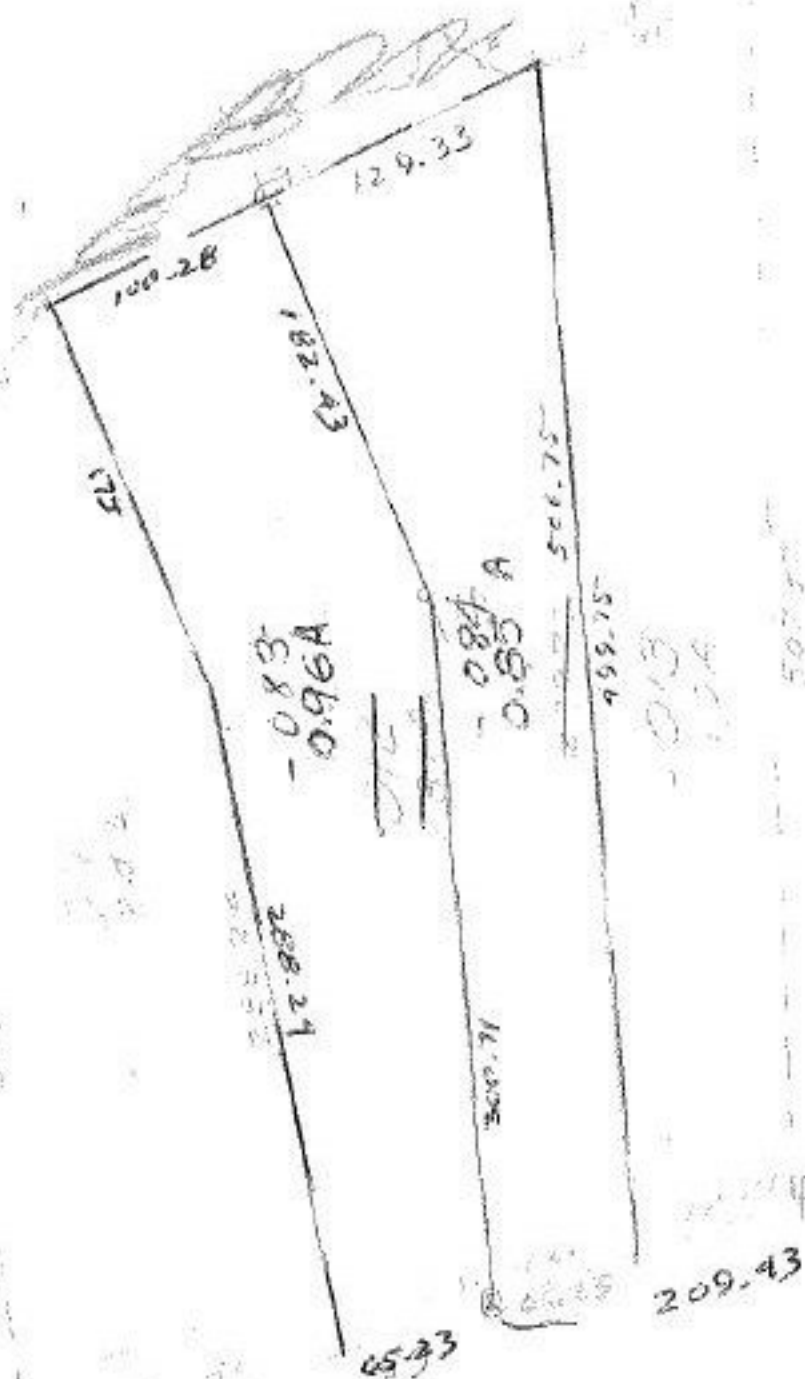

SEE PLAN 005-B

#12203

APPROVED	
ECON CO.	
DEPT.	
DATE 11-24-78	
PAGE 4 of 100-A	
BY Carolyn J.	
VOID	12203
AFTER	

T.M.
11-2-79

-0.83
0.96 A

-0.84
0.85 A