

WYBERRY

#12248

HILL VOL 3
SUBDIVISION PGS 25-26

HILL
43-027
44-028
45-029
46-030

FIESTA

SUBDIVISION

APPROVED
LORAIN CO.
SEAL DEPT.

DATE 11-17-78
PRICE 5-00-000-B
BY T. McRae
VOID AFTER

NO. 3

103



107

STREET

DED. PLAT

DRIV

COURT

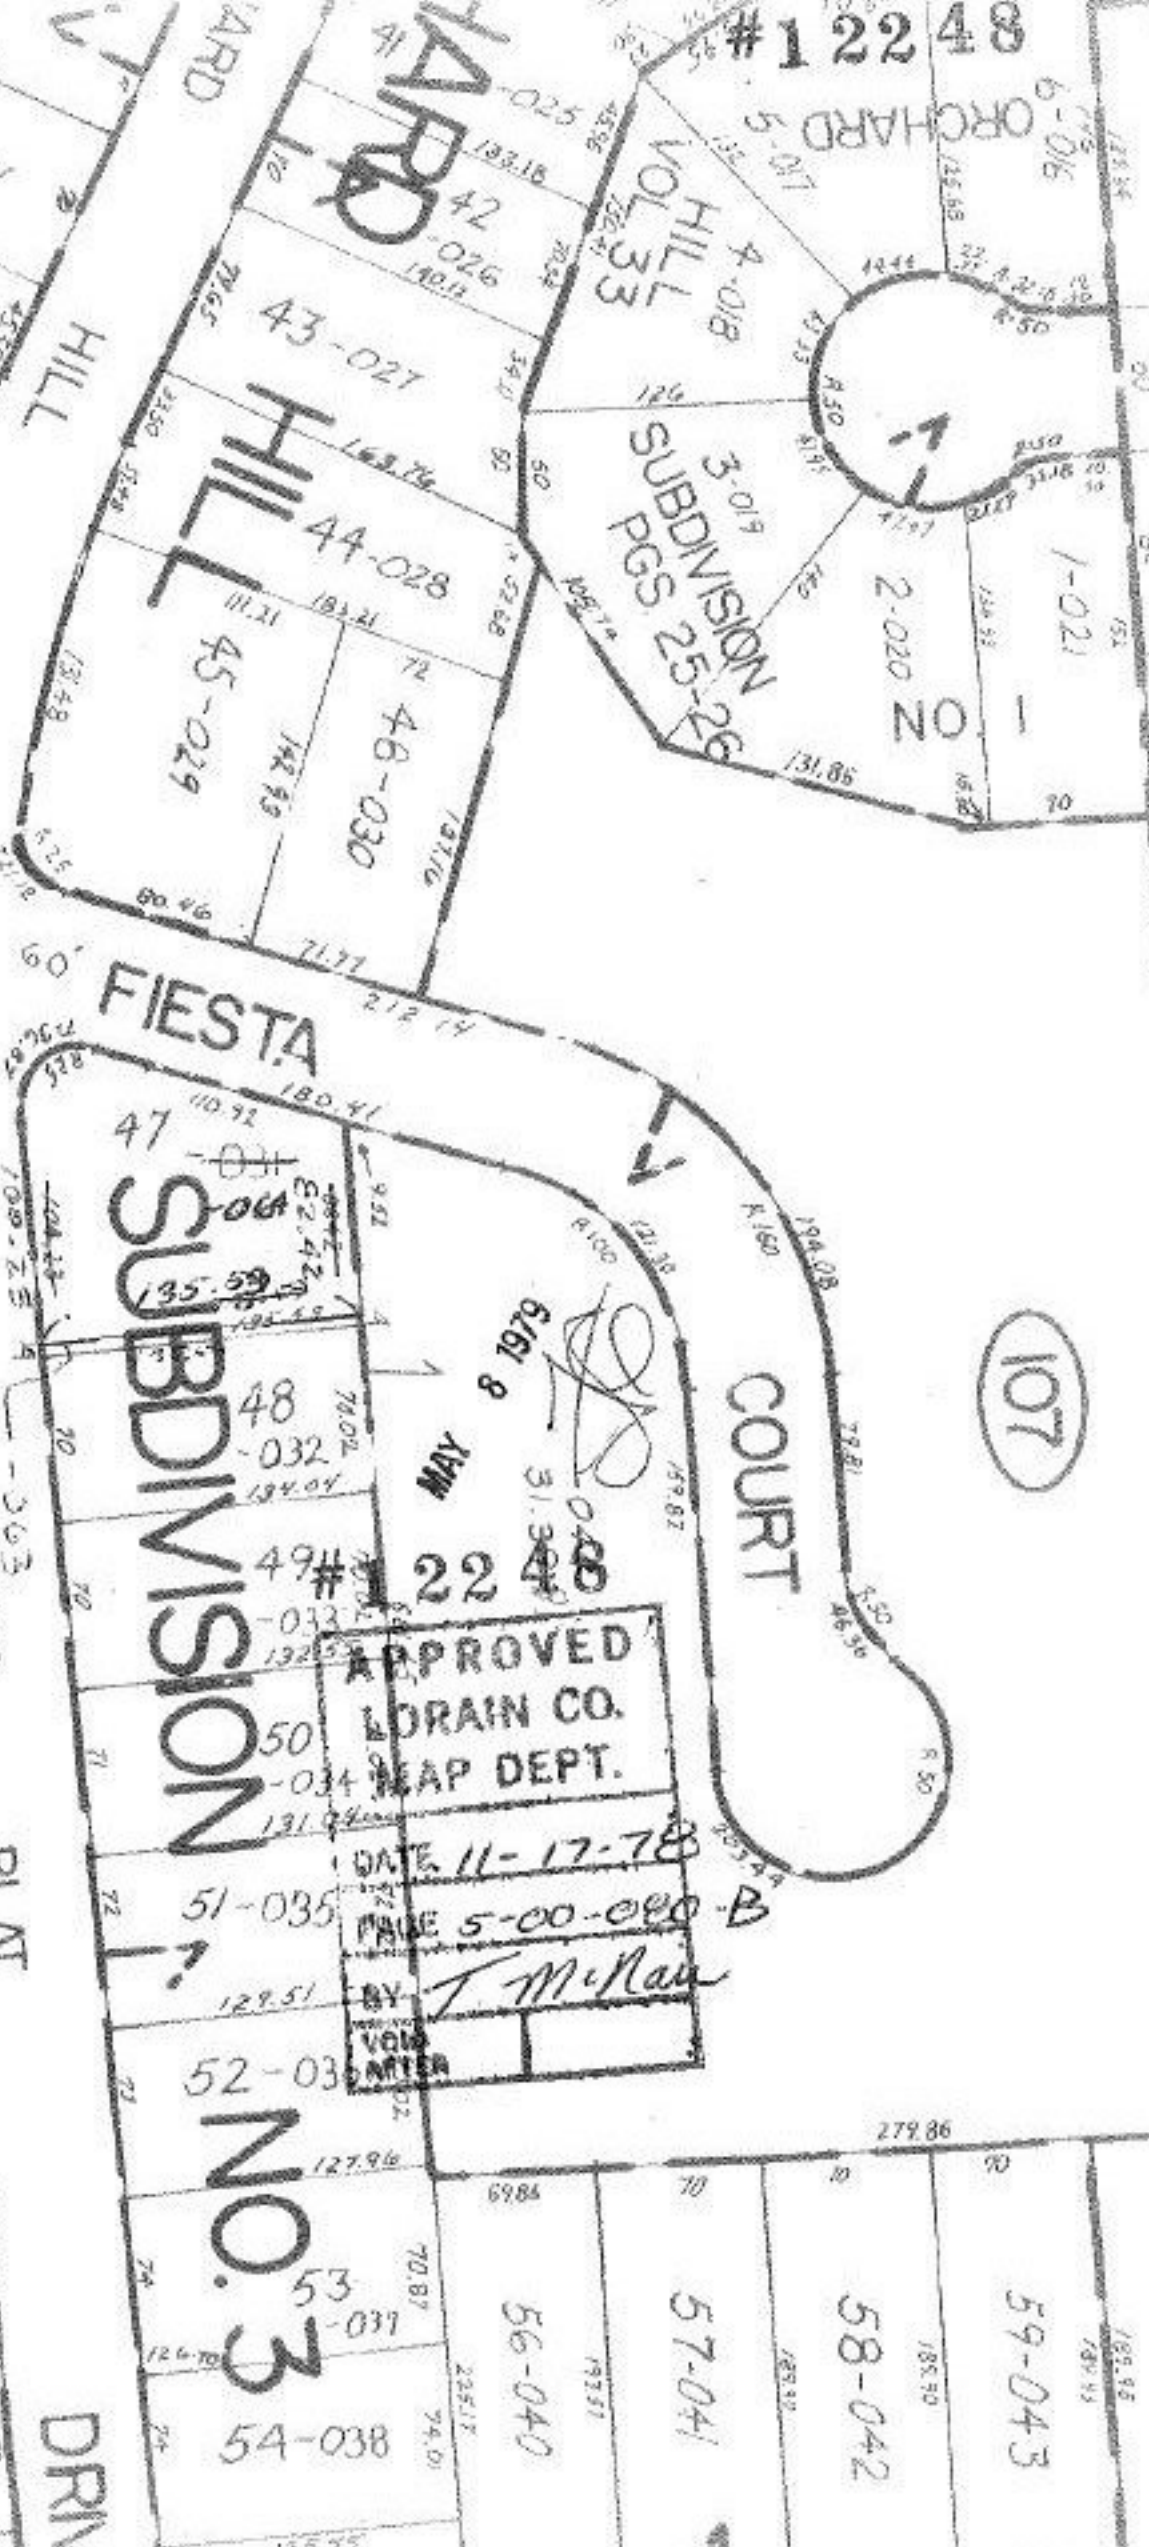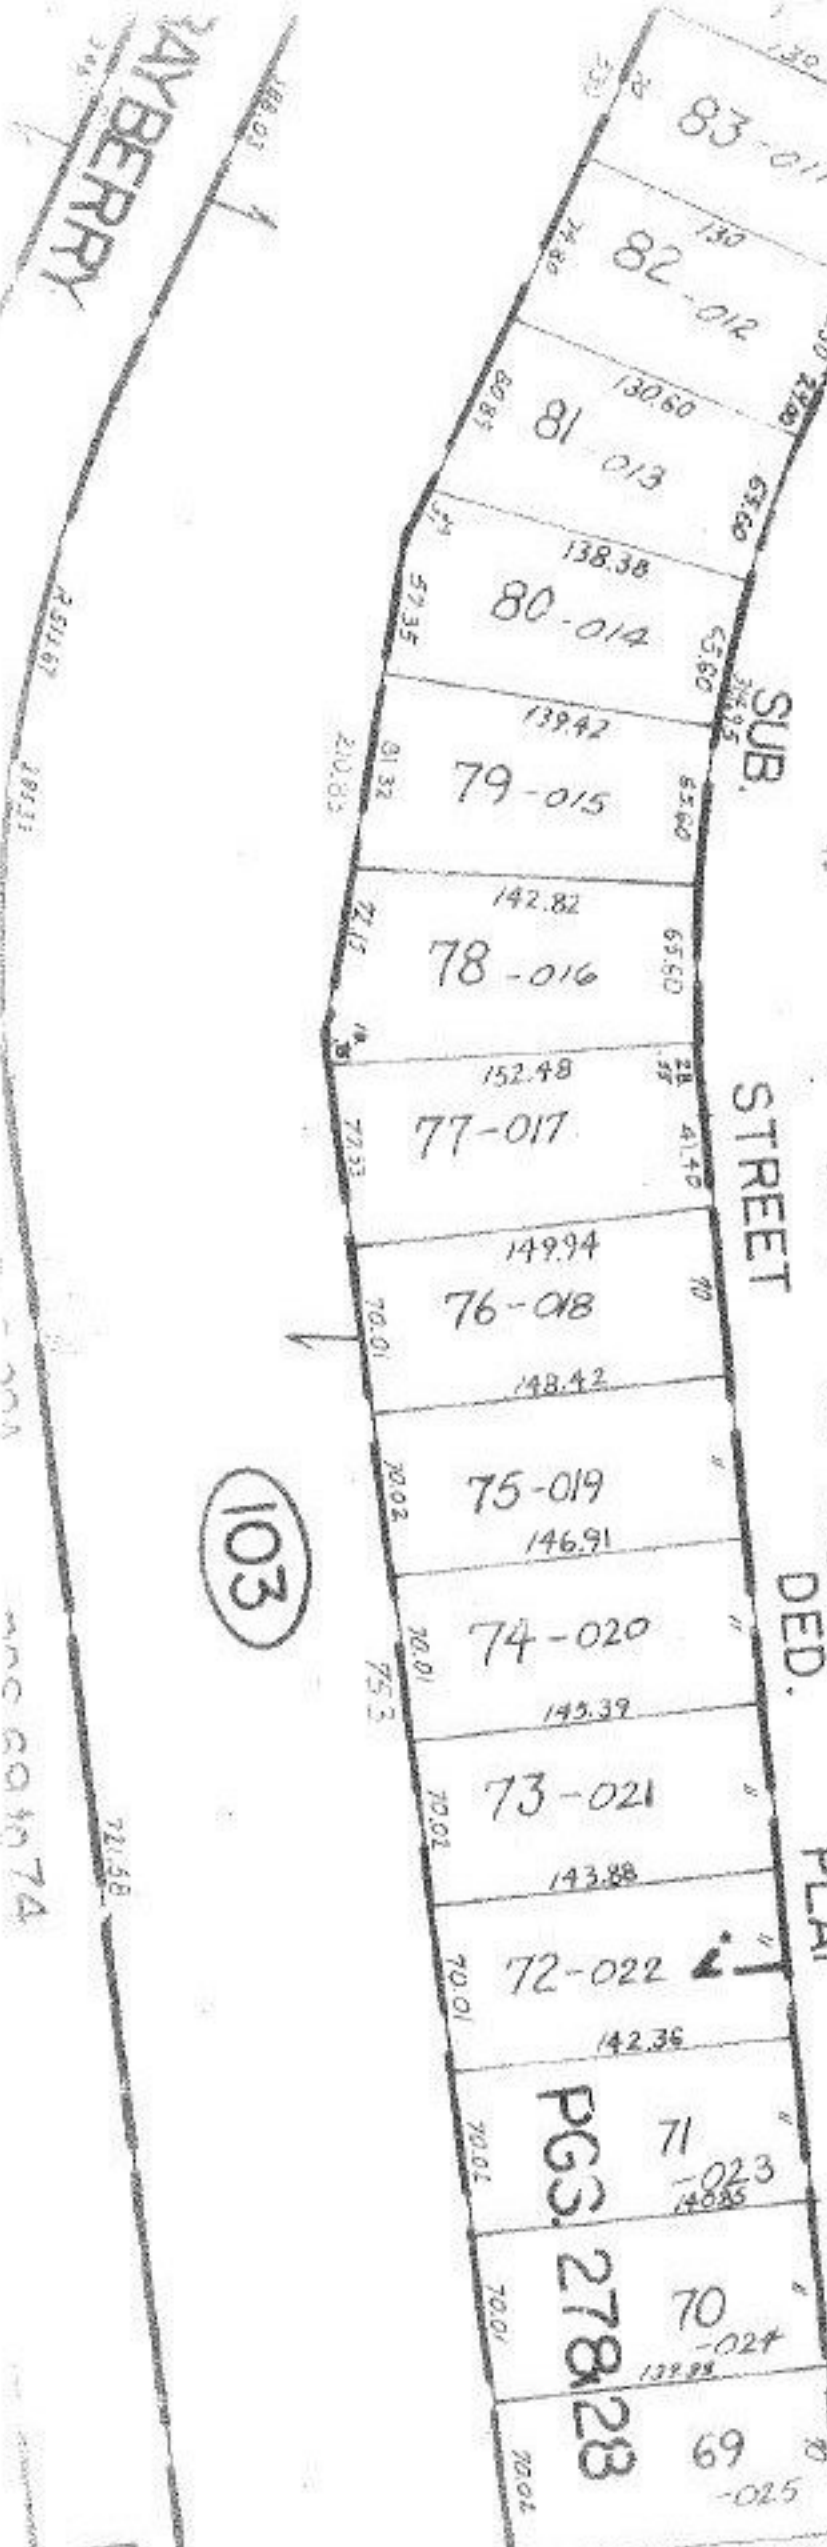

AND GO TO 74

F