


ISLAND

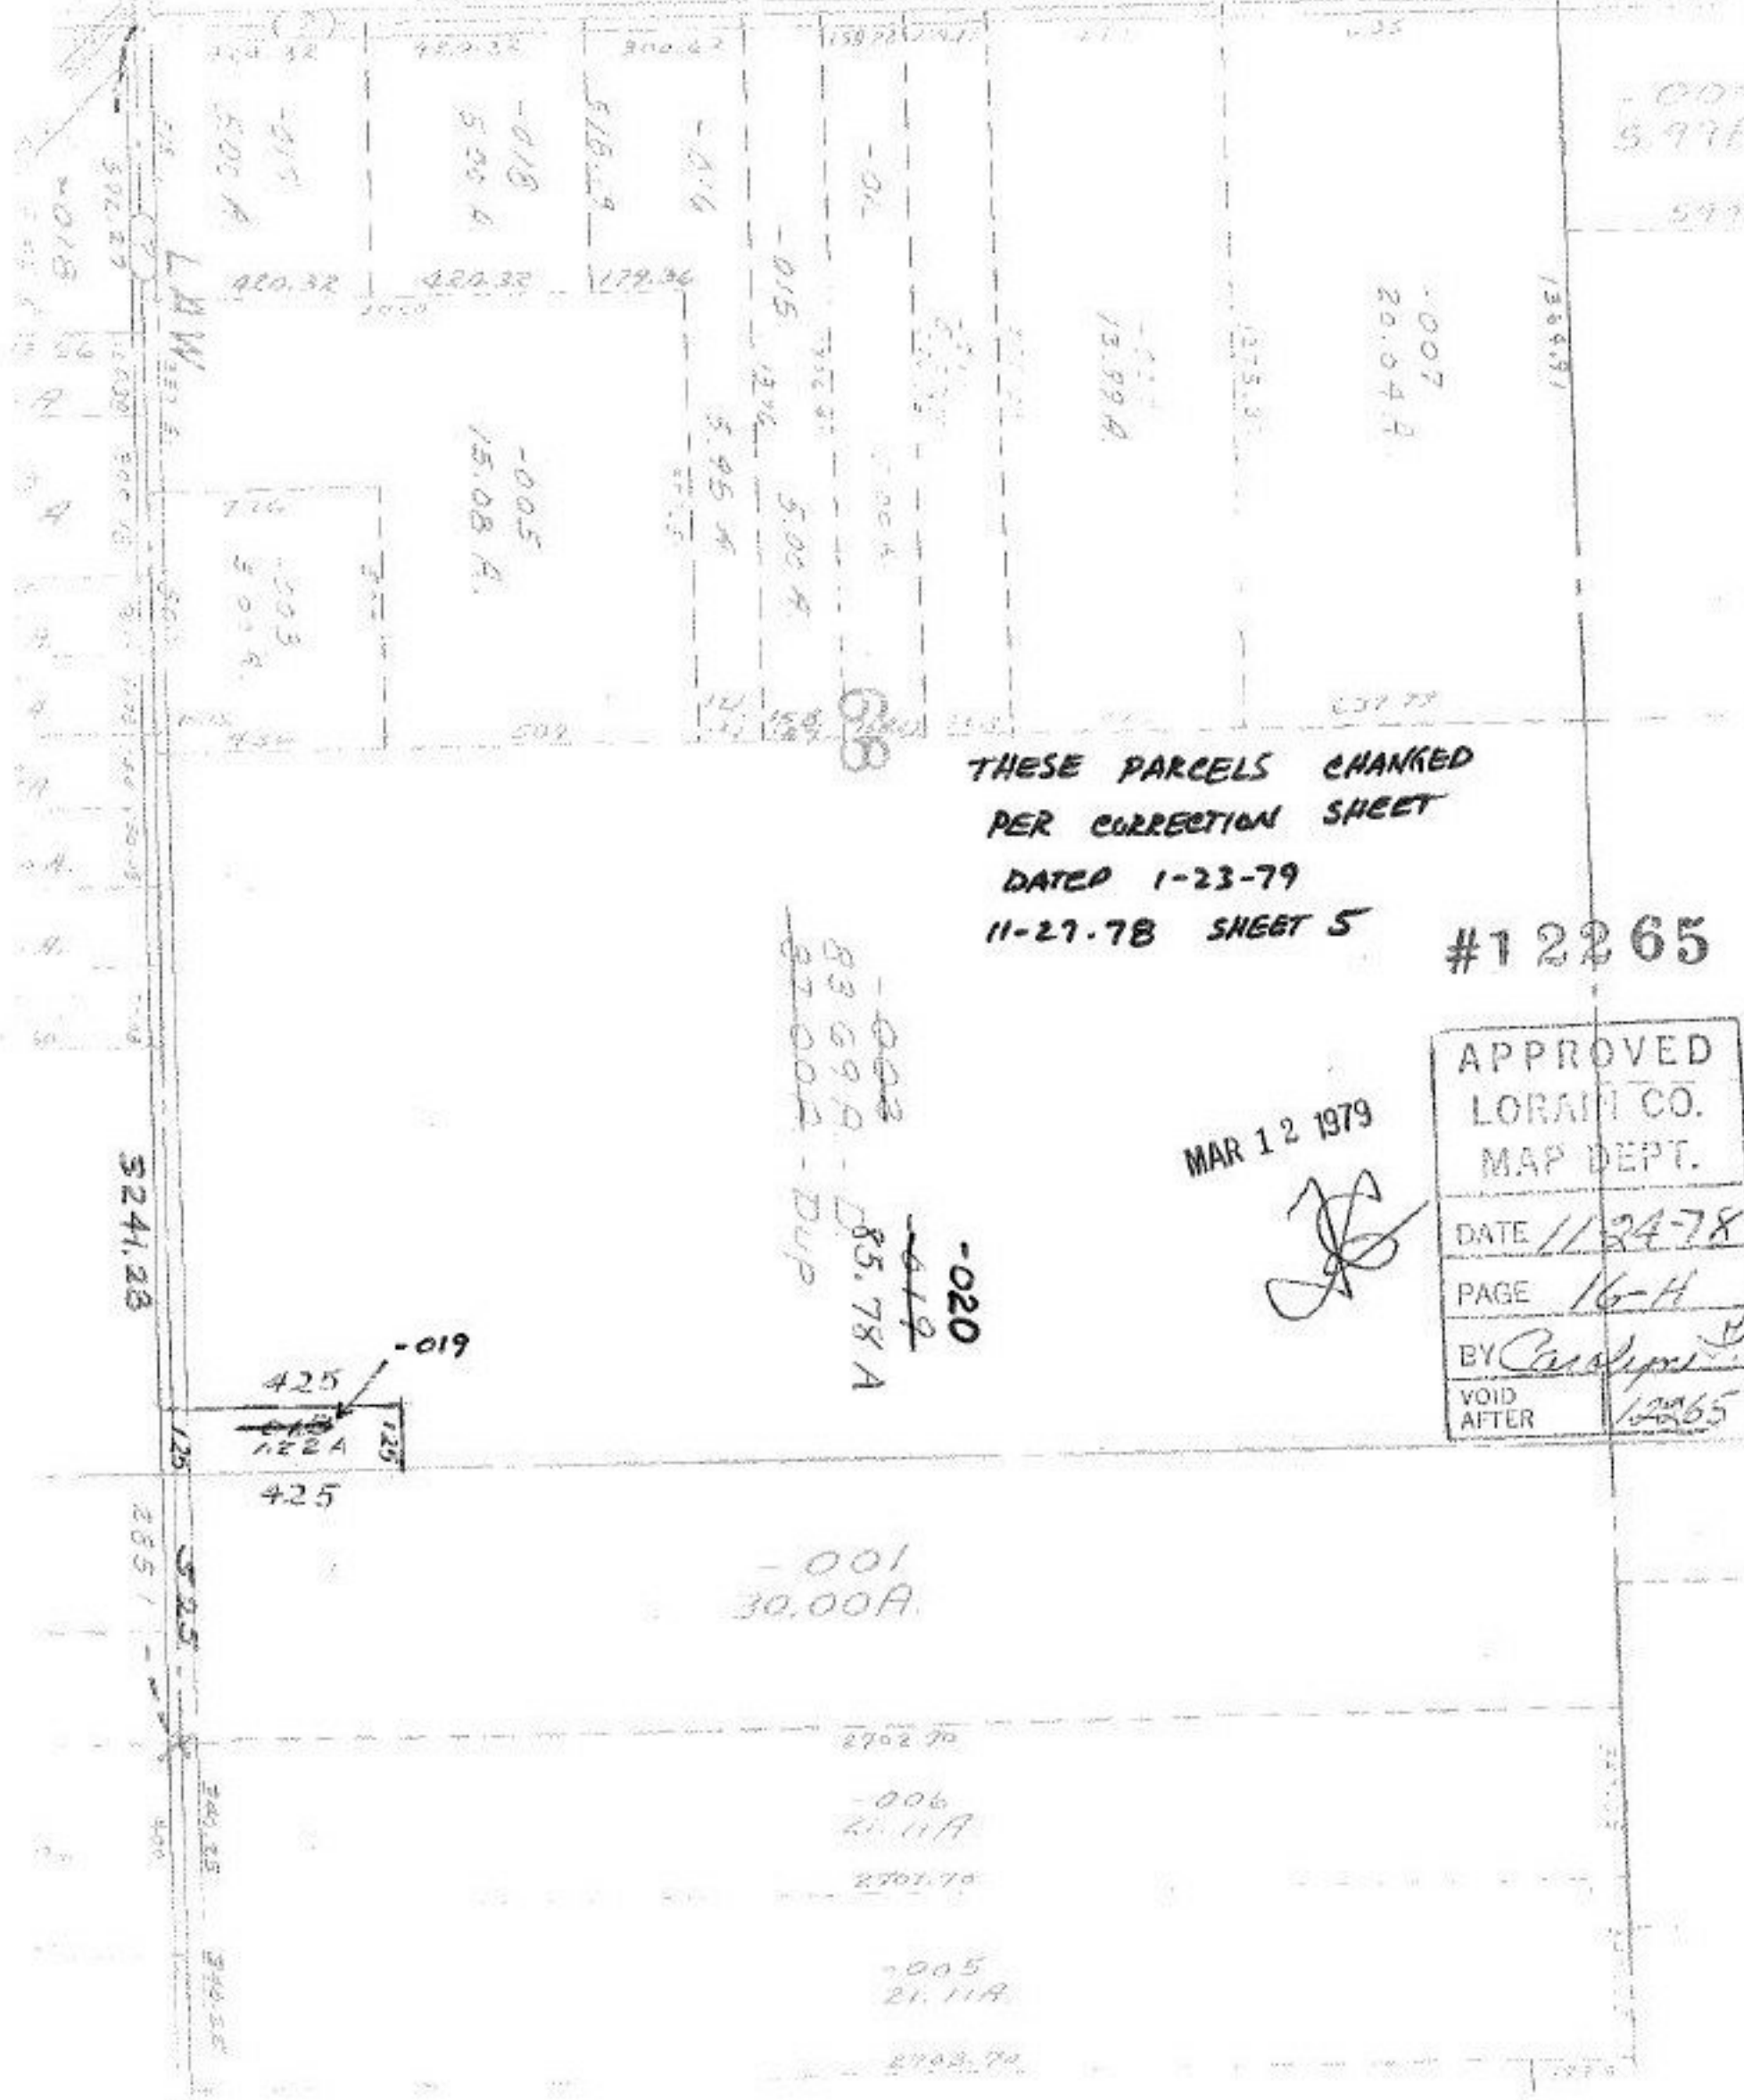

THESE PARCELS CHANGED
 PER CORRECTION SHEET
 DATED 1-23-79
 11-27-78 SHEET 5

#12265

MAR 12 1979

APPROVED LORAIN CO. MAP DEPT.	
DATE	11-24-78
PAGE	16-H
BY	<i>[Signature]</i>
VOID AFTER	12265