


MILLER

450.45

D. 12266

see plat map to work on Walker Road.

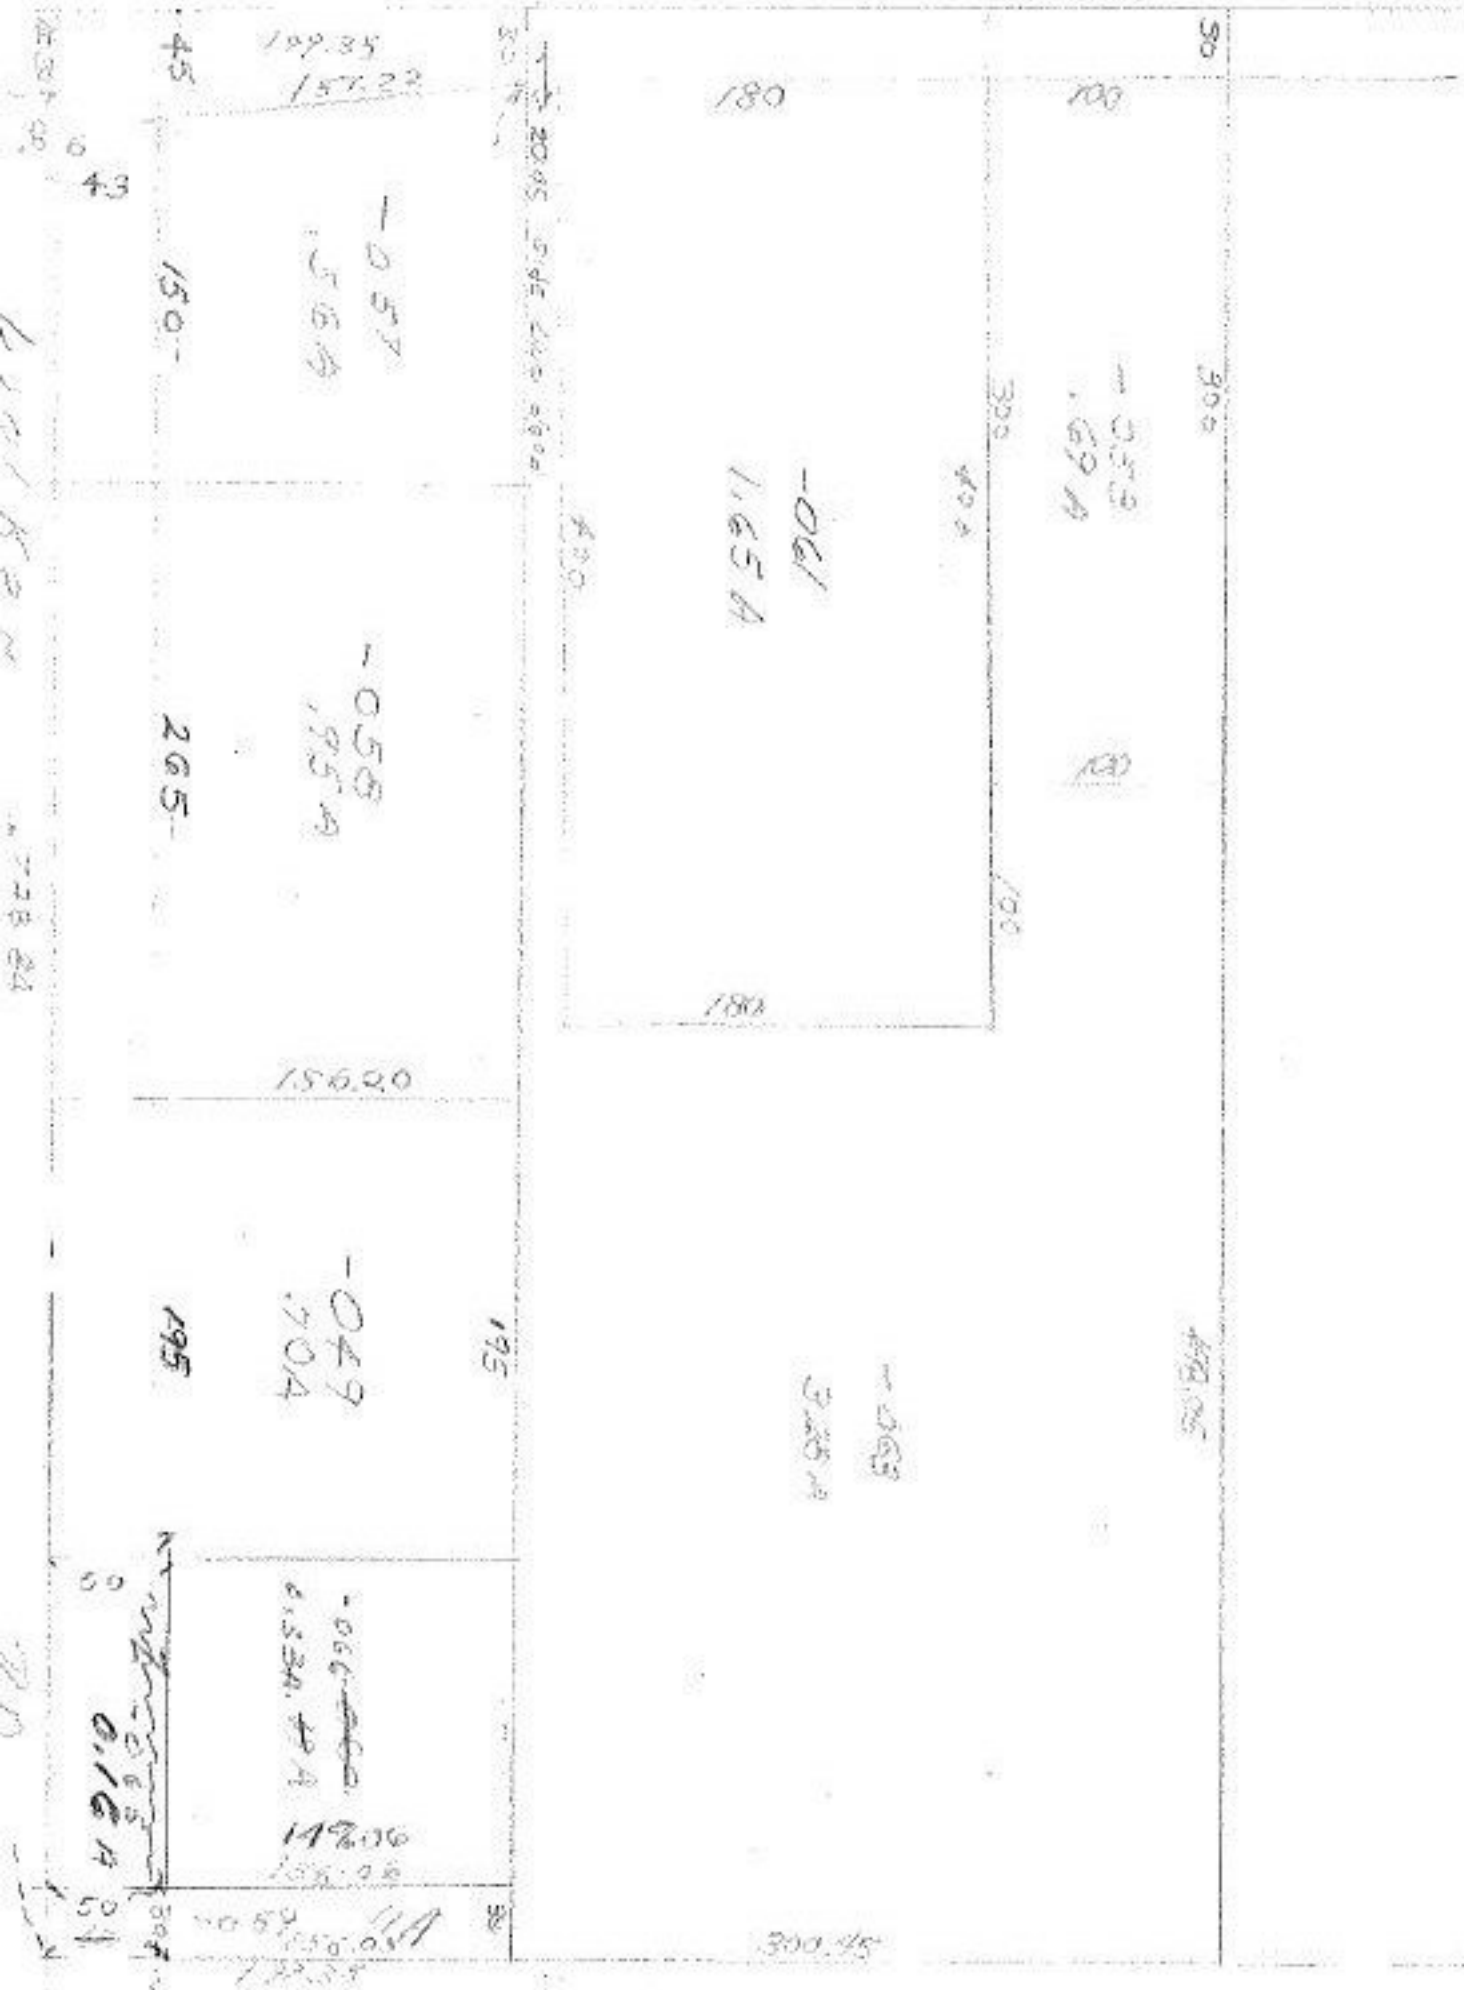

12266

7.2.79
T.M.

12-11-78
 12-11-78
 12-11-78
 12-11-78