


1000  
Bellingham  
4 10 100

- 096  
18,288 A  
- 097  
19,024 A

113

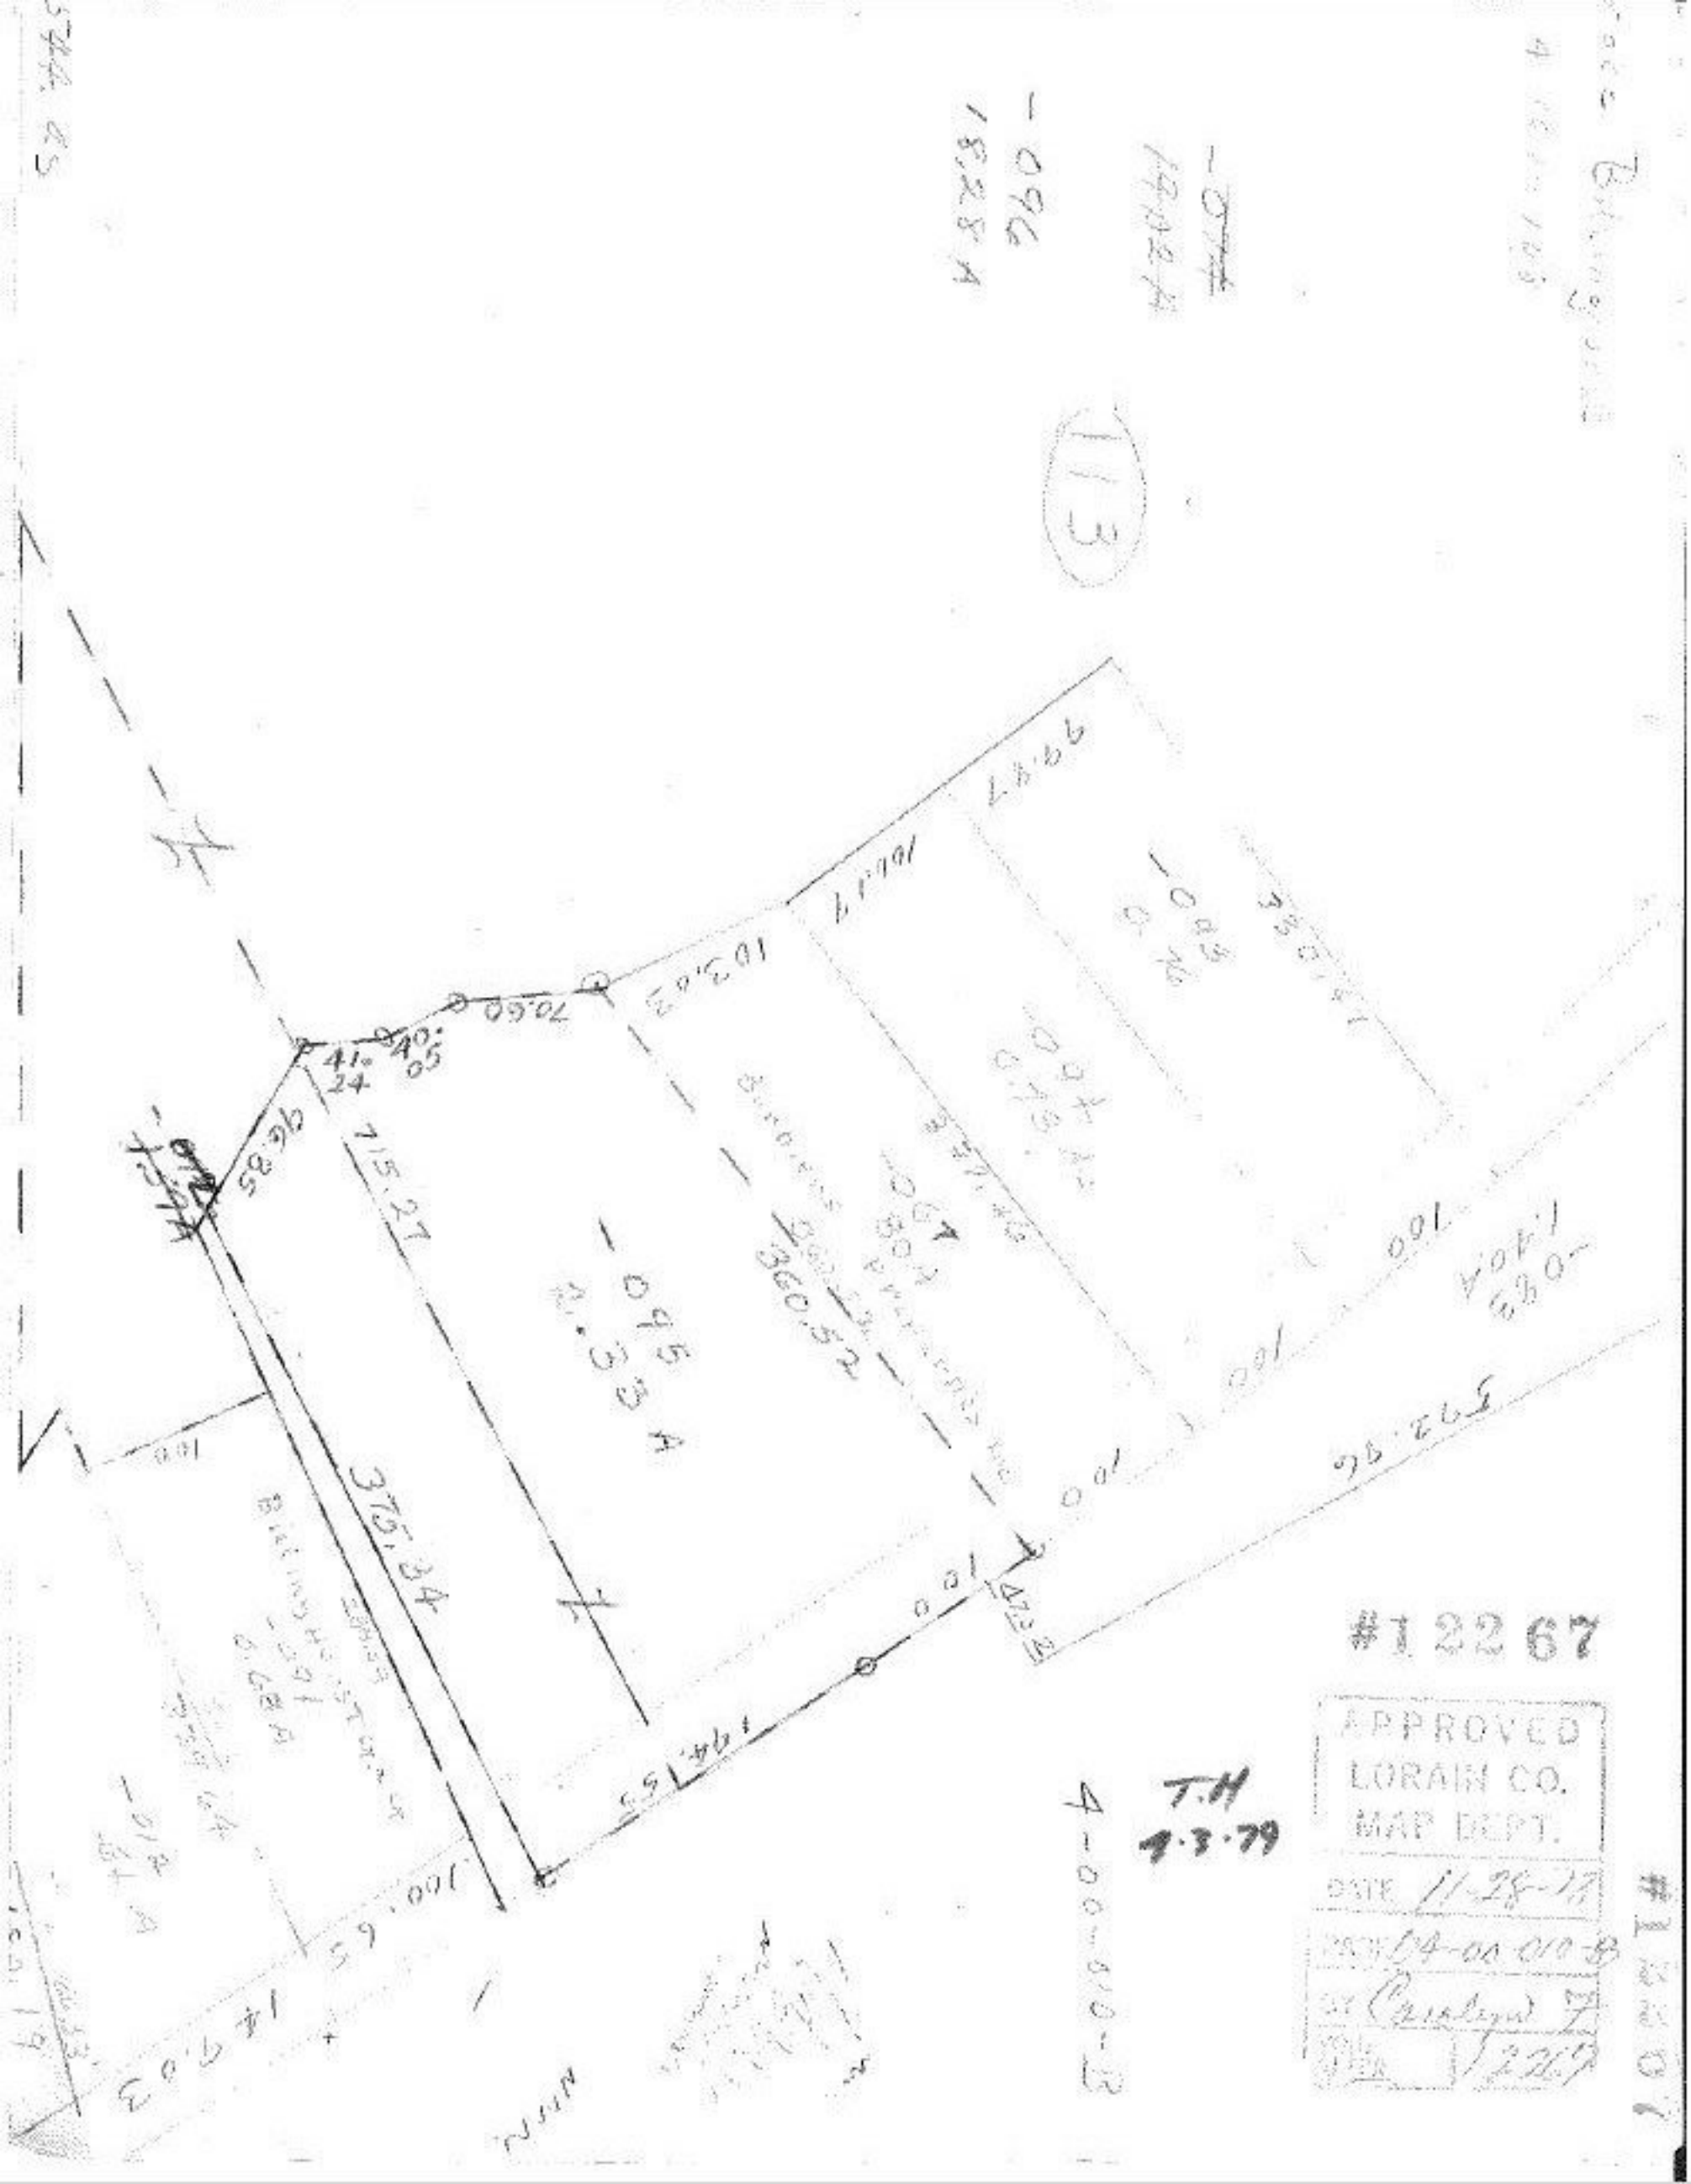

344.85

#12267

APPROVED  
LORAIN CO.  
MAP DEPT.  
DATE 11-28-78  
BY [Signature]  
12267

T.H.  
7.3.79  
4-00-810-13

#12267