


WAKEMAN-LAGRANGE-RICHFIELD

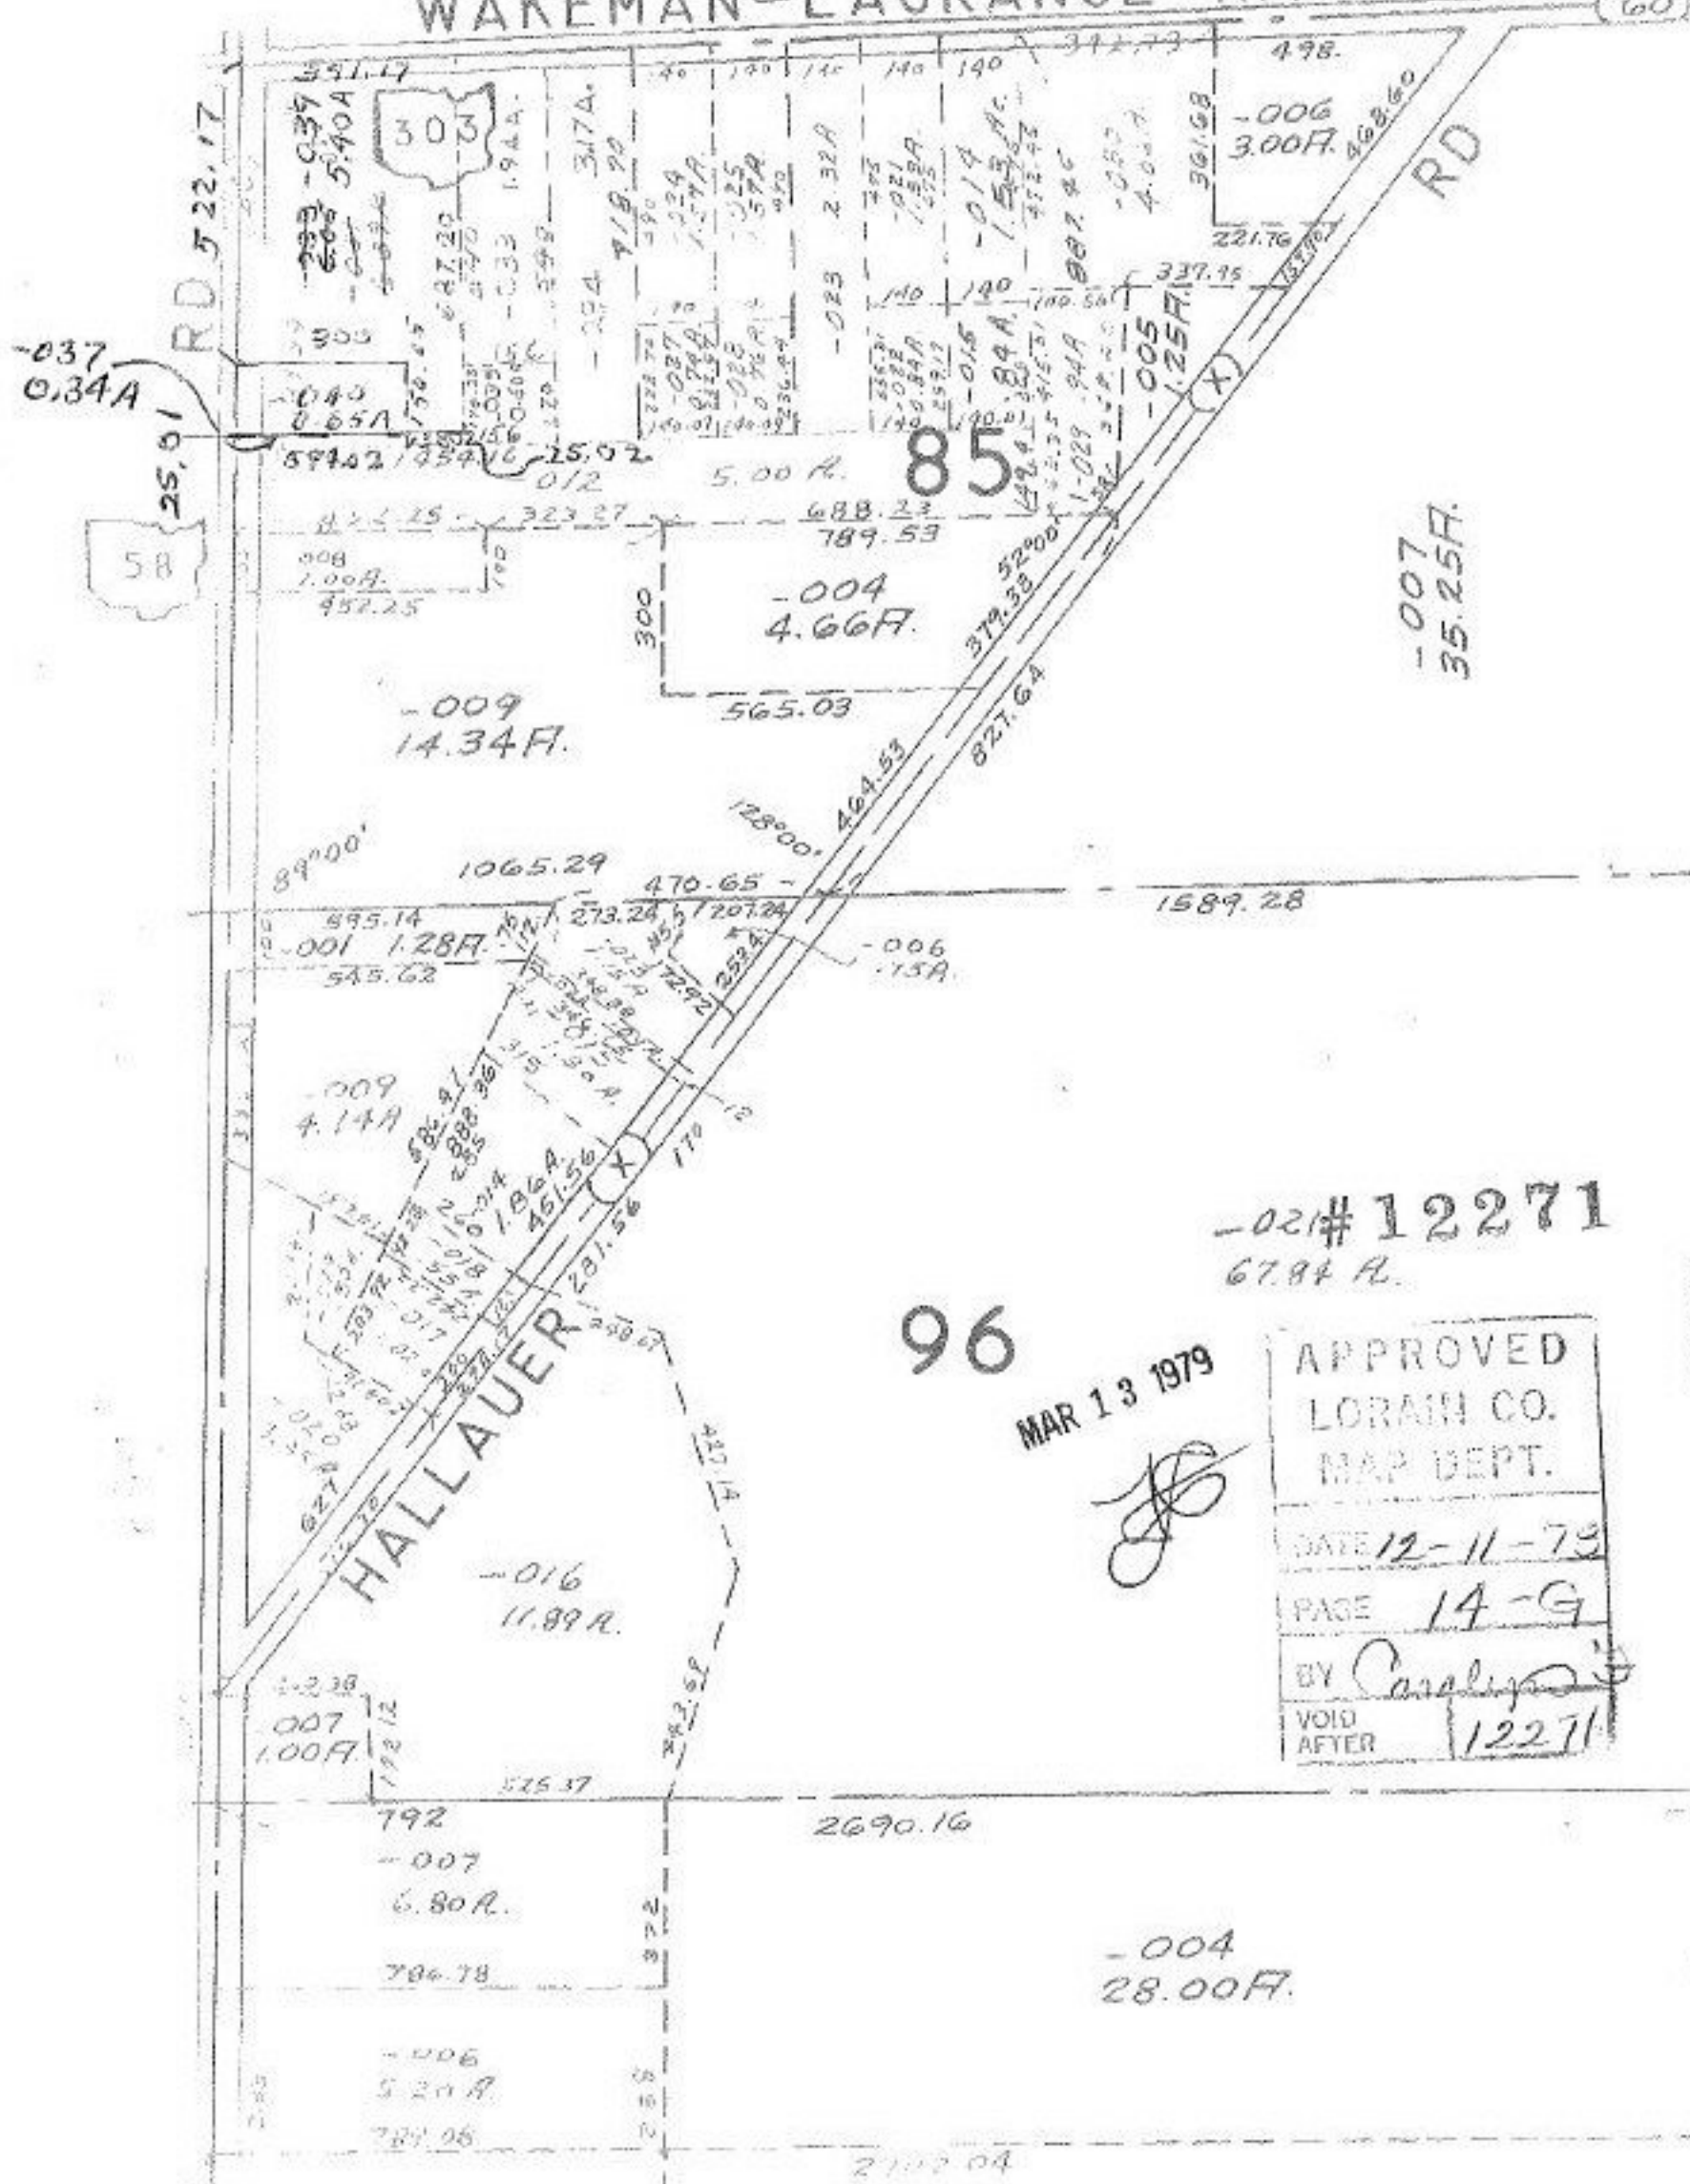

-021#12271
67.84 A.

96

MAR 13 1979

APPROVED
LORAIN CO.
MAP DEPT.
DATE 12-11-79
PAGE 14-G
BY Carolyn
VOID AFTER 12271

-004
28.00F.