


#12274

W.P.

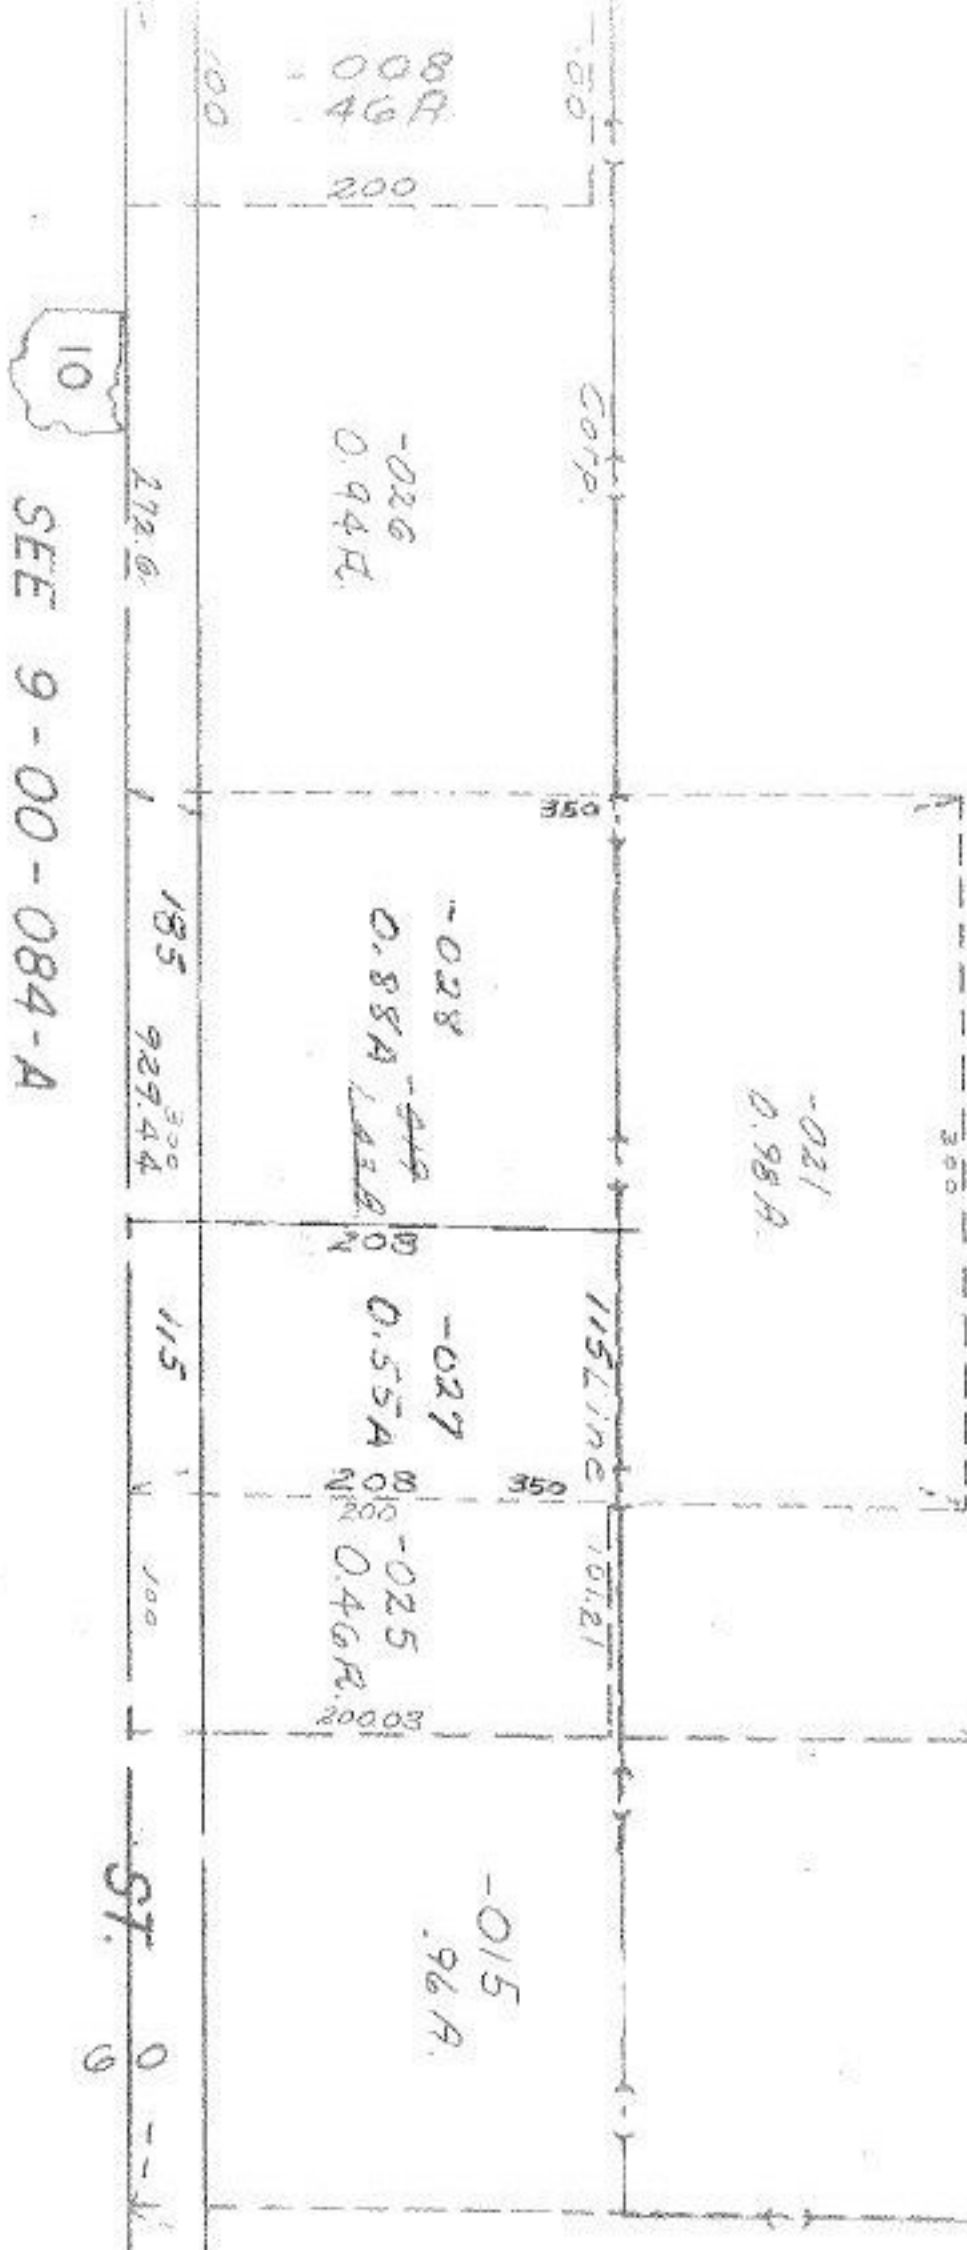

-023  
6.099A.

-021  
0.98A.

-016  
2.76A.

#12274

APPROVED LORAIN CO. MAP DEPT.	
DATE	11-28-78
PAGE	09-00-01
BY	Carolyn J.
VOID AFTER	12274

TM  
3-15-19