



12287

HELEN

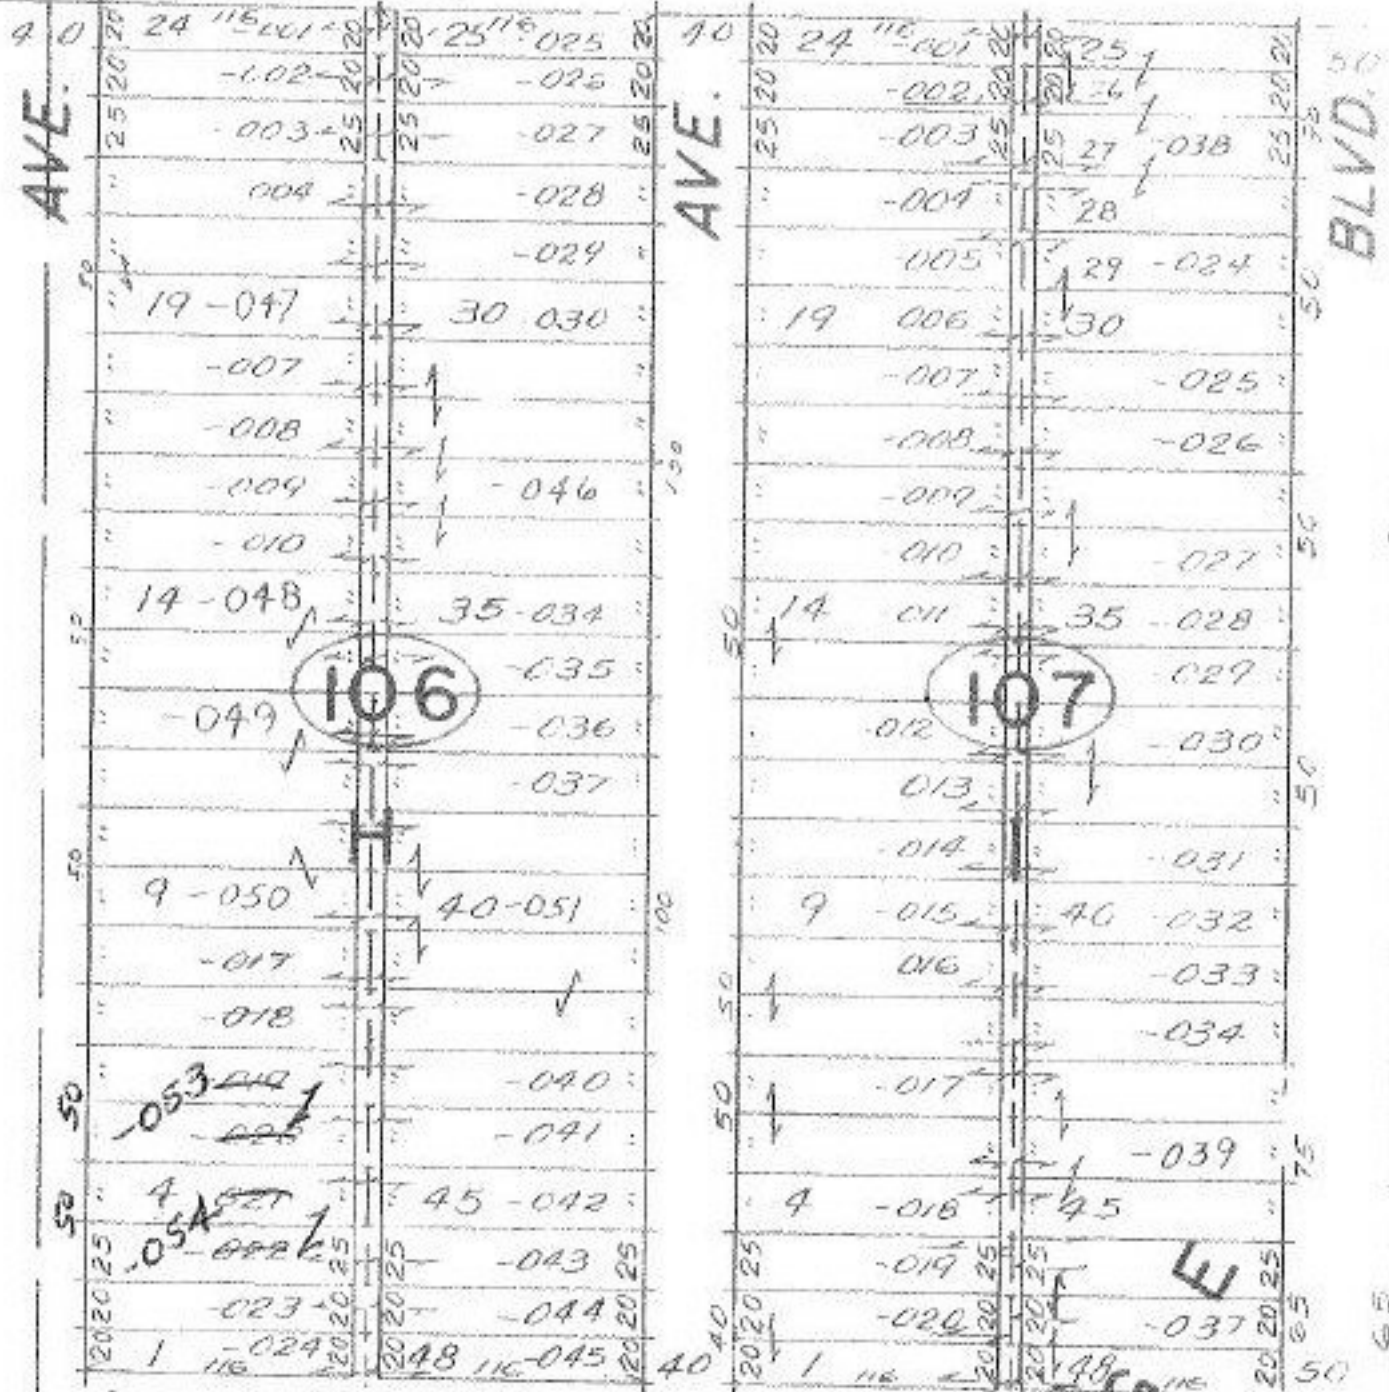

BERNICE

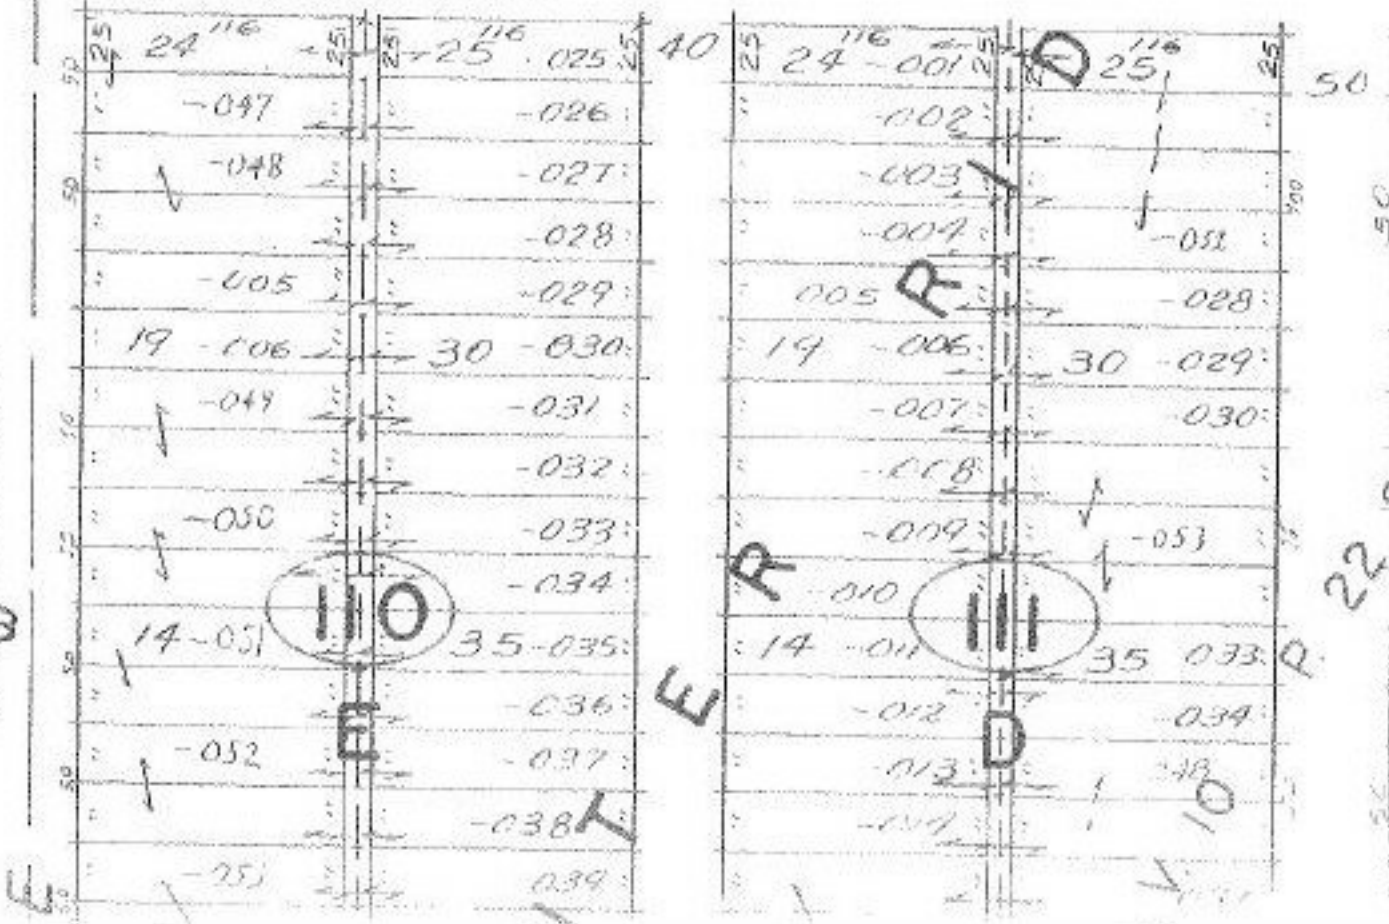

12287

APPROVED
MORRIS CO.
MAP DEPT.

DATE 3-5-79

PAGE 07-00-021-B

BY *[Signature]*

VOID
AFTER

T.M.
5-2-79