


10-00-009-F

330

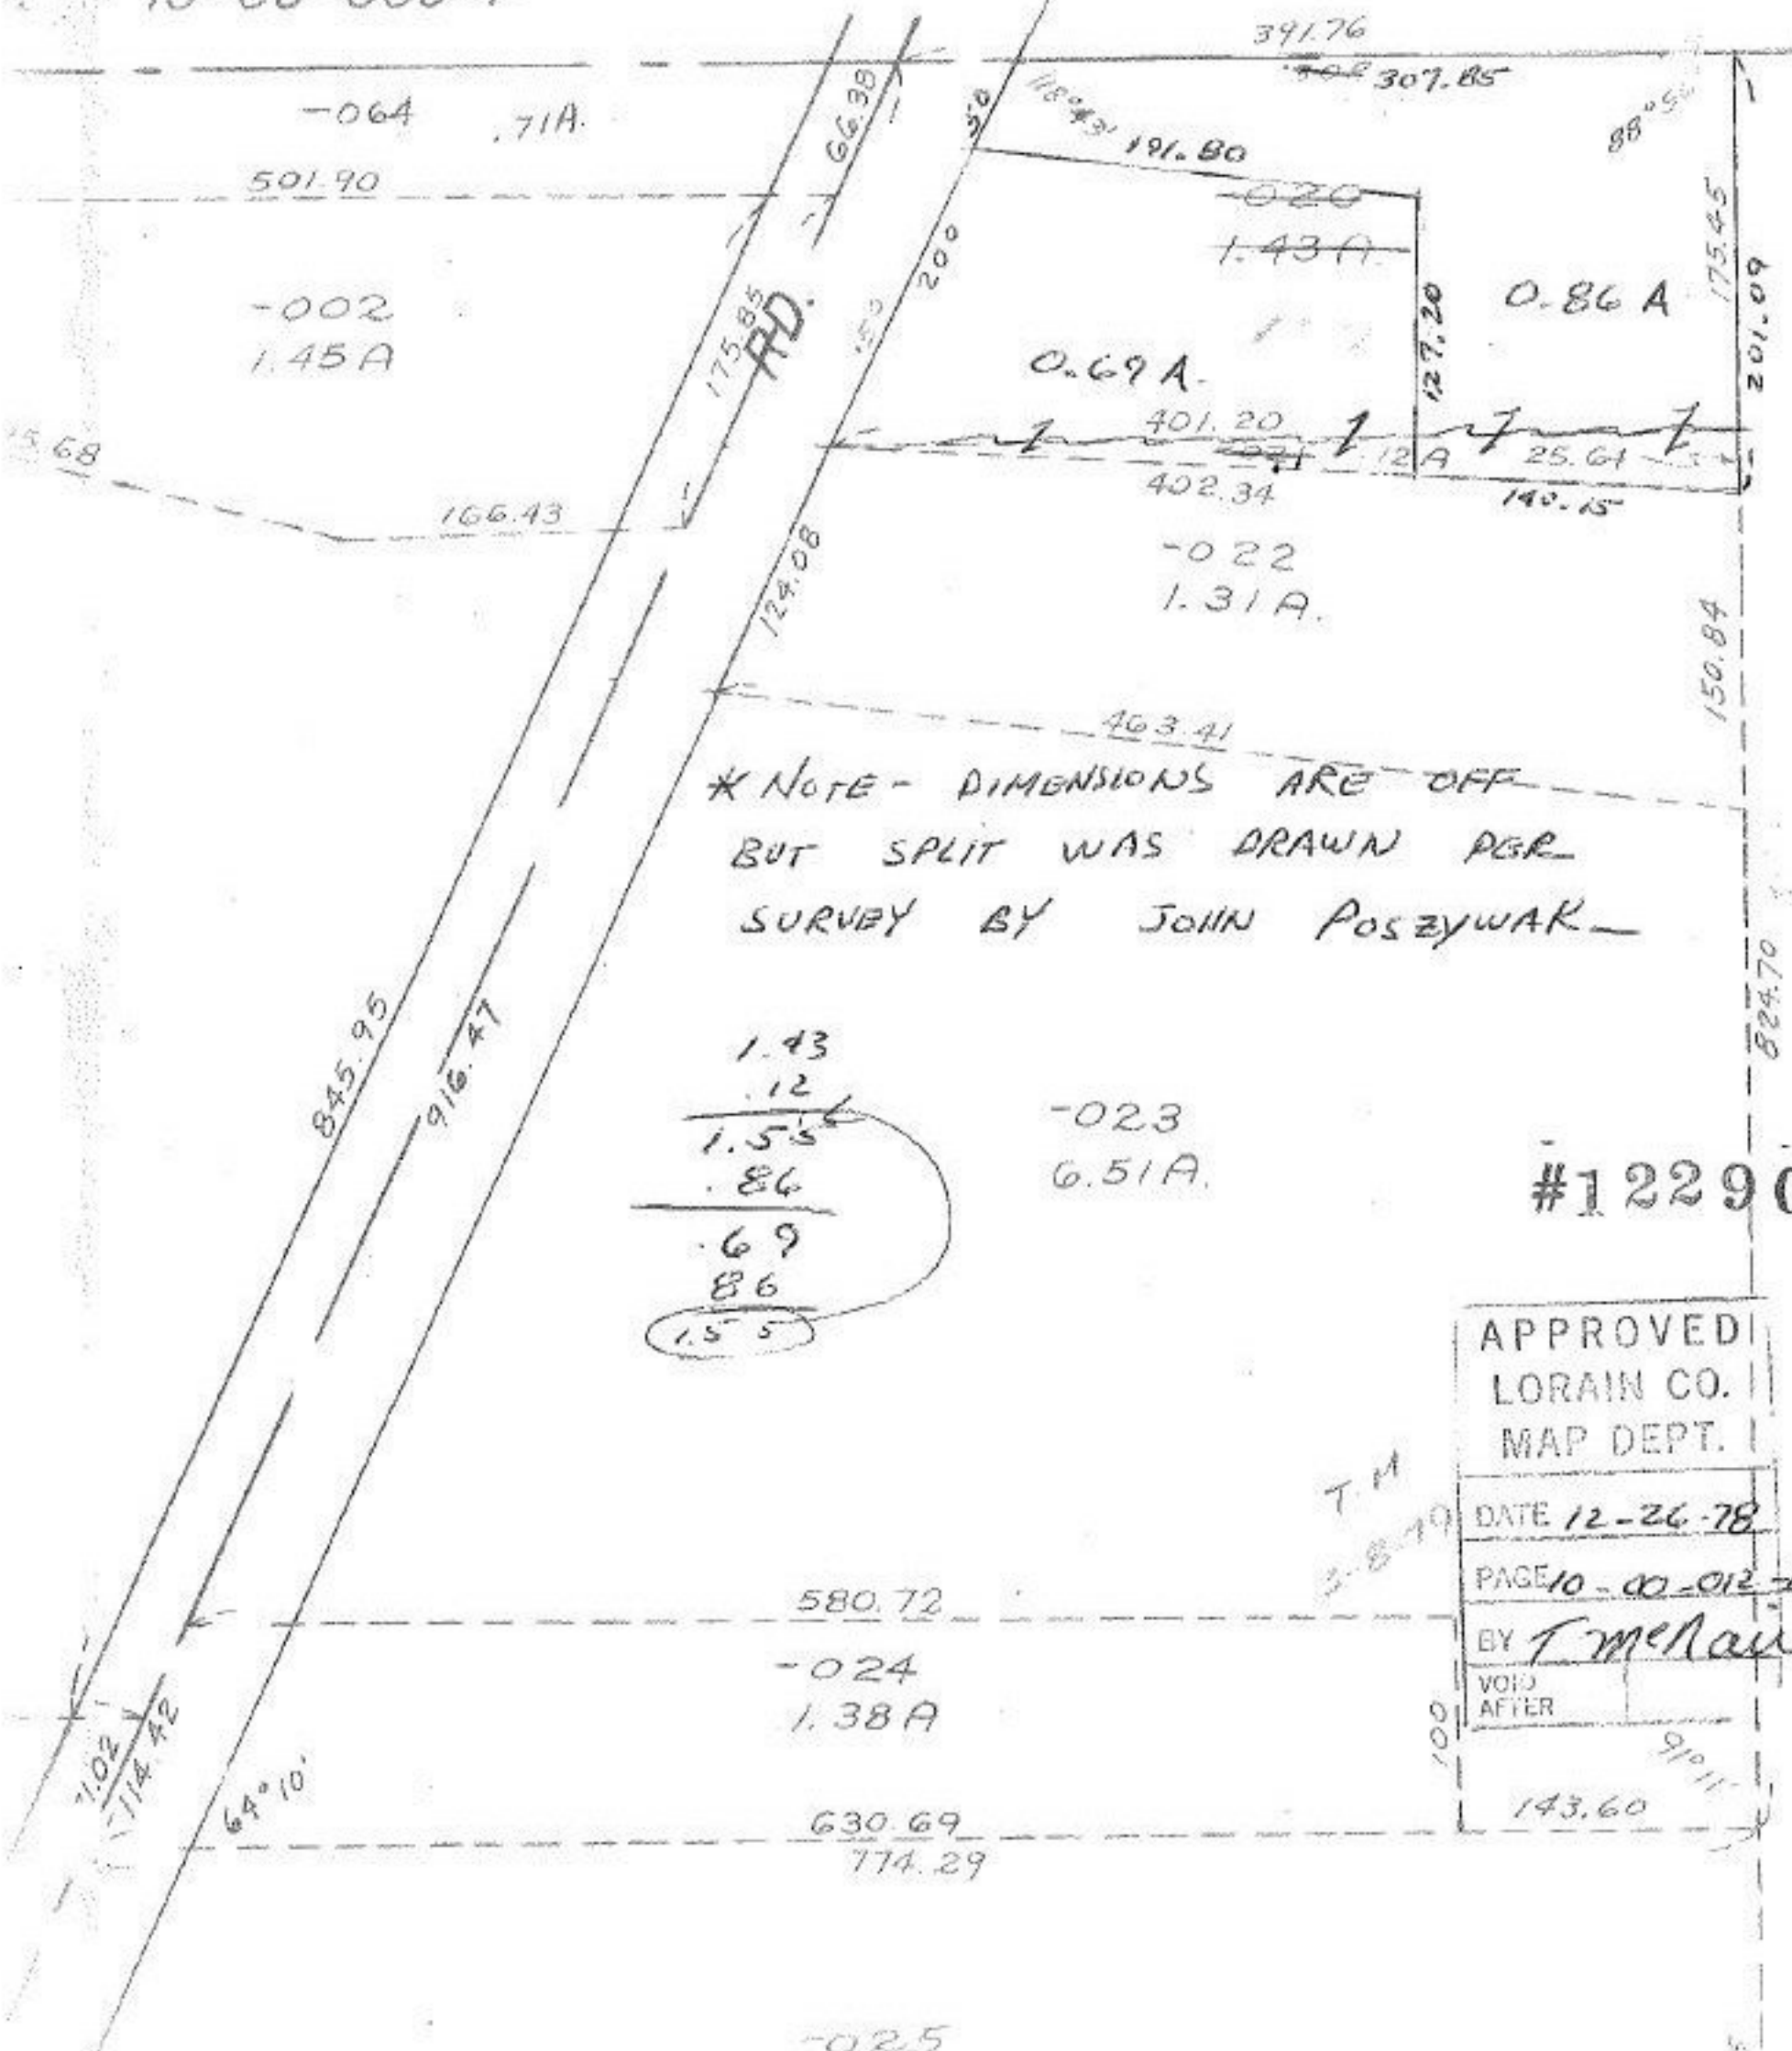

\*NOTE - DIMENSIONS ARE OFF  
 BUT SPLIT WAS DRAWN PER  
 SURVEY BY JOHN POSZYWAK -

1.43  
 .12  
 1.55  
 .86  
 .69  
 .86  
 1.55

-023  
 6.51A.

#12290

APPROVED  
 LORAIN CO.  
 MAP DEPT.  
 DATE 12-26-78  
 PAGE 10-00-012-B  
 BY T McLean  
 VOID AFTER  
 9/11  
 143.60

T.M.  
 3-8-79

-025