


#12293

11-00-008-500-  
11-00-008-500-007

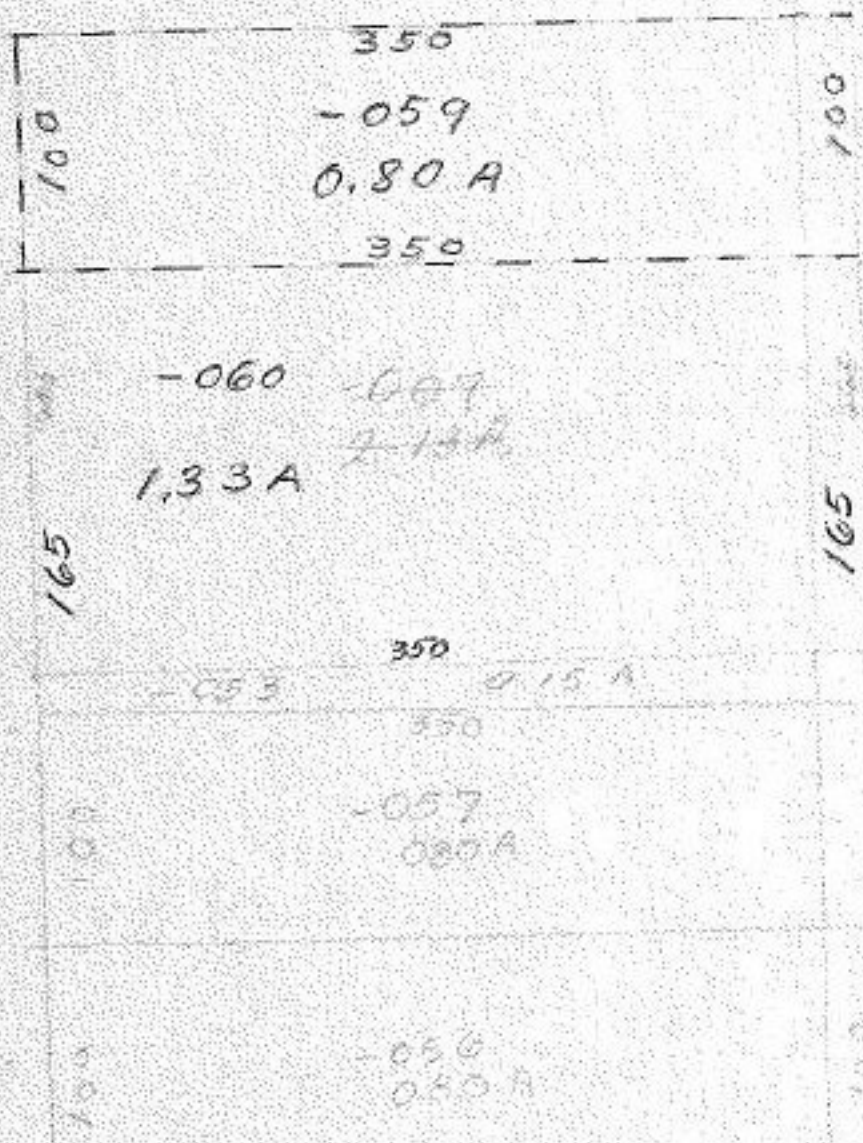

MAR 21 1979  
*[Signature]*

#12293  
 APPROVED  
 LORAIN CO.  
 MAP DEPT.  
 DATE 12-1-78  
 PAGE 11-00-008-B  
 BY *[Signature]*  
 VOID AFTER 12293