

SEE 6-27

#12312


372.50

100

TWP
CITY

345.51

150.05

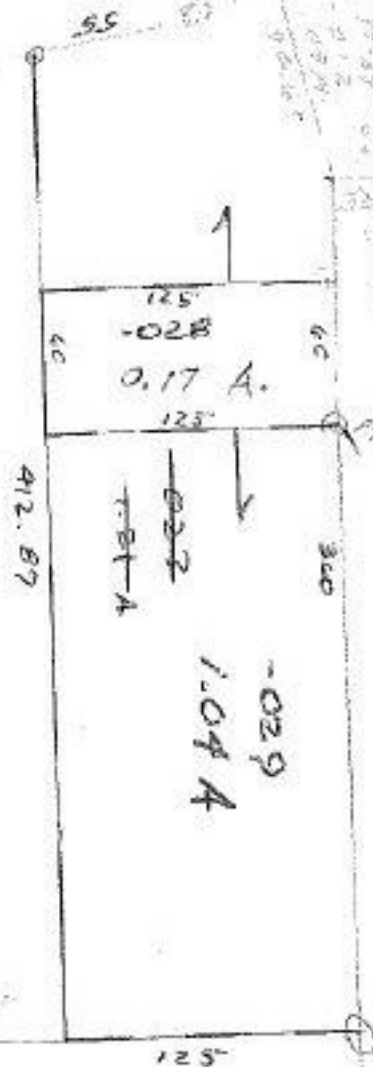

SCHADEN

#12312

APPROVED.	
LORAIN CO.	
MAP DEPT.	
DATE	12-7-78
PAGE	6-28
BY	T. McMan
VOID AFTER	

T.M.

MAY 7 1979

8116
-014
9.11A

510
513

105

13

743.09