
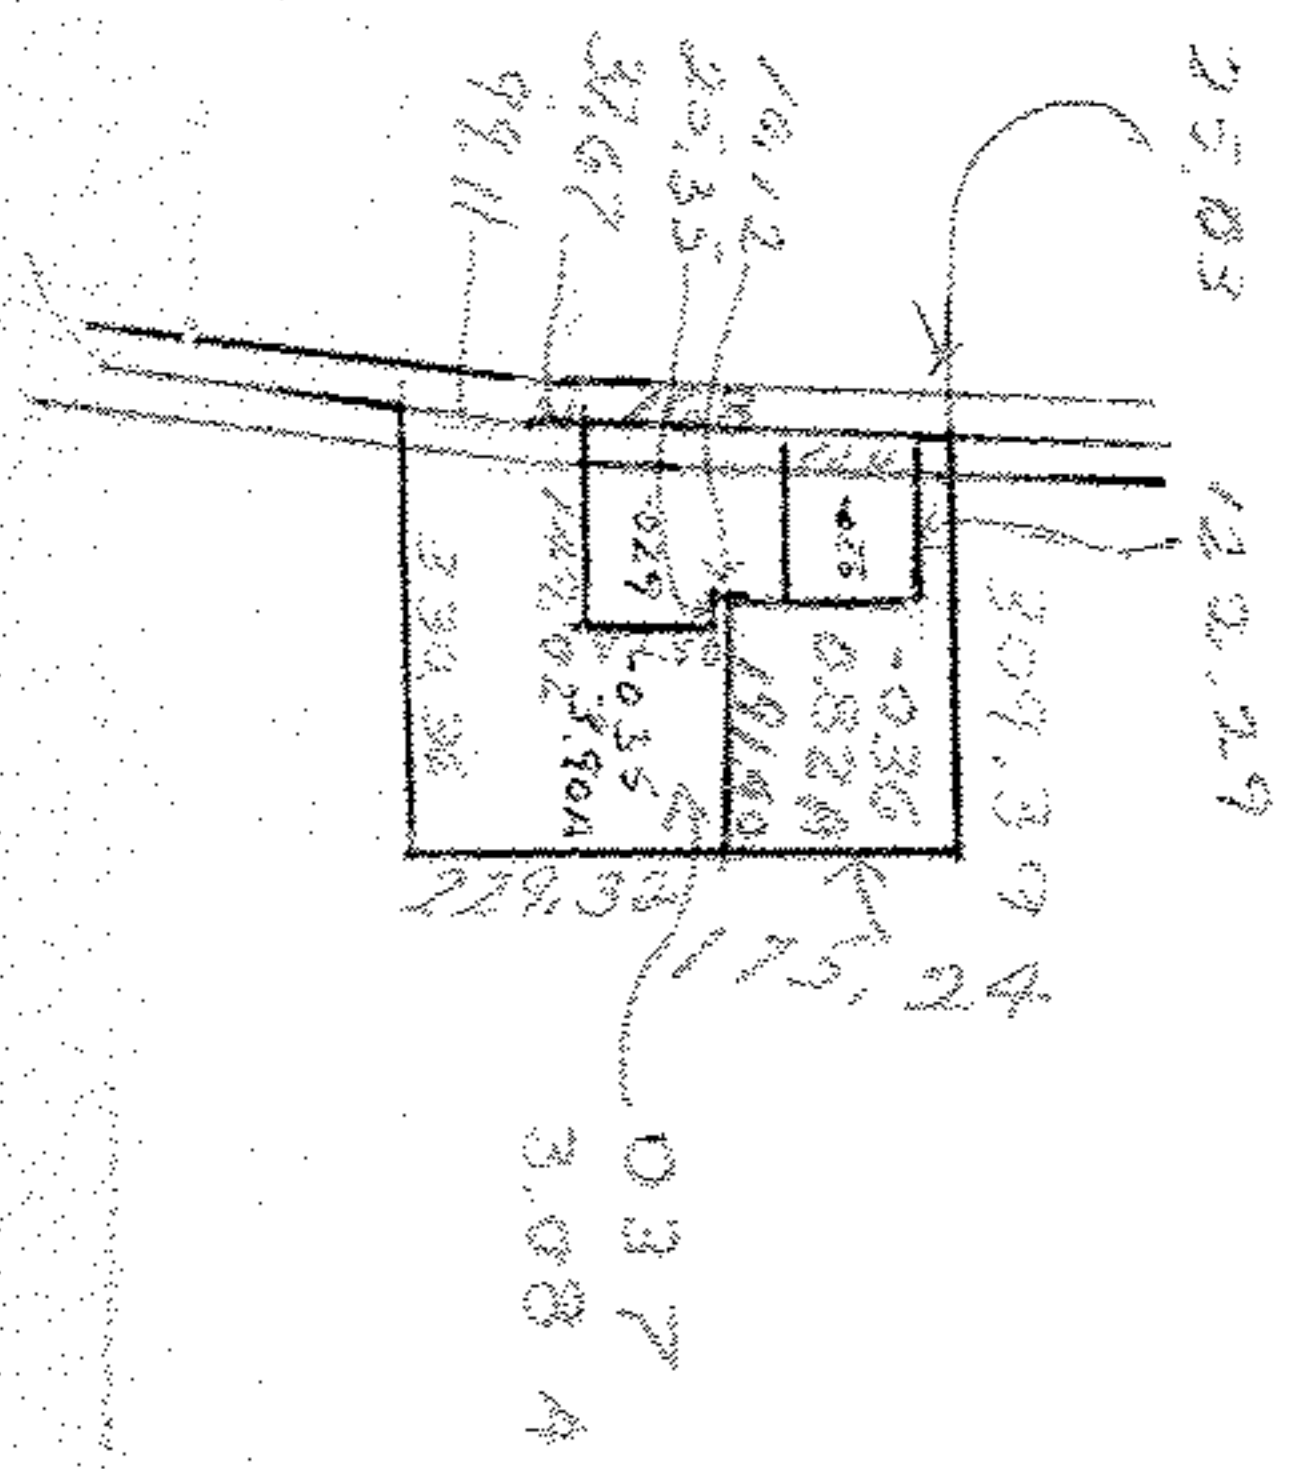


# 2316

CL. 11  
R/L (101)

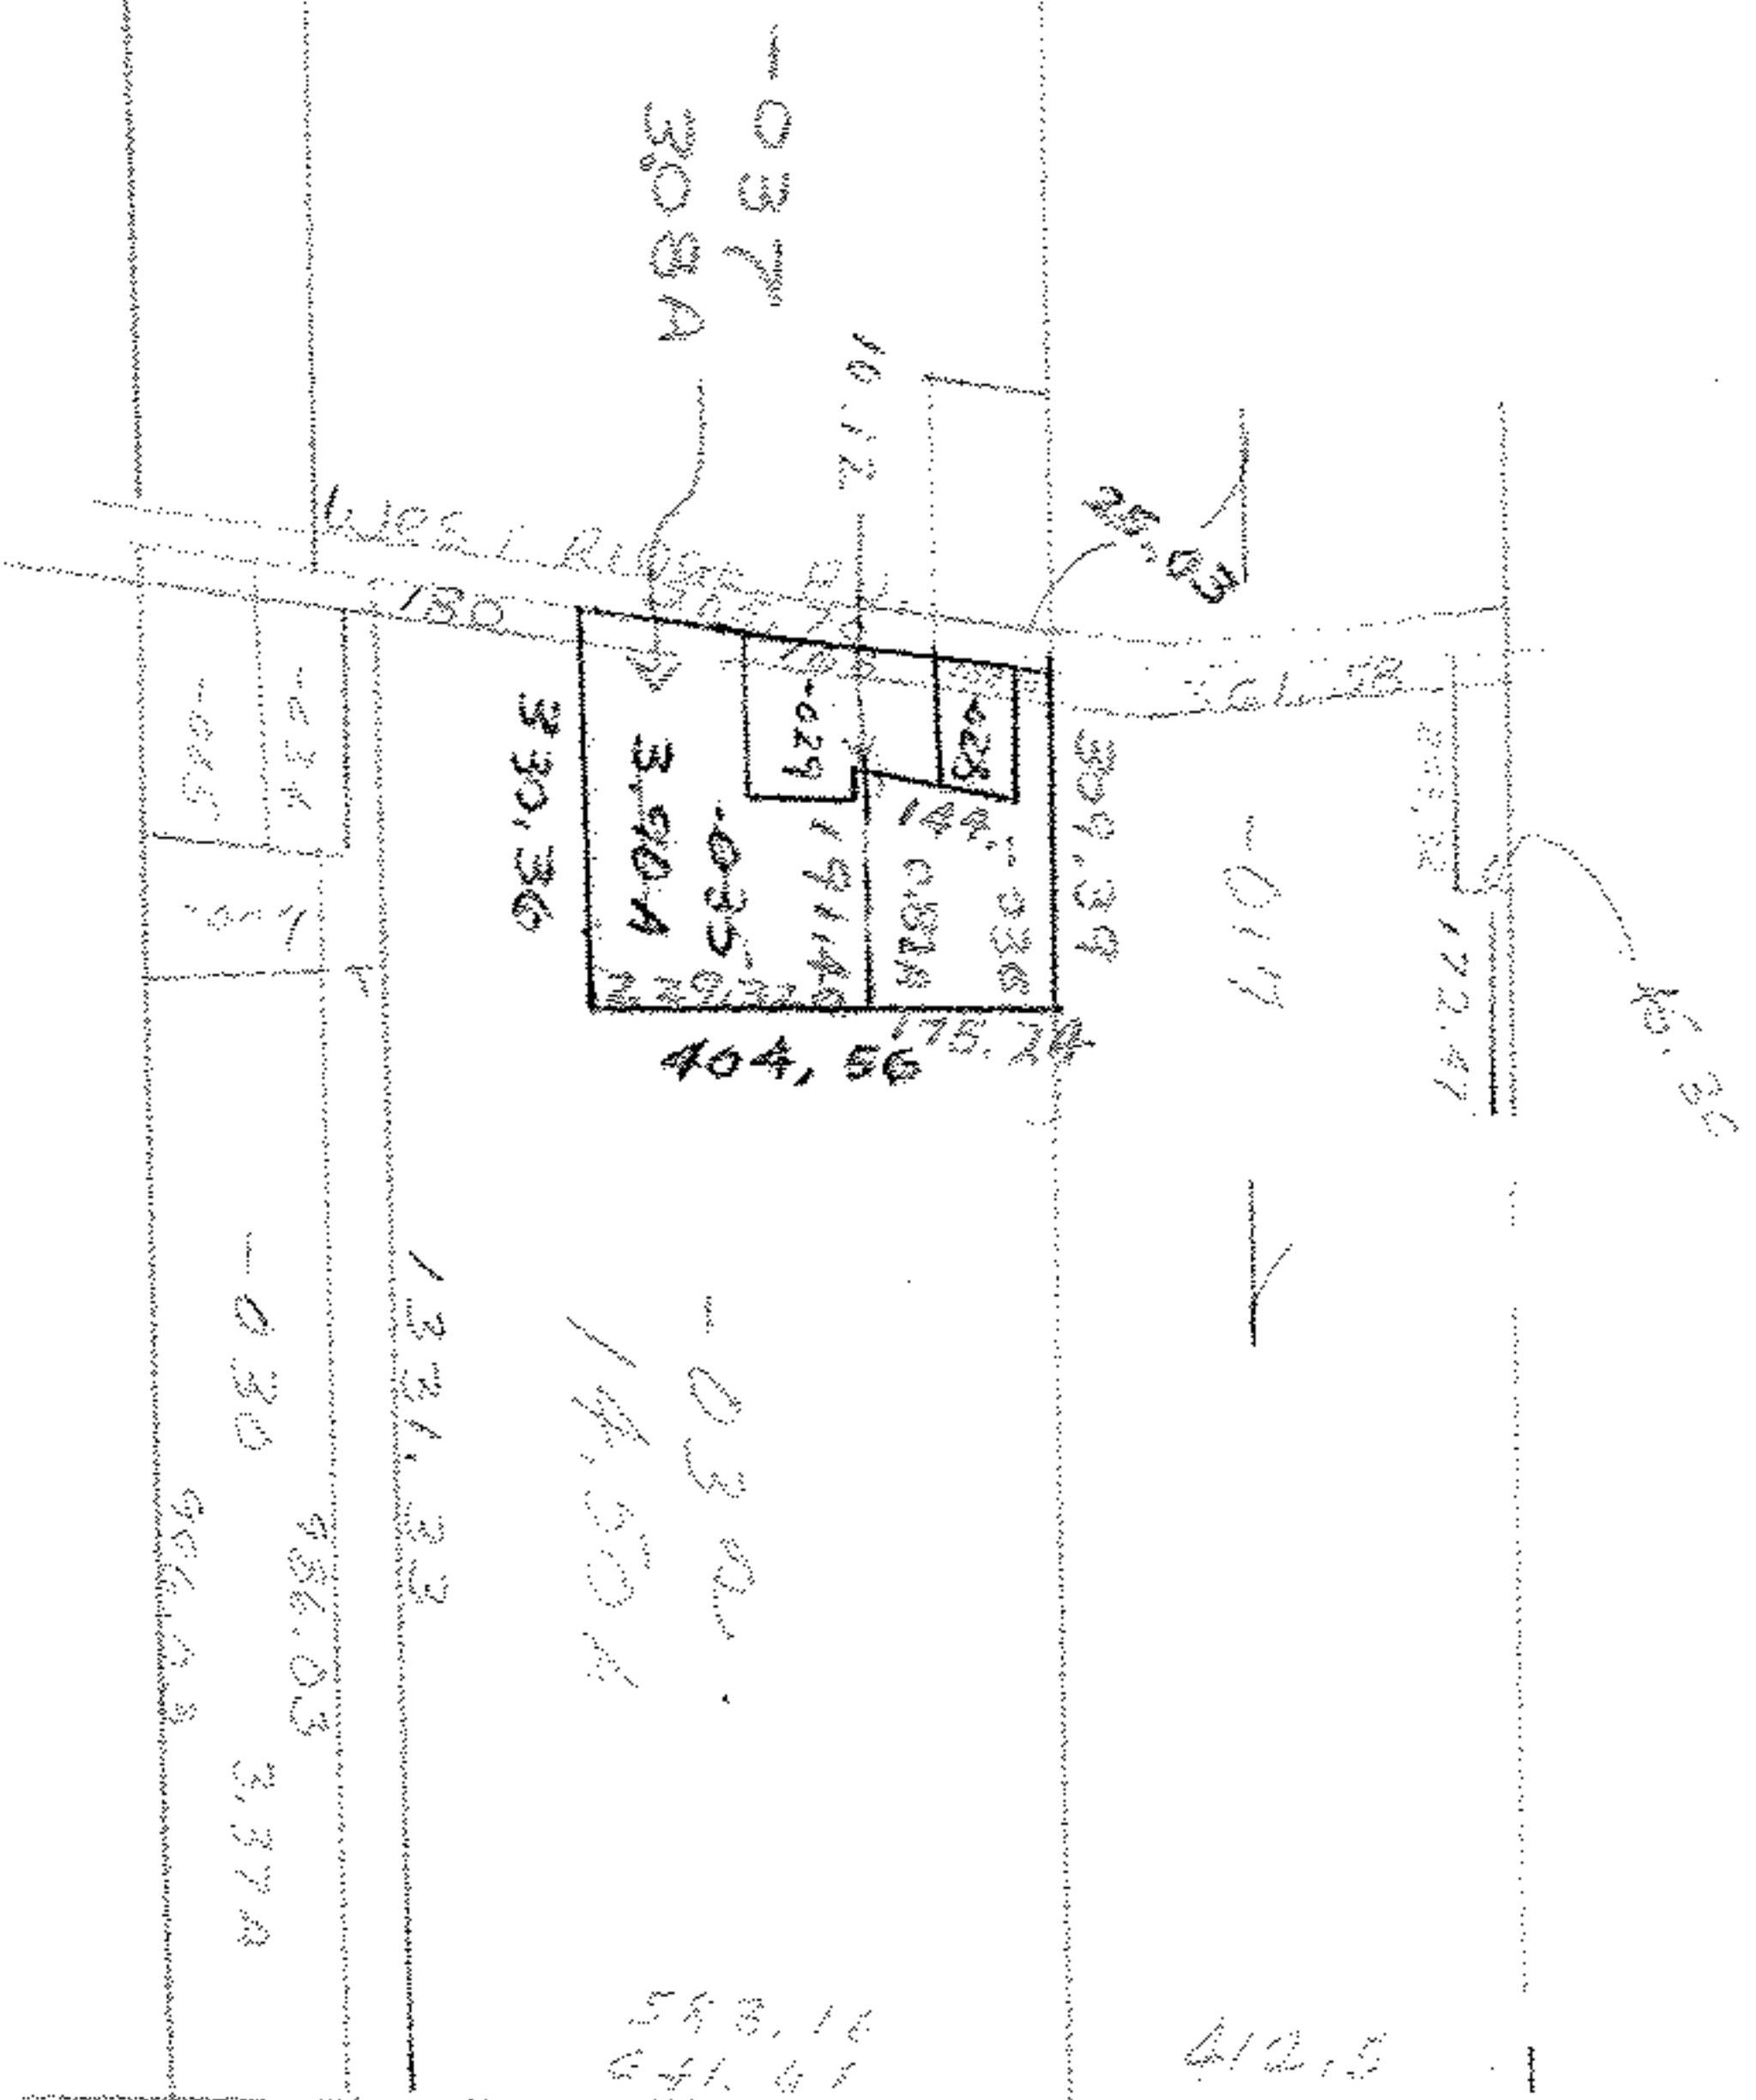

#12316

APPROVED  
LORAIN CO.  
MAP DEPT.

DATE 12-7-78

PAGE 10-A

BY *Carolyne*

VOID AFTER 12316

NR 4-24-79